


REVISION, APRIL 21, 1932.
 Culvert at 405+35 - Flow Line of Outlet Lowered, and an extension of 30 feet of 18" C.C.P., dituminous Coated, to be Constructed.

Parcel	Kind of Title	Date of Instrument	Grantor	Grantee	Recorded	Remarks
A	Q.C.D.	9-27-32	C.A. Tomlinson	5140	35-77	9-21-32
401	Q.C.D.	9-2-32	John LaTouche	5140	35-77	9-21-32
402	Q.C.D.	9-2-32	K.K. Grant Moody	5140	35-77	9-21-32
403	Q.C.D.	9-2-32	S.A. Stowell	5140	35-77	9-21-32
404	Q.C.D.	9-2-32	Mrs. L. Robinson	5140	35-77	9-21-32

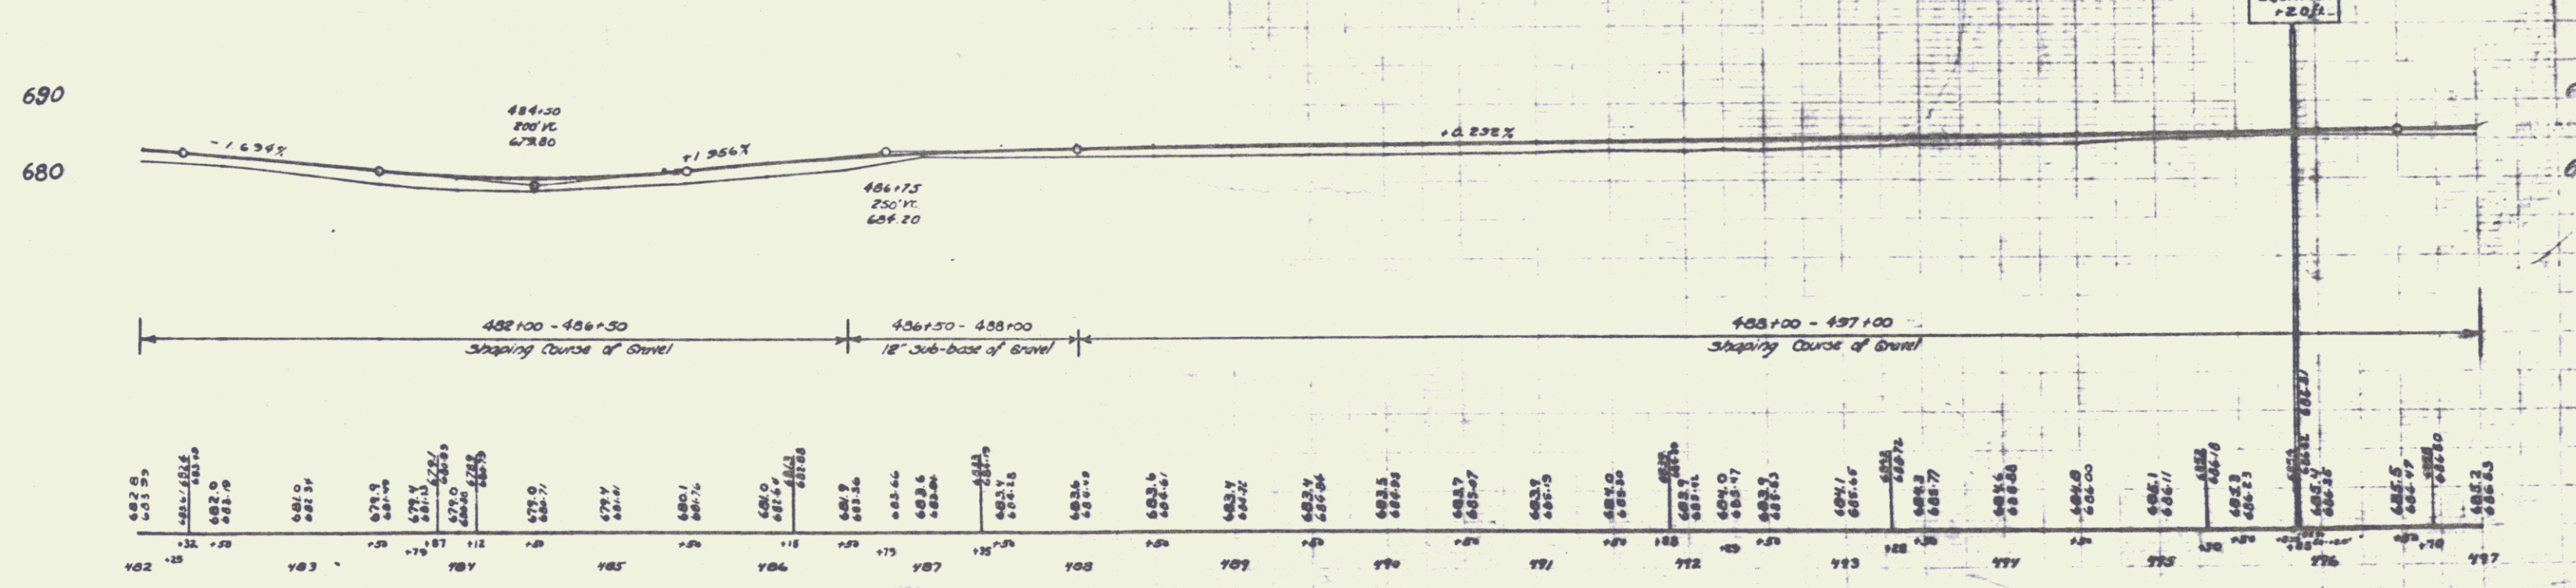

B.M. 65 -- SPIKE IN ROOT 30' ELM - 26' RT. STA. 402+55 -- EL. 603.32
 16" MARI-10' RT. STA. 404+85 -- EL. 604.23