


Note  
 Sta 505+00 - 512+00 Road encountered in  
 Excavation to be used in fill Sta 550+57+00

POOR ORIGINAL COPY

Parcel	Kind of Instrument	Date of Instrument	Creator	Order	Recorded State	Remarks
A	G.C.D.	12-30-32	Stewart Inc.	1st	30 78	12-30-32
A'	G.C.D.	12-30-32	M.H. & A. Shacker	"	30 78	12-30-32

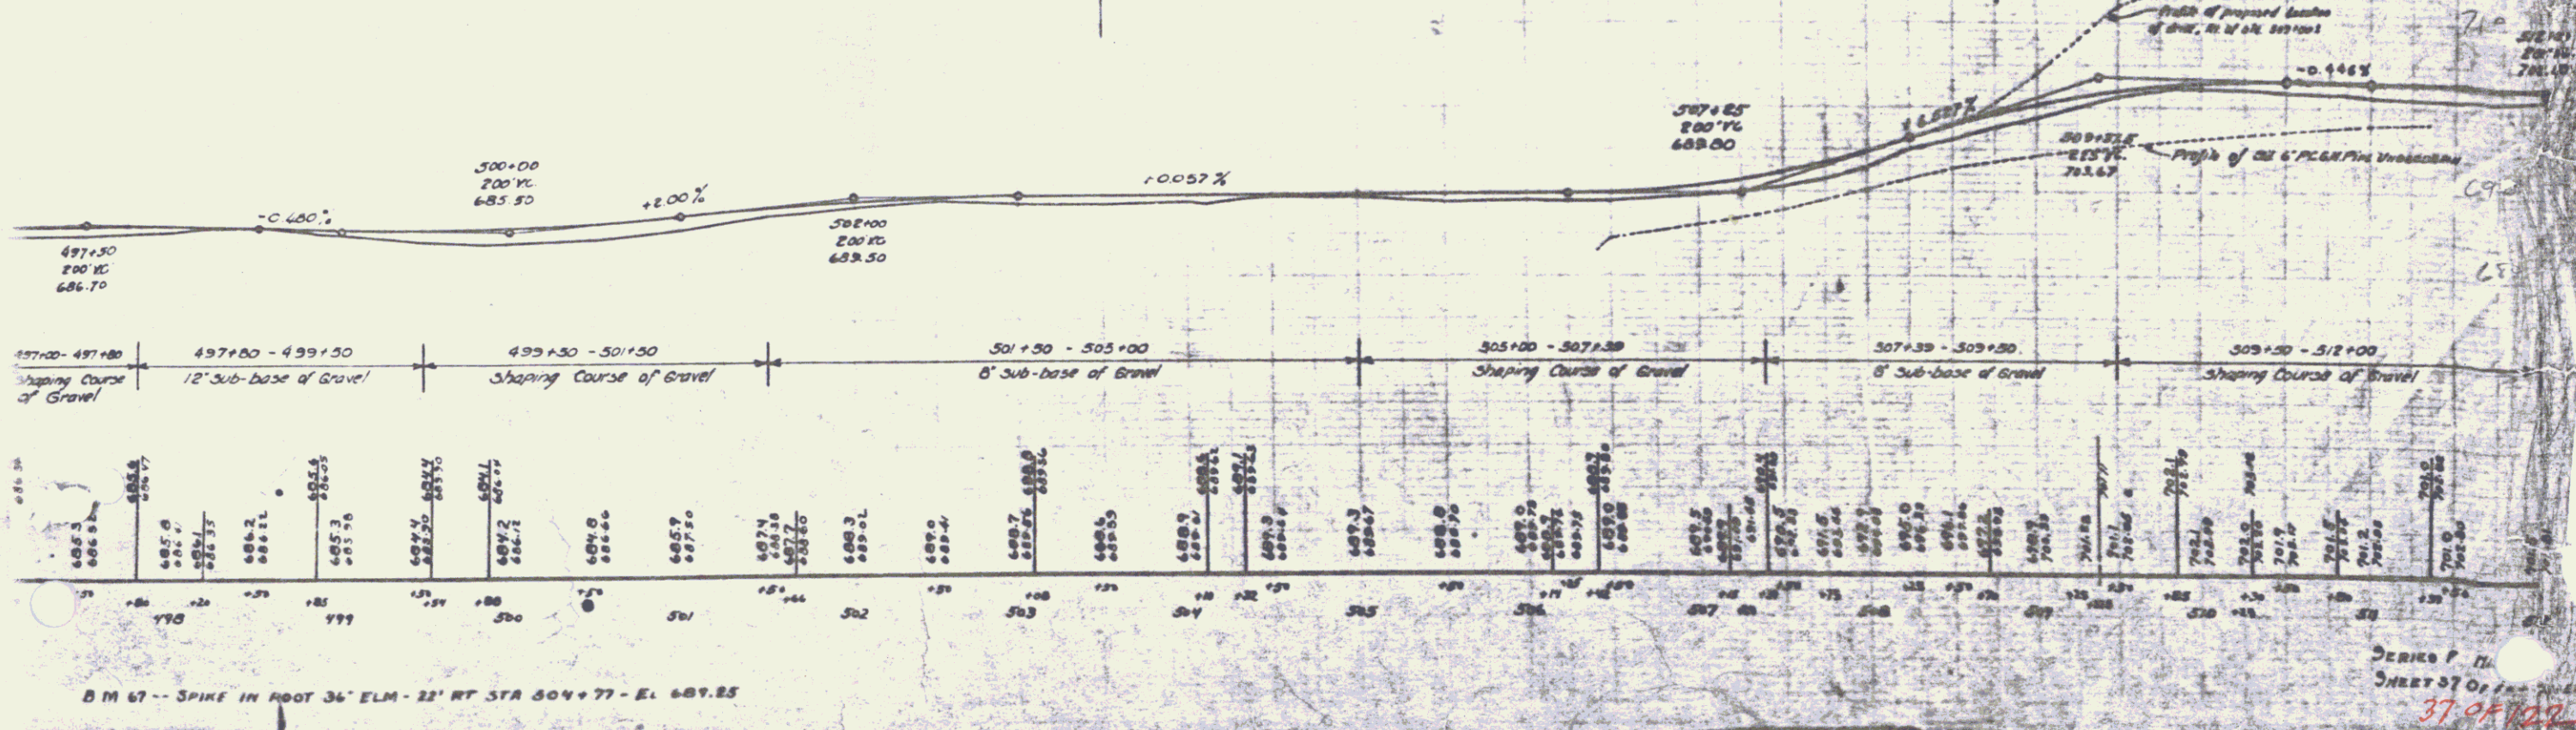

B M 67 - SPIKE IN FOOT 36' ELM - 22' RT STA 504+77 - EL. 689.25

DERIKO P. H.  
 SURVEYOR  
 37-9-1932