


Handwritten notes:
 1-7-18'11
 0-60
 E-14327
 T-916
 L-182.5
 E-3.0

Stamp:
 SHEET 4 OF 36
 01R126

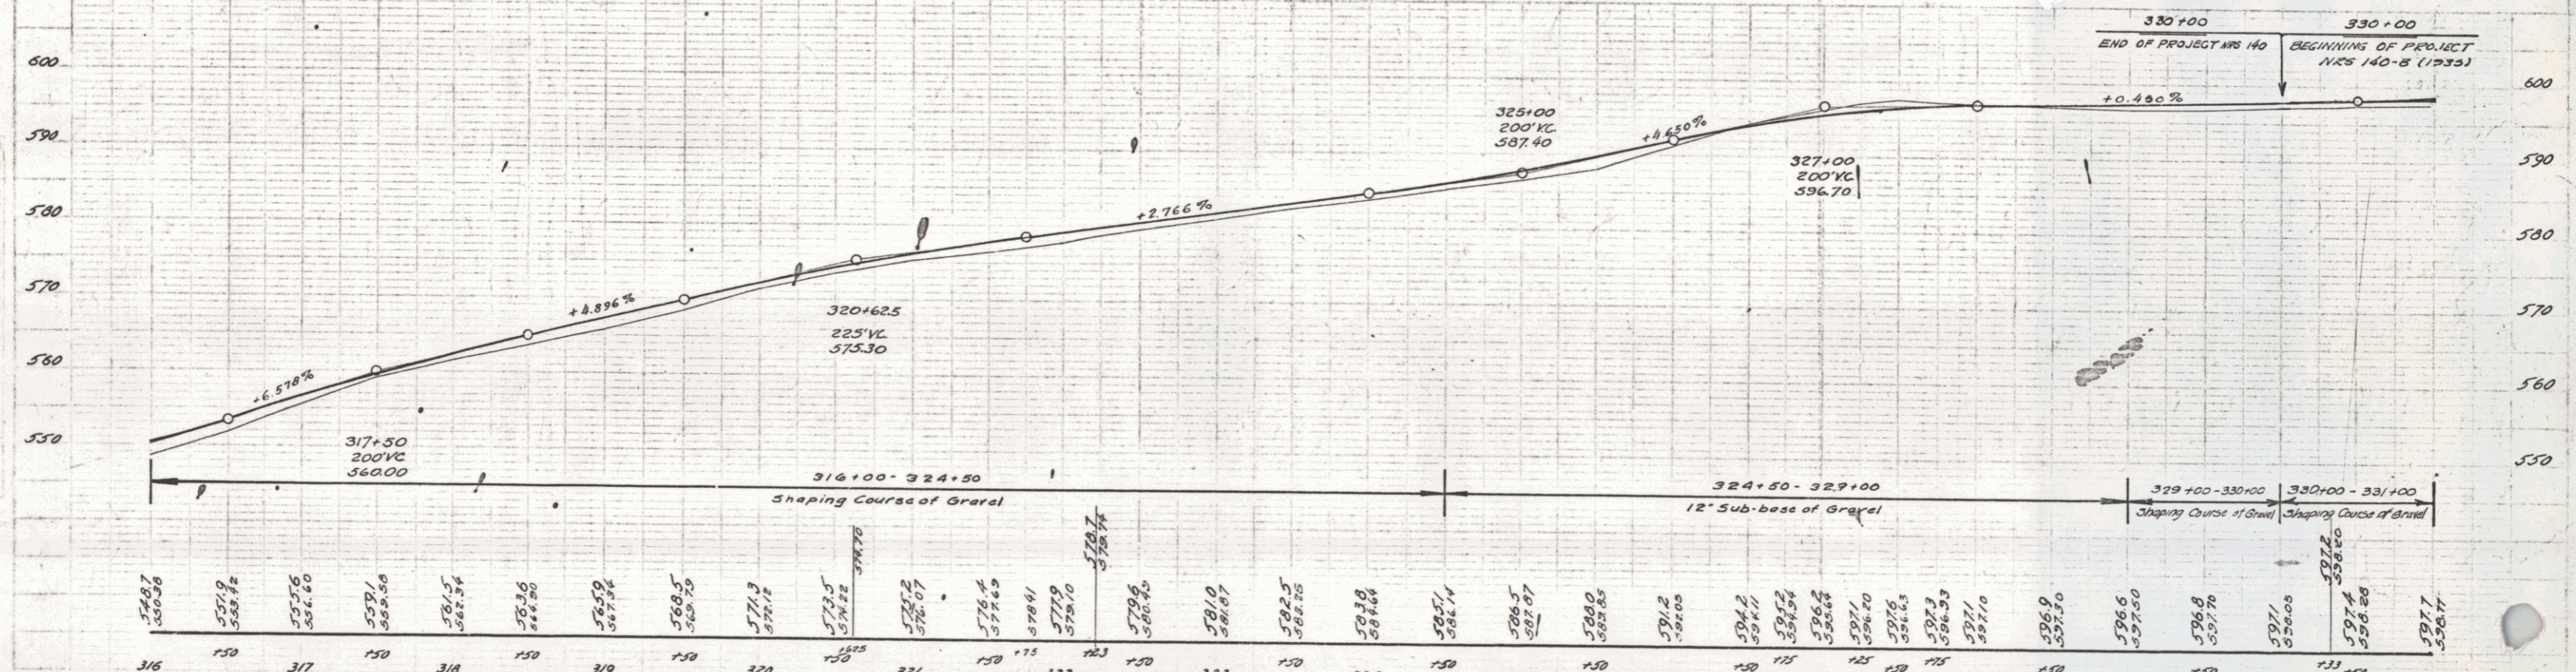

316 150 317 150 318 150 319 150 320 150 321 150 322 150 323 150 324 150 325 150 326 150 327 150 328 150 329 150 330 150 331

B.M. # 46 spike in root of 18' elm 275ft. N. of Sta. 319+59 Elev. 564.61
 B.M. # 47 spike in root of 8' maple 25 ft. N. of Sta. 324+10 Elev. 583.10
 B.M. # 48 point spot on ledge 33ft. N. of Sta. 329+15 Elev. 601.74