

PLAN

DATE: 10/15/09

BY: [Signature]

SCALE: 1" = 40'

NOTE: BOOK & MAPS CHECKED.

NO.:

PROFILE


DATE: 10/15/09

BY: [Signature]

SCALE: 1" = 40'

NOTE: BOOK & MAPS CHECKED.

NO.:

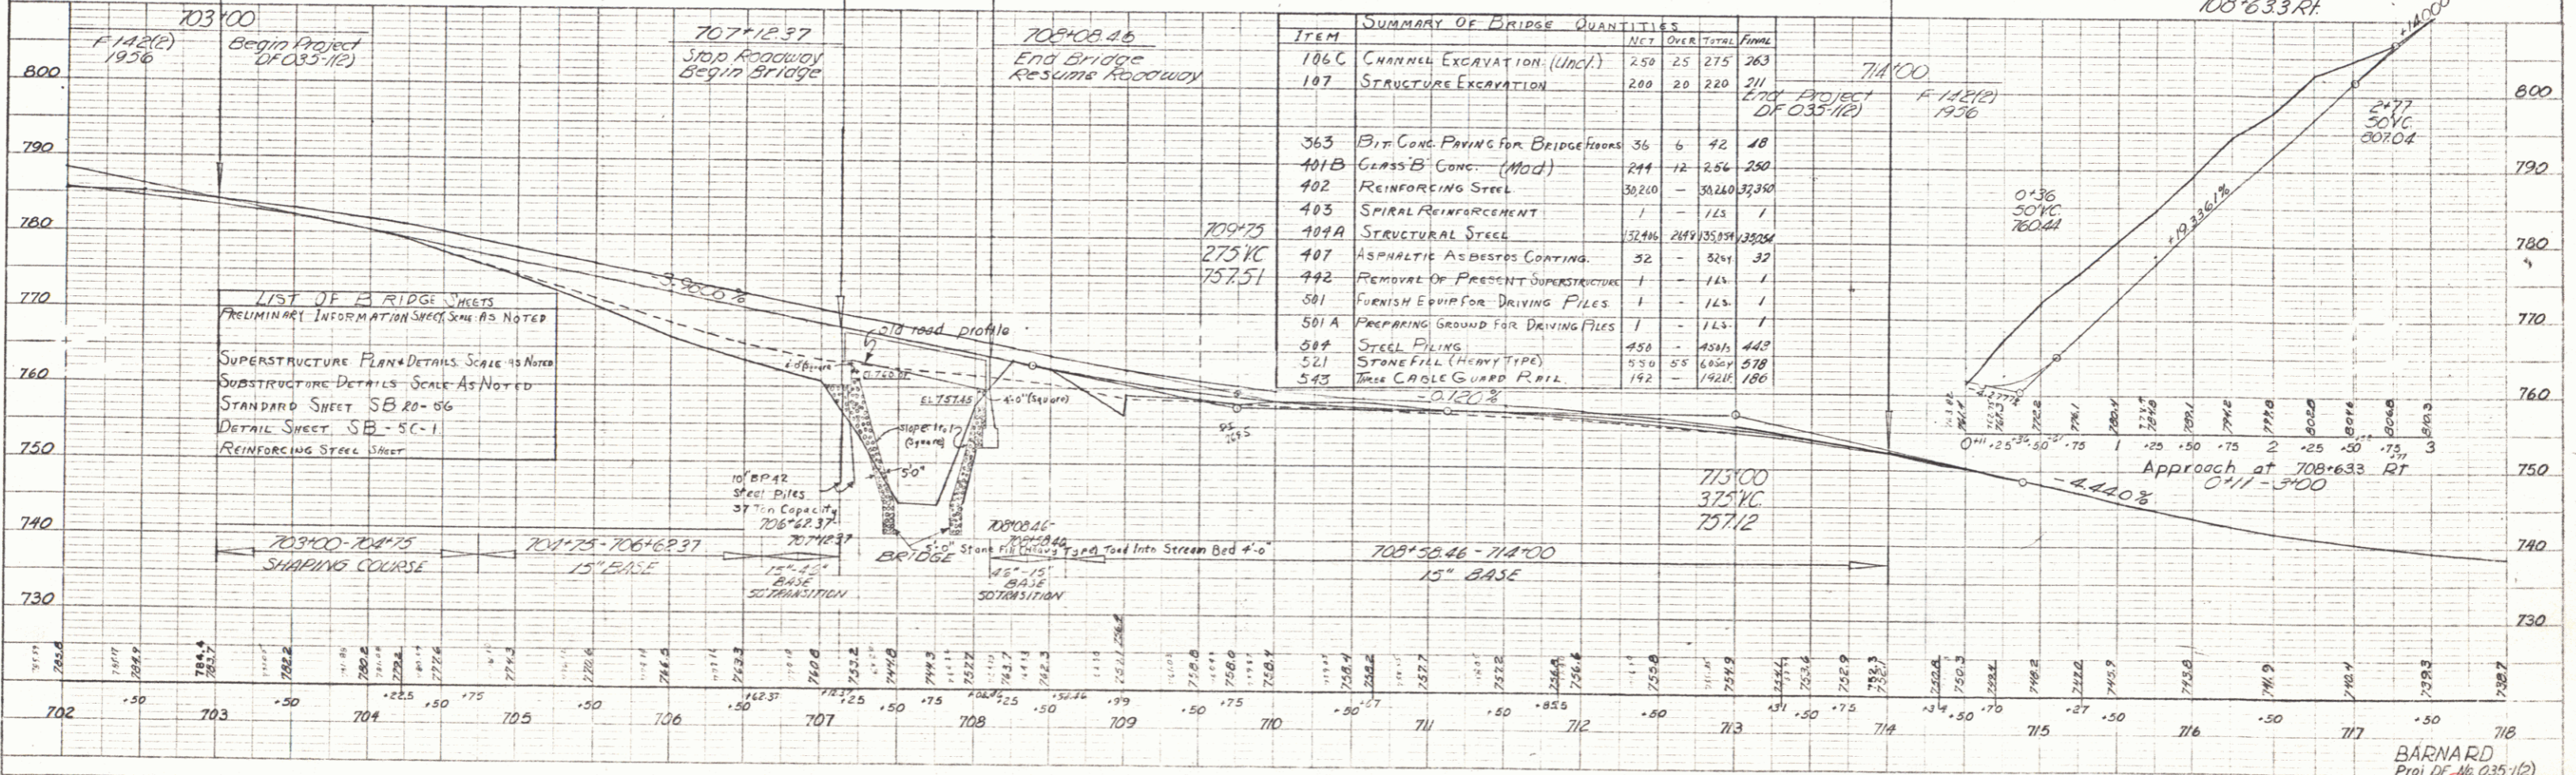

LIST OF BRIDGE SHEETS

PRELIMINARY INFORMATION SHEETS AS NOTED

SUPERSTRUCTURE PLAN & DETAILS SCALE AS NOTED

SUBSTRUCTURE DETAILS SCALE AS NOTED

STANDARD SHEET SB 20-56

DETAIL SHEET SB-5C-1

REINFORCING STEEL SHEET

BARNARD

Proj. No. 035-1(2)

Sheet 5 of 34