

GUIDE POSTS OF WOOD	LEVEL	SIGHT
41+25	1	2
44+56	1	2
49+70	1	1
52+41	1	1



CABLE GUARD RAIL	STA TO STA	LEN	CONSTANT	PAY	LENG
	30+00-31+15	LT	32	40	72
	30+00-31+22	RT	24	40	64
	31+30-31+62	LT	24	40	64
	31+44-31+60	RT	24	40	64

REINFORCED CONCRETE PIPE CULVERTS	STATION	SIZE	LENG	CONCR.	SOIL	BRIDGE	STEEL
	41+25	15"	32'	14.00	14.00	157"	177"
	44+56	15"	32'	14.00	14.00	157"	177"
	49+70	15"	60'	10.00	14.00	157"	177"
	52+41	15"	36'	14.00	14.00	157"	177"

RELAYING PIPE CULVERTS	STATION	LOC.	TYP.	SIZE	LENG.	C.M.
	52+67	LT	COMP	12"	20'	234
	53+72	RT		12"	30'	234

Parcel	Kind of Instrument	Date of Instrument	Grantor	Grantee	Received	Remarks
C	Q.C.D.	6-8-32	PAUL H. GARDNER	State	50	Page 7-14-32
C	Q.C.D.	6-28-32	PAUL H. GARDNER	State	50	Page 7-14-32

DIST. NO.	STATE	PLANNED	SCALE	SHEET NO.	TOTAL SHEETS
1	VT	67-3	1922	7	30

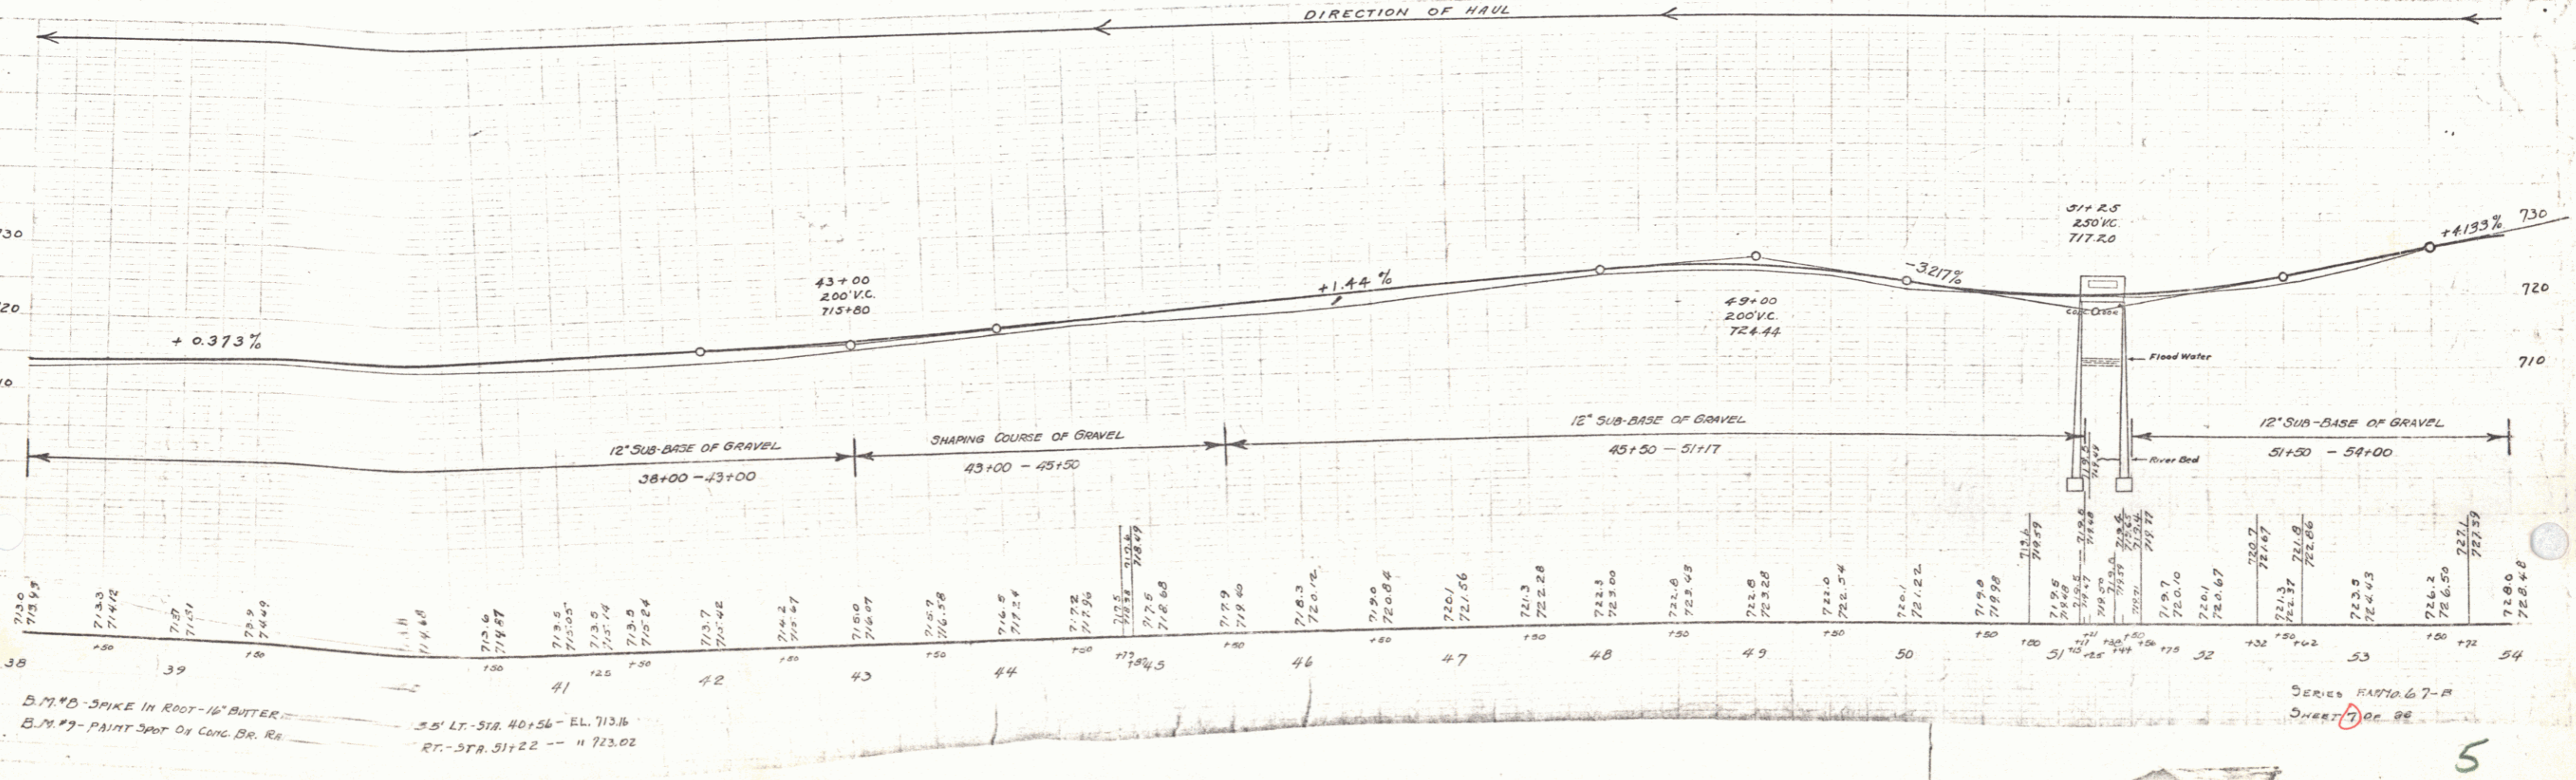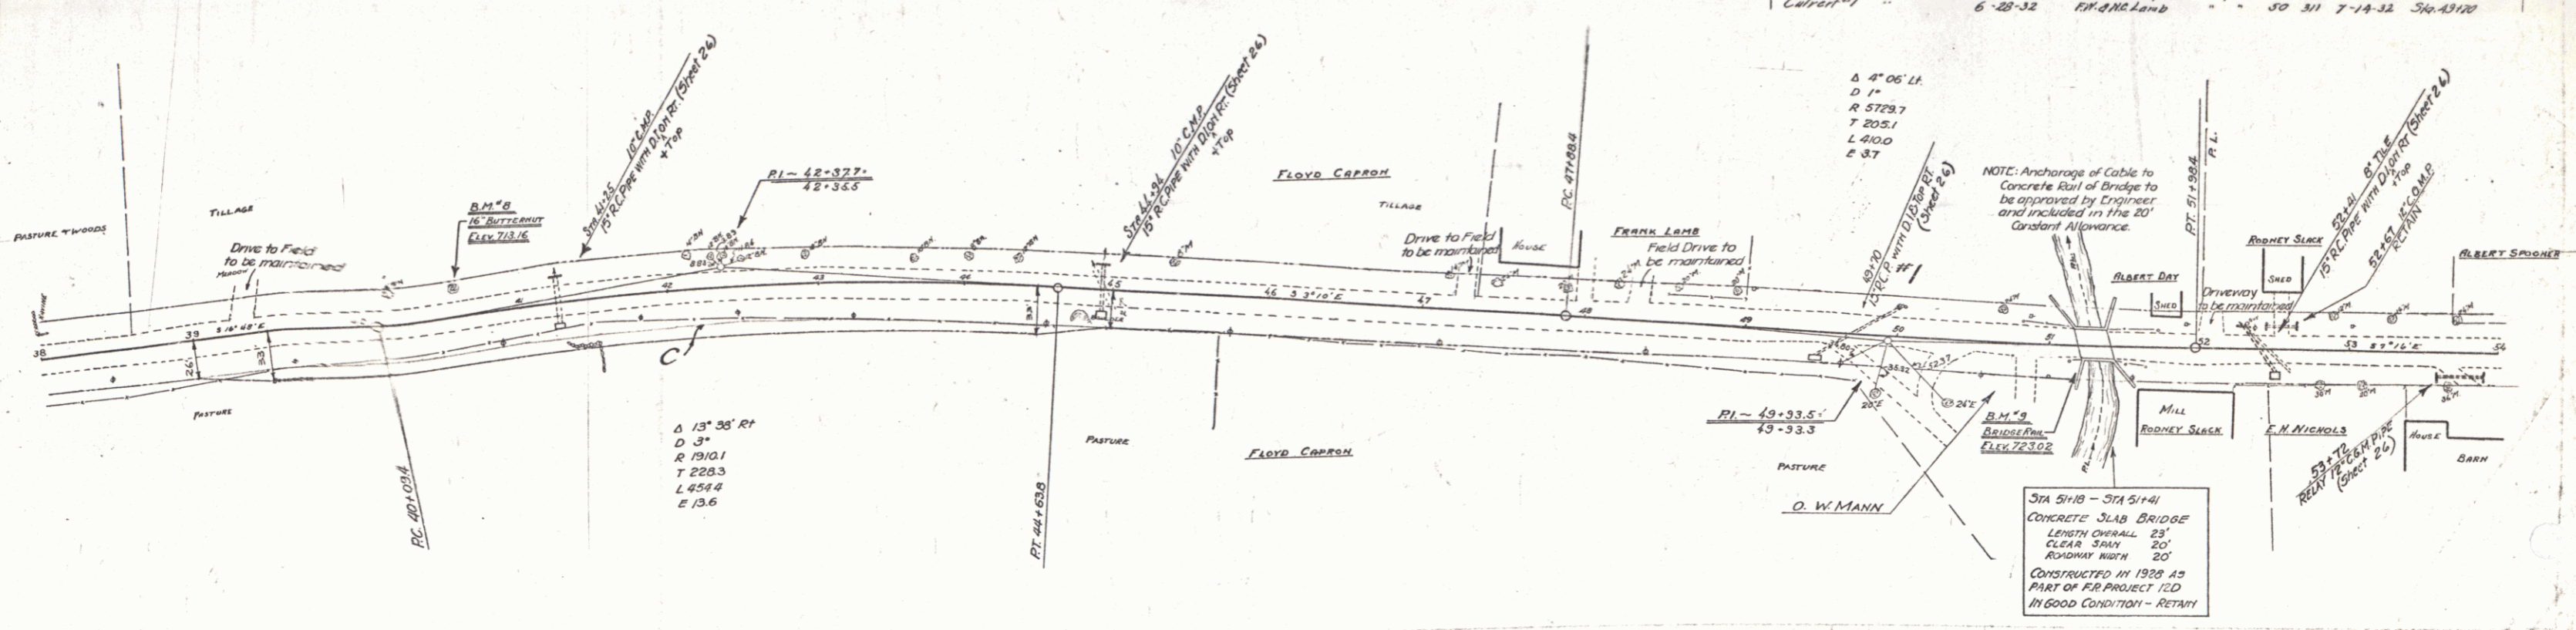

B.M. 9 - SPIKE IN ROOT - 16' BUTTER  
 B.M. 9 - PAINT SPOT ON CONC. BR. RA.  
 35' LT. STA. 40+56 - EL. 713.16  
 RT. - STA. 51+22 - " 723.02

SERIES 67-3-7-8  
 SHEET 7 OF 30