





WOOD  
PINE

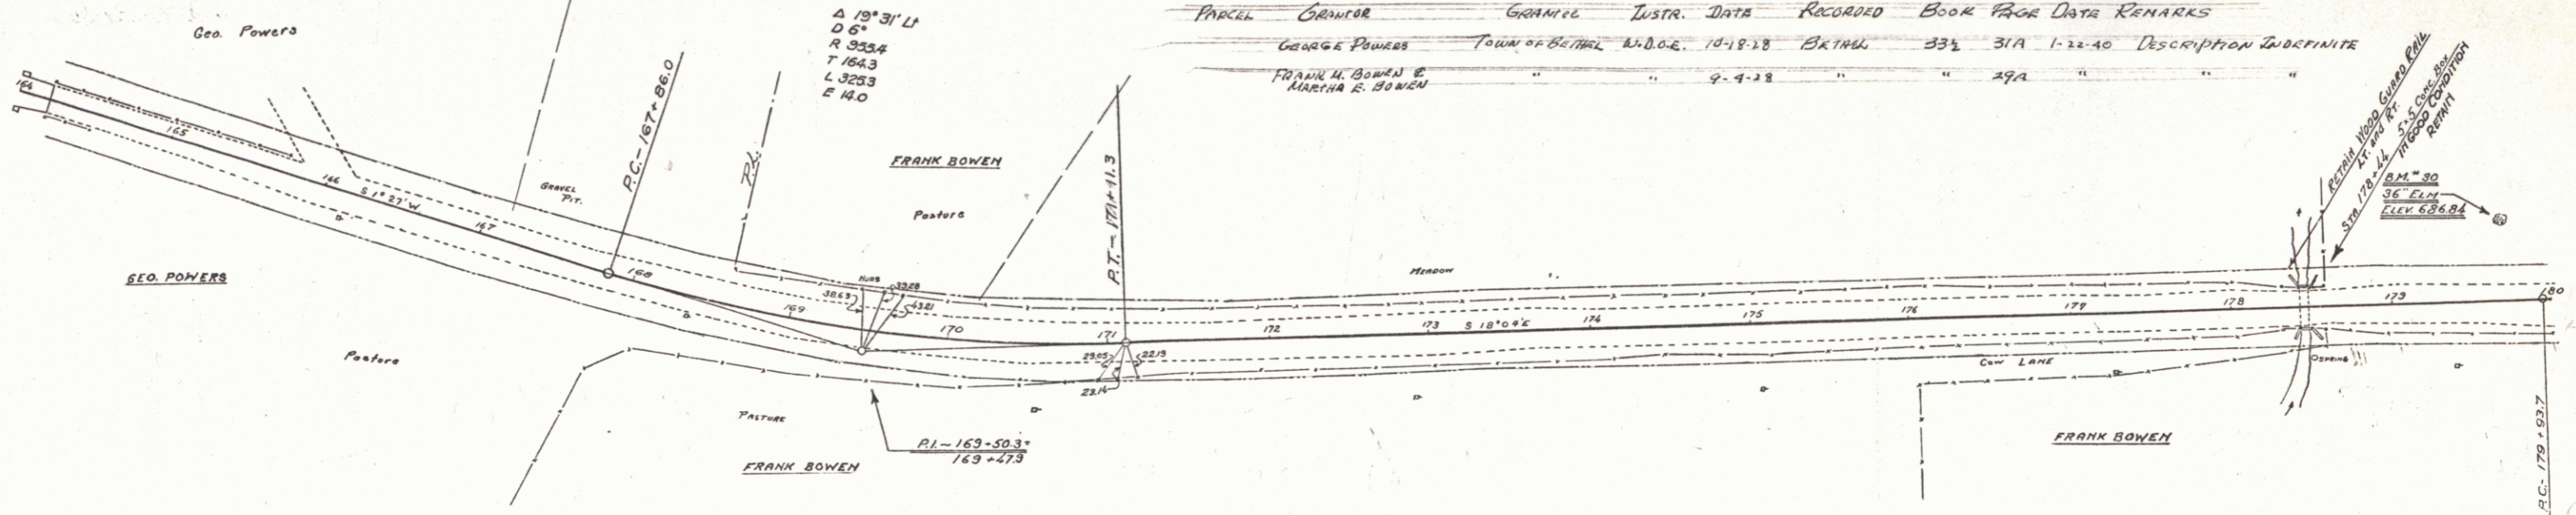

PARCEL	OWNER	GRANT	INSTR. DATA	RECORDED	BOOK	PAGE	DATE	REMARKS
	GEORGE POWERS	TOWN OF BETHEL	N.D.O.C. 10-18-28	SK 116	33	31A	1-22-40	DESCRIPTION INDEFINITE
	FRANK M. BOWEN & MARTHA E. BOWEN					29A		

WOOD  
PINE

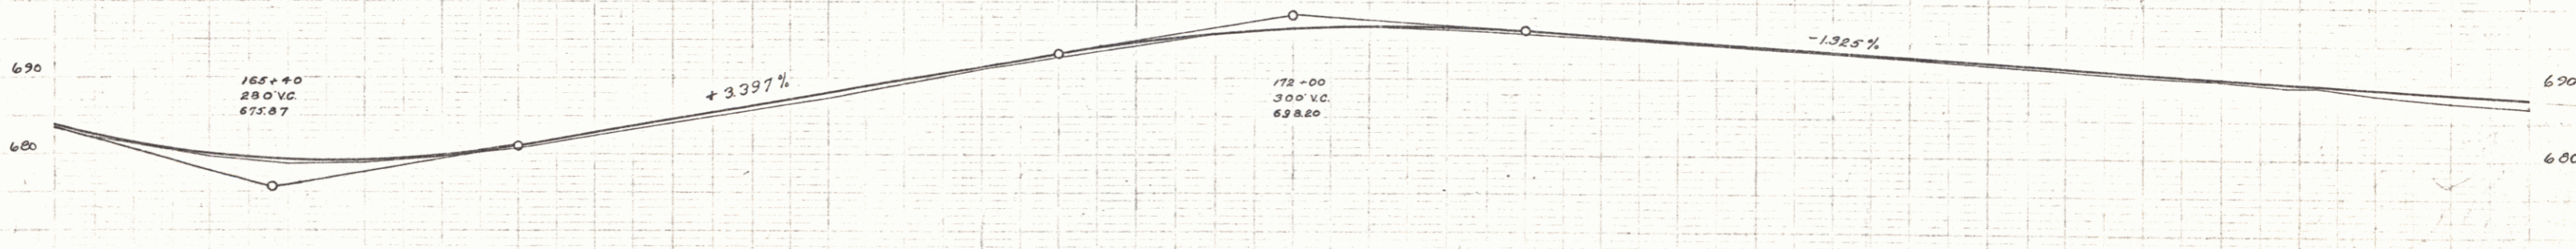

SHAPING COURSE OF GRAVEL  
164+00 - 180+00

STATION	ELEVATION
164	683.25
164	682.25
164	682.42
165	679.12
165	679.22
165	679.06
165	679.06
165	679.26
165	679.18
166	679.18
166	679.18
166	679.06
166	679.06
167	680.08
167	681.22
167	682.5
167	682.91
168	684.41
168	684.41
168	685.5
168	685.5
169	687.4
169	688.07
169	689.3
169	689.71
170	691.4
170	692.9
170	693.7
171	694.3
171	694.60
171	695.8
171	695.71
172	696.5
172	696.43
172	696.7
172	696.75
173	696.4
173	696.68
174	695.2
174	696.21
174	695.3
174	695.55
175	694.7
175	694.69
175	694.0
175	694.22
176	693.4
176	693.56
176	692.7
176	692.90
177	692.0
177	692.24
177	691.3
177	691.58
178	690.5
178	690.71
178	690.2
178	690.25
179	689.5
179	689.73
179	689.4
179	689.26
180	689.0
180	689.0

B.M. 30 SPIRE IN ROOT 35' ELM 49 FT. LY. STA. 173+63 ELEV. 680.84

SERIES F.A.R. NO 67-B  
SHEET 15 OF 26