


GRADE REVISION		JULY 15, 1932	
ORIGINAL	REVISED	ORIGINAL	REVISED
184+00	200' V.C. 681.30	184+00	200' V.C. 682.30
188+50	200' V.C. 674.50	189+50	200' V.C. 672.77
192+00	200' V.C. 668.50	192+50	250' V.C. 670.00
200+50	200' V.C. 662.10	195+50	200' V.C. 663.19

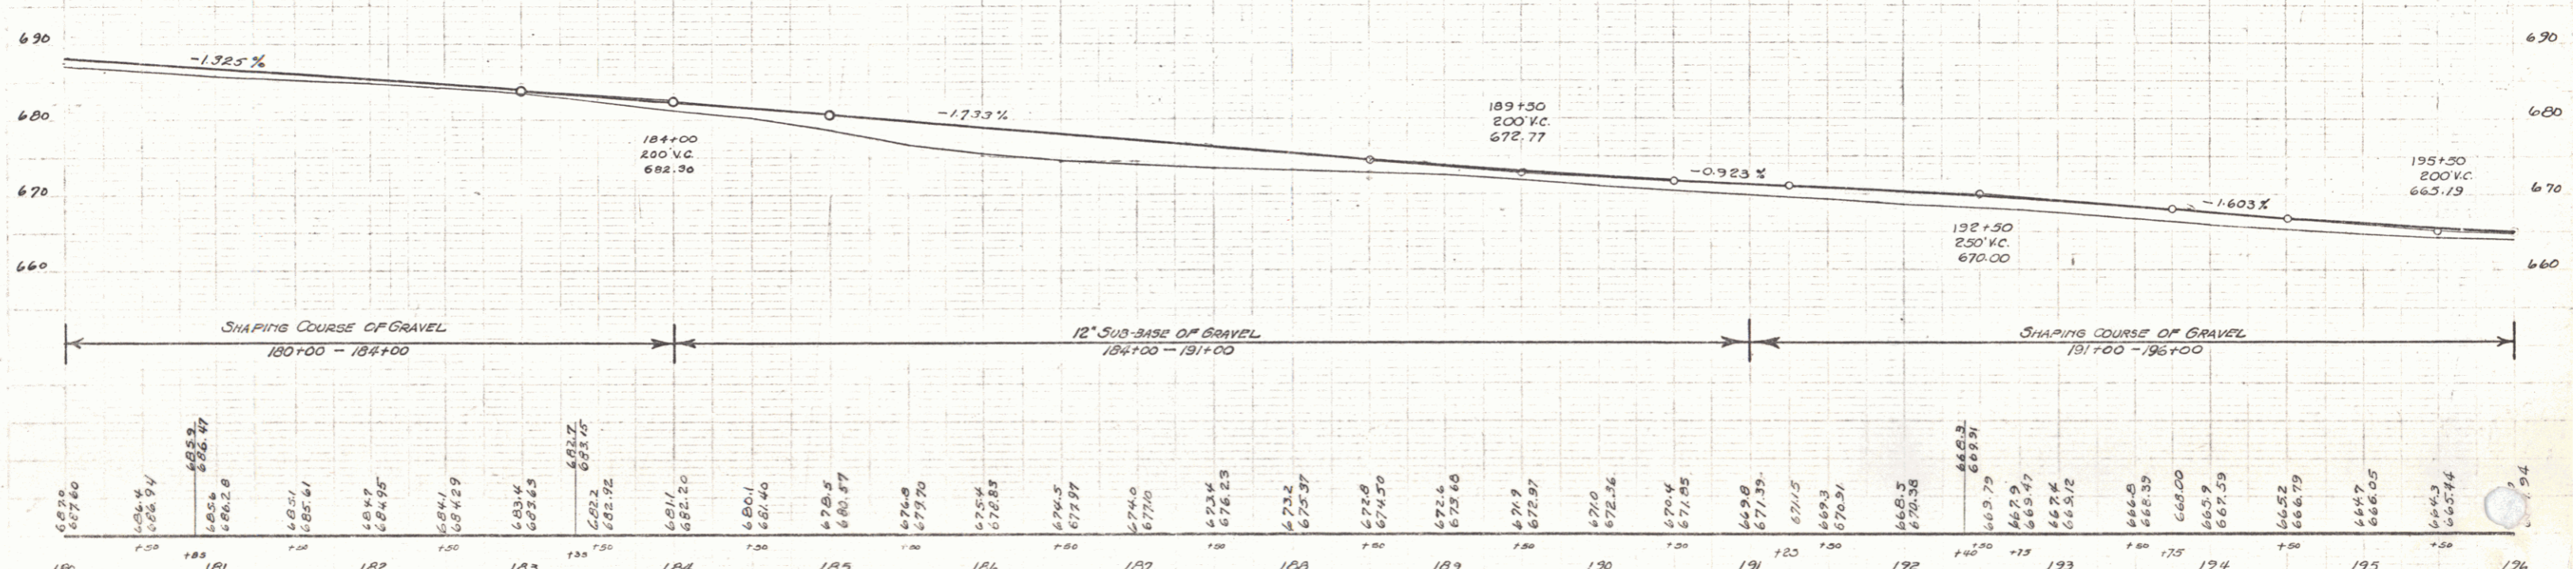

SHAPING COURSE OF GRAVEL 180+00 - 184+00 12" SUB-BASE OF GRAVEL 184+00 - 191+00 SHAPING COURSE OF GRAVEL 191+00 - 196+00

BM#31 SPIKE IN ROOT 30" MAPLE 29 FT RT. STA. 184+64.0 ELEV. 680.42
 BM#32 SPIKE IN ROOT 36" MAPLE 24 FT LT. STA. 191+60 ELEV. 663.75

SERIES F.A.R. NO. 67B
 SHEET 16 OF 36