
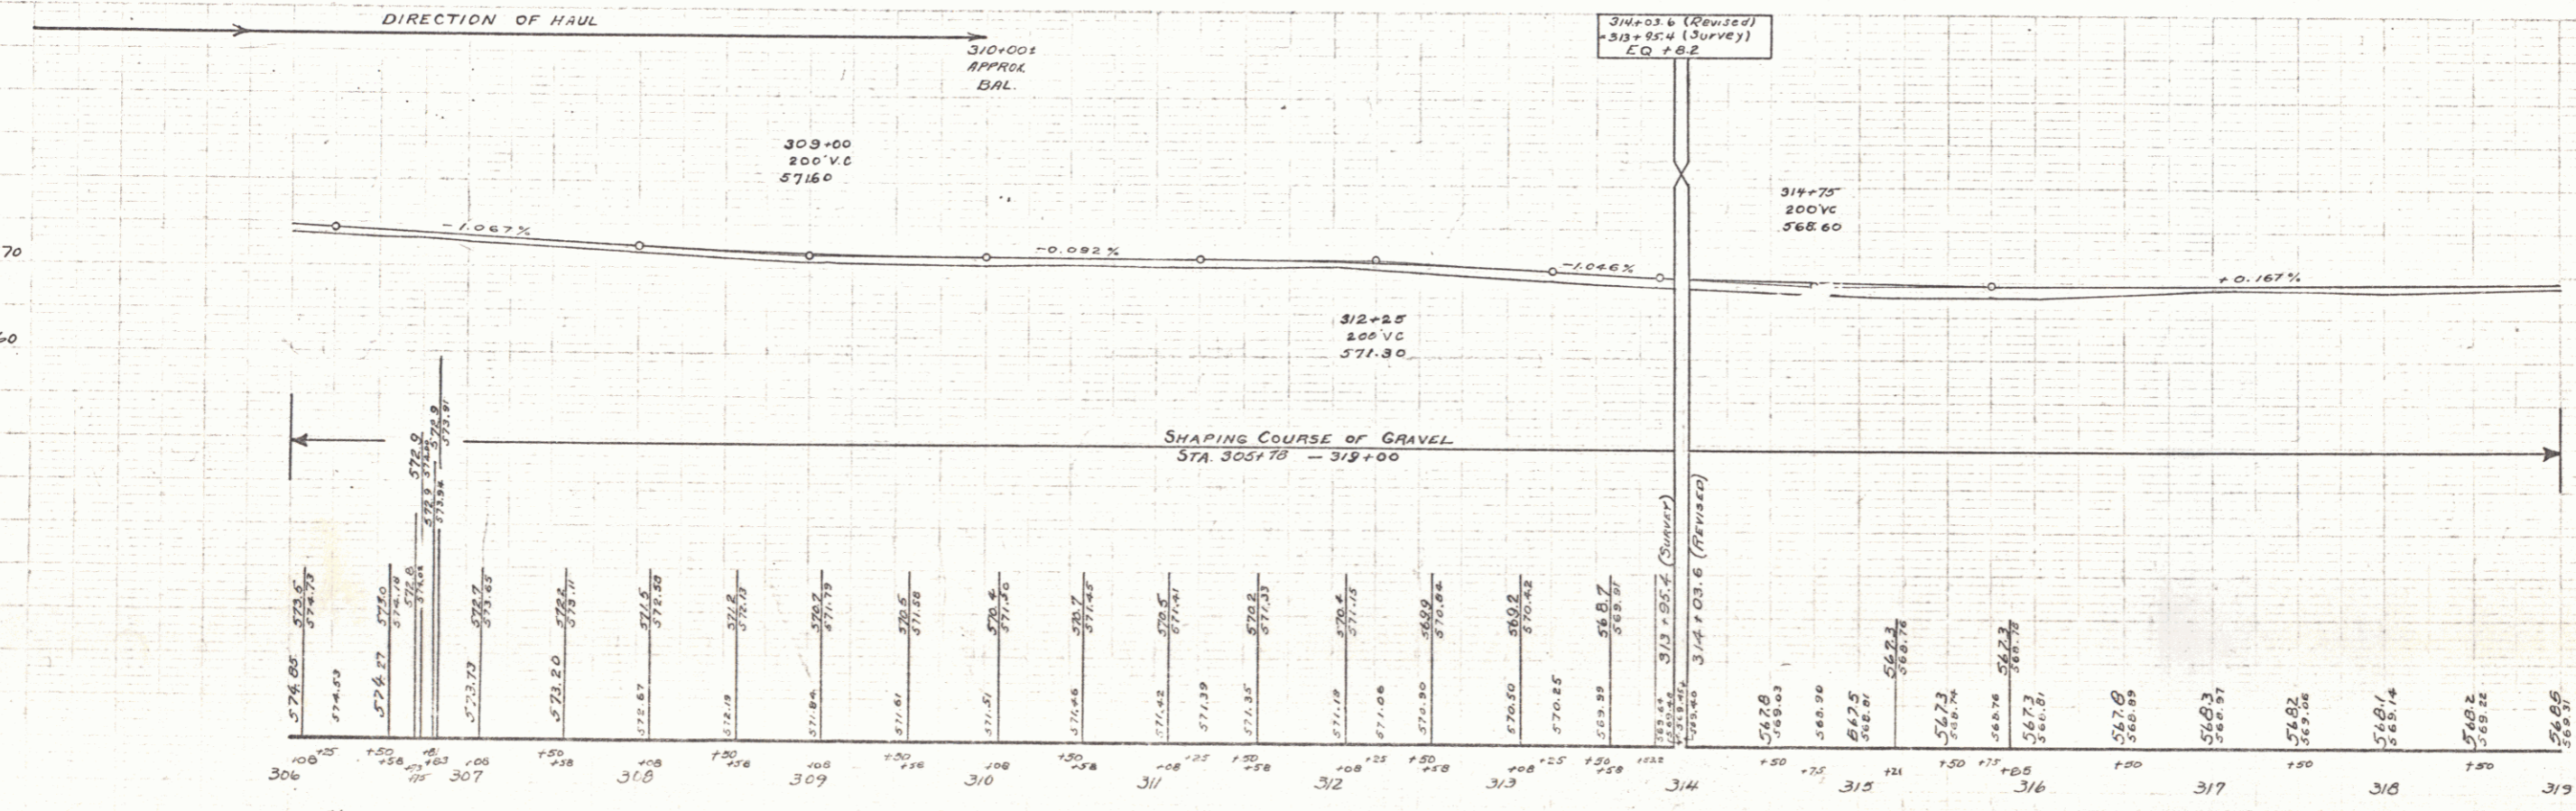


WOOD GUARD RAIL		
CULVERT STA.	LEFT	RIGHT
306+71	24	28
310+00	24	—
310+22	28	—

REINFORCED CONCRETE BOX CULVERTS			
STATION	SIZE	CONC. #	REINFORCEMENT
306+71	816	42.34	2997#
310+00	15	44	214
310+22	18	36	834

REINFORCED CONCRETE PIPE CULVERTS			
STATION	SIZE	CONC. #	REINFORCEMENT
306+71	816	42.34	2997#
310+00	15	44	214
310+22	18	36	834

Parcel	Kind of Instrument	Date of Instrument	Grantor	Grantee	Recorded Book	Page	Date	Remarks
B	G.C.D.	8-26-32	Elmer Spaulding	Shelton	36	26	8-26-32	

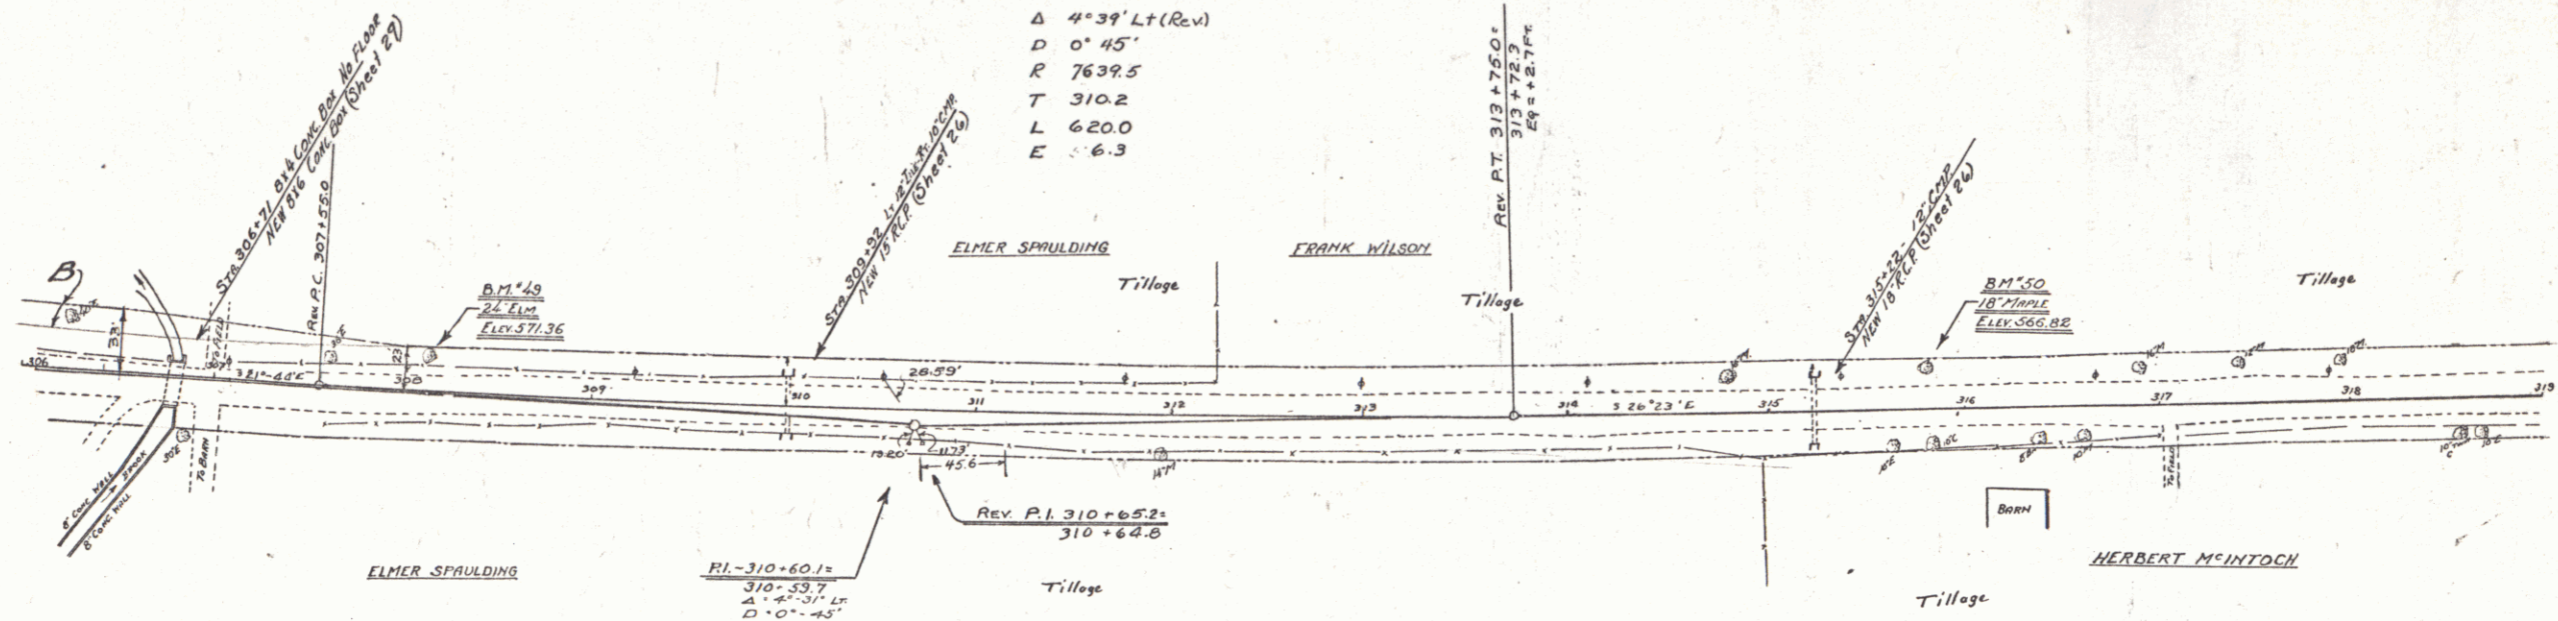

BM 43 SPIKE IN ROOT 24' ELM 14.5 FT LT STA 308+02 ELEV 571.36
 BM 50 SPIKE IN ROOT 18' MAPLE 14.5 FT LT STA 315+81 ELEV 566.82