
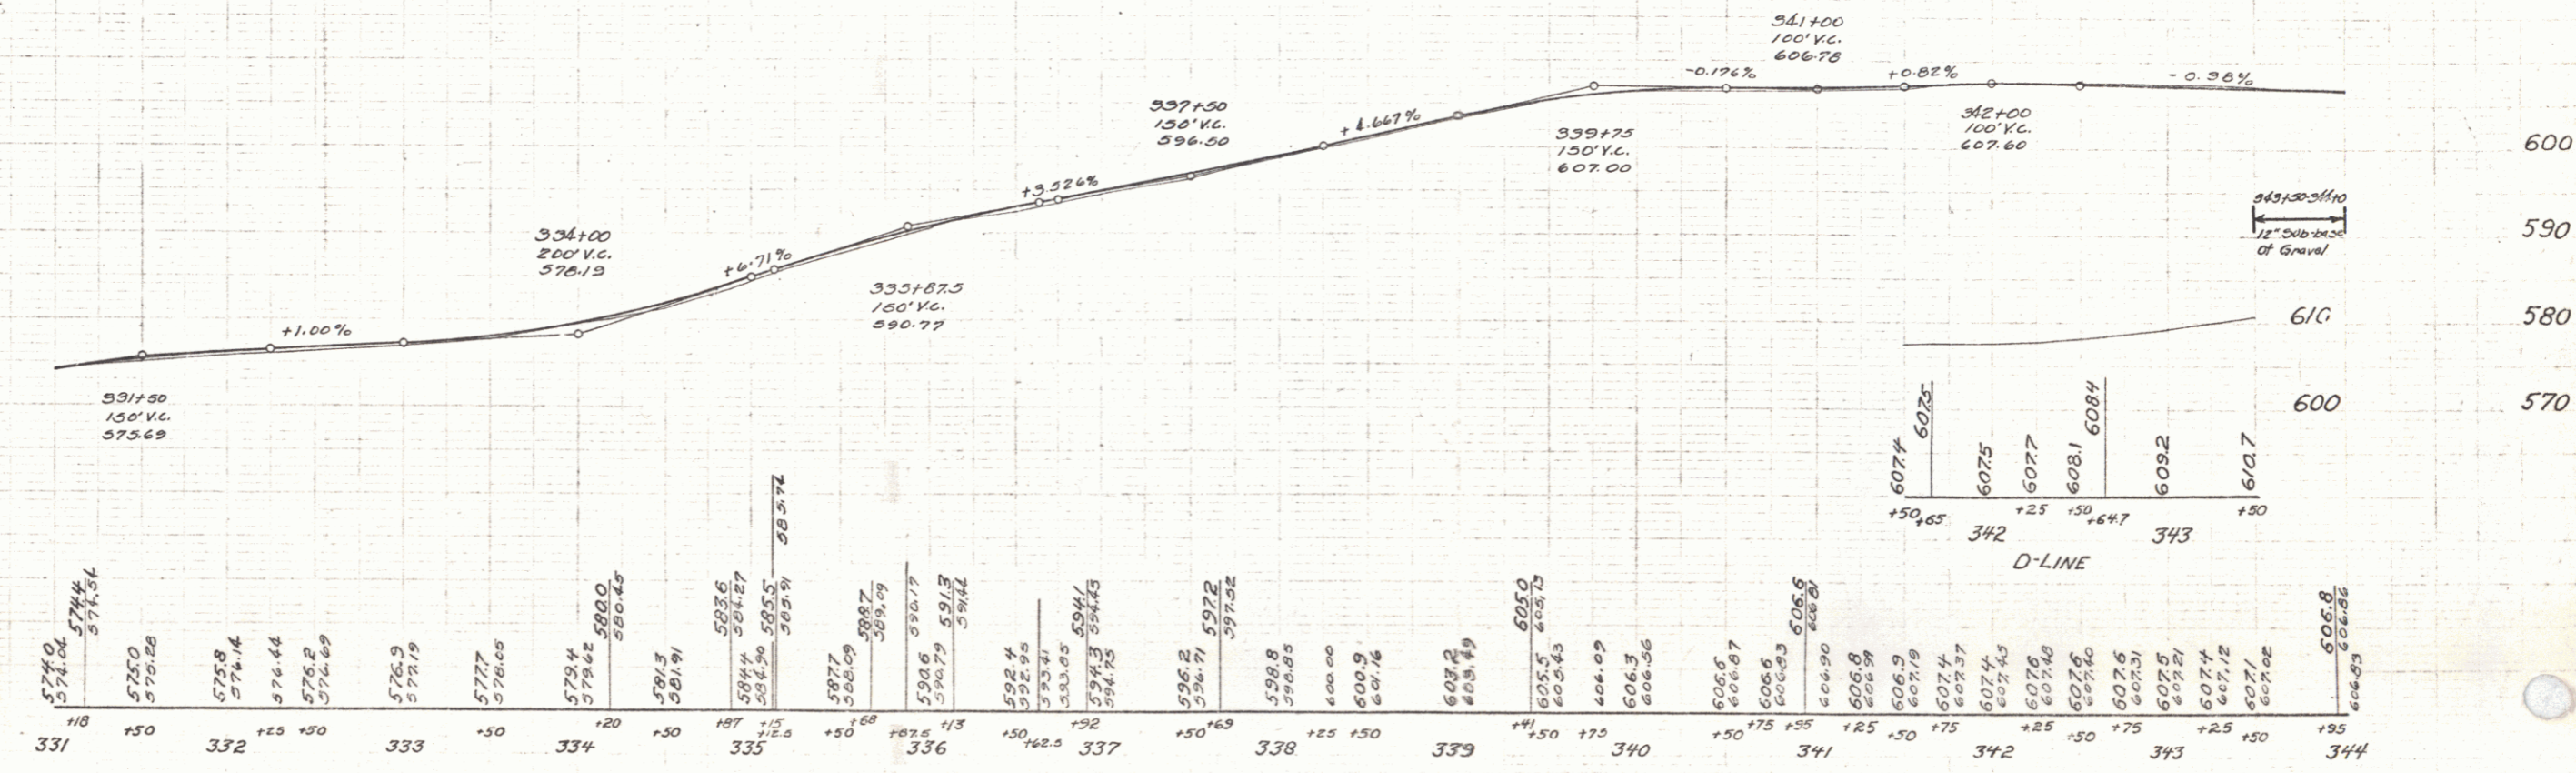


PLAN  
WOOD  
TRAILS

WOOD  
TRAILS

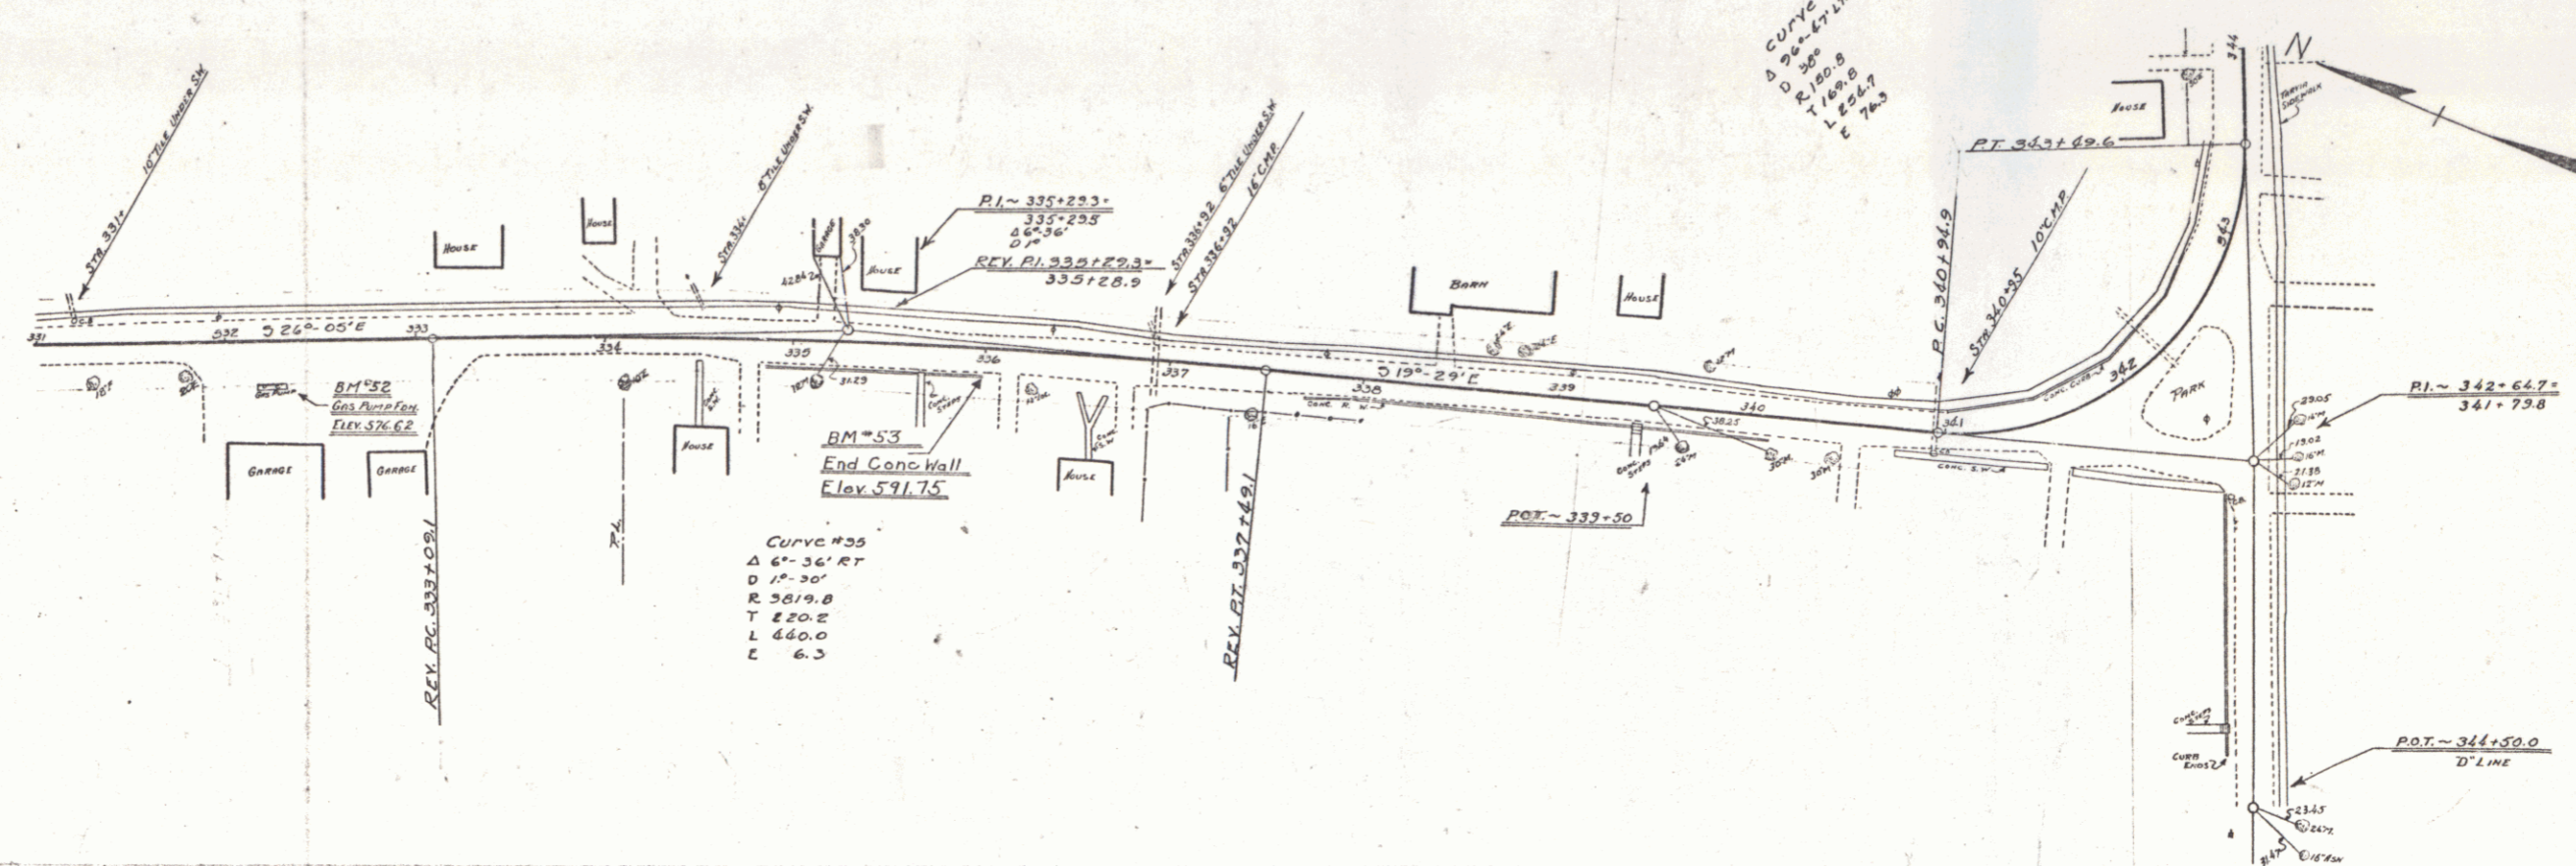

B.M. \* 52 GAS PUMP CONC. FDN 24' RT. STA. 332+16 ELEV. 576.62  
 B.M. \* 53 END OF CONC. WALL 12.5 RT. STA. 336+00 ELEV. 591.75

SERIES F NO 67B  
 SHEET 25A OF