



PLAN
 DATE: _____
 DRAWN BY: _____
 CHECKED BY: _____
 DATE: _____

PROFILE
 DATE: _____
 DRAWN BY: _____
 CHECKED BY: _____
 DATE: _____

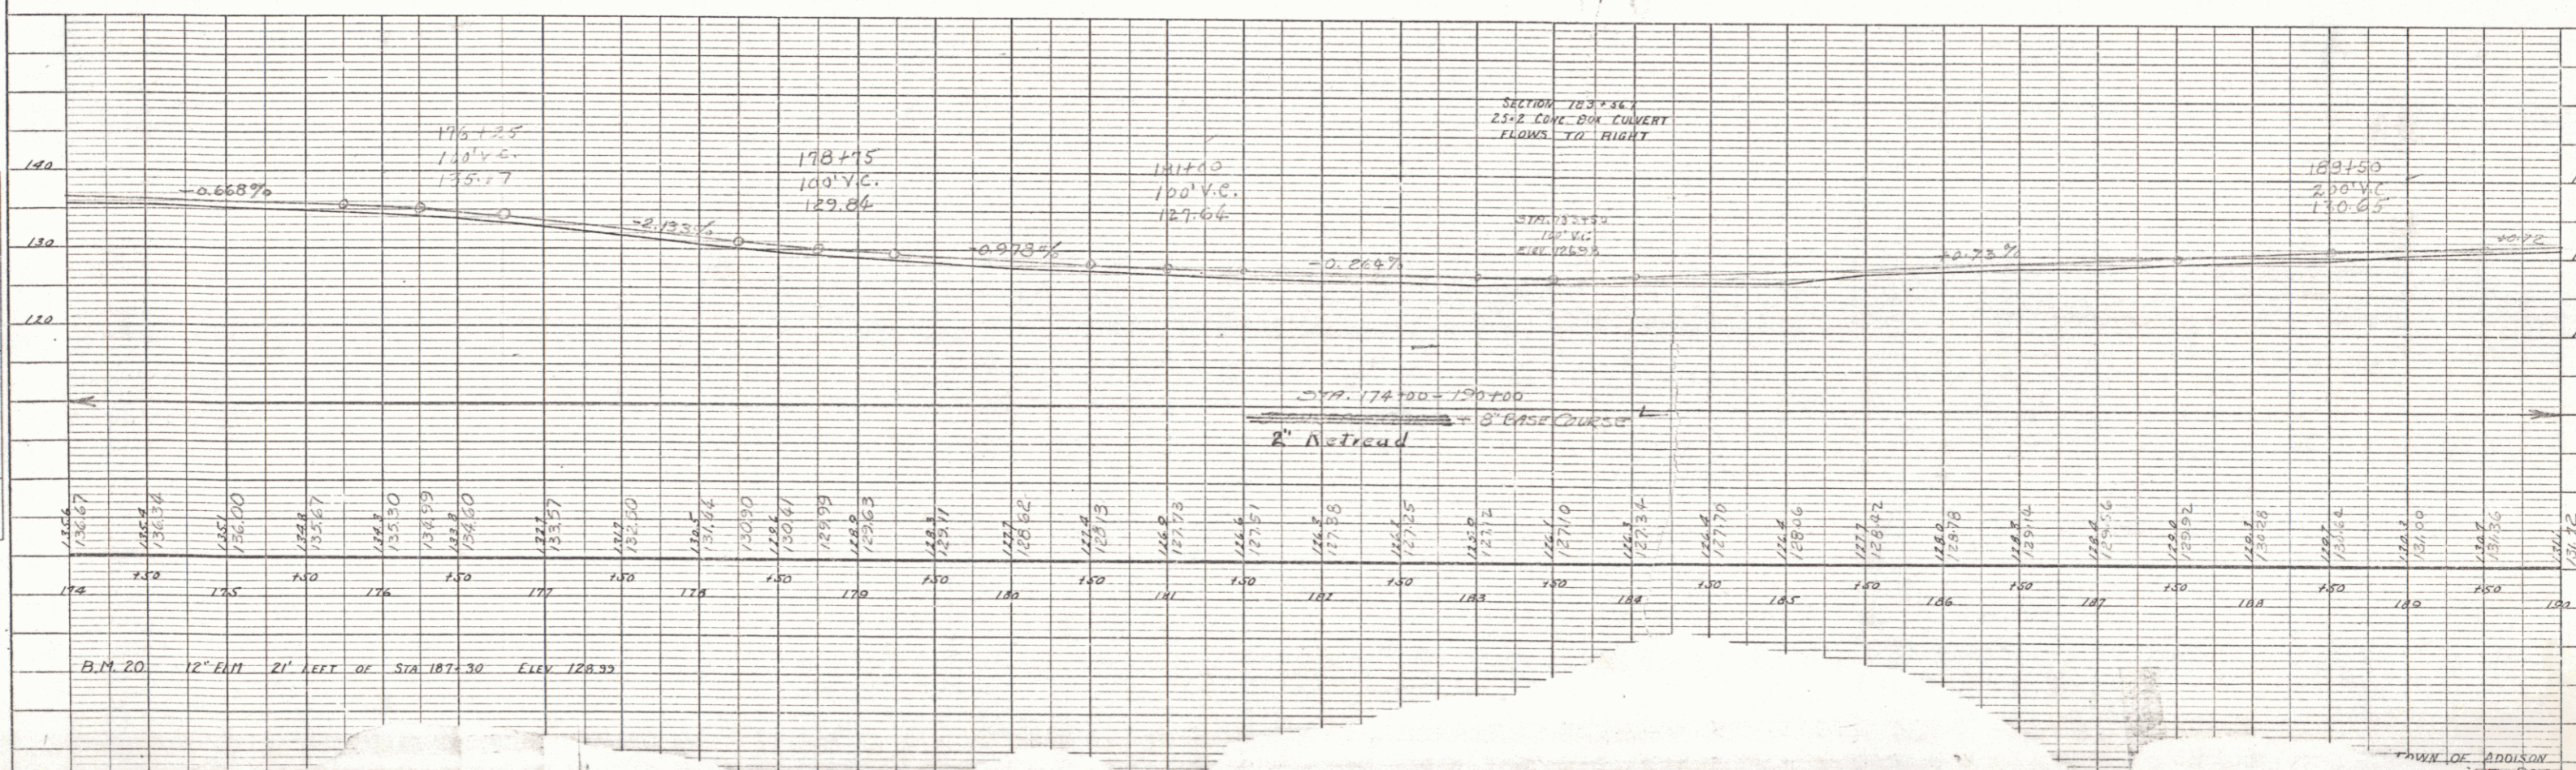

PLAN
 SURVEYED BY C. E. LUNNAN 1922
 NOTED AND CHECKED BY C. E. LUNNAN 1922
 NO. 1

PROFILE
 SURVEYED BY C. E. LUNNAN 1922
 NOTED AND CHECKED BY C. E. LUNNAN 1922
 NO. 1

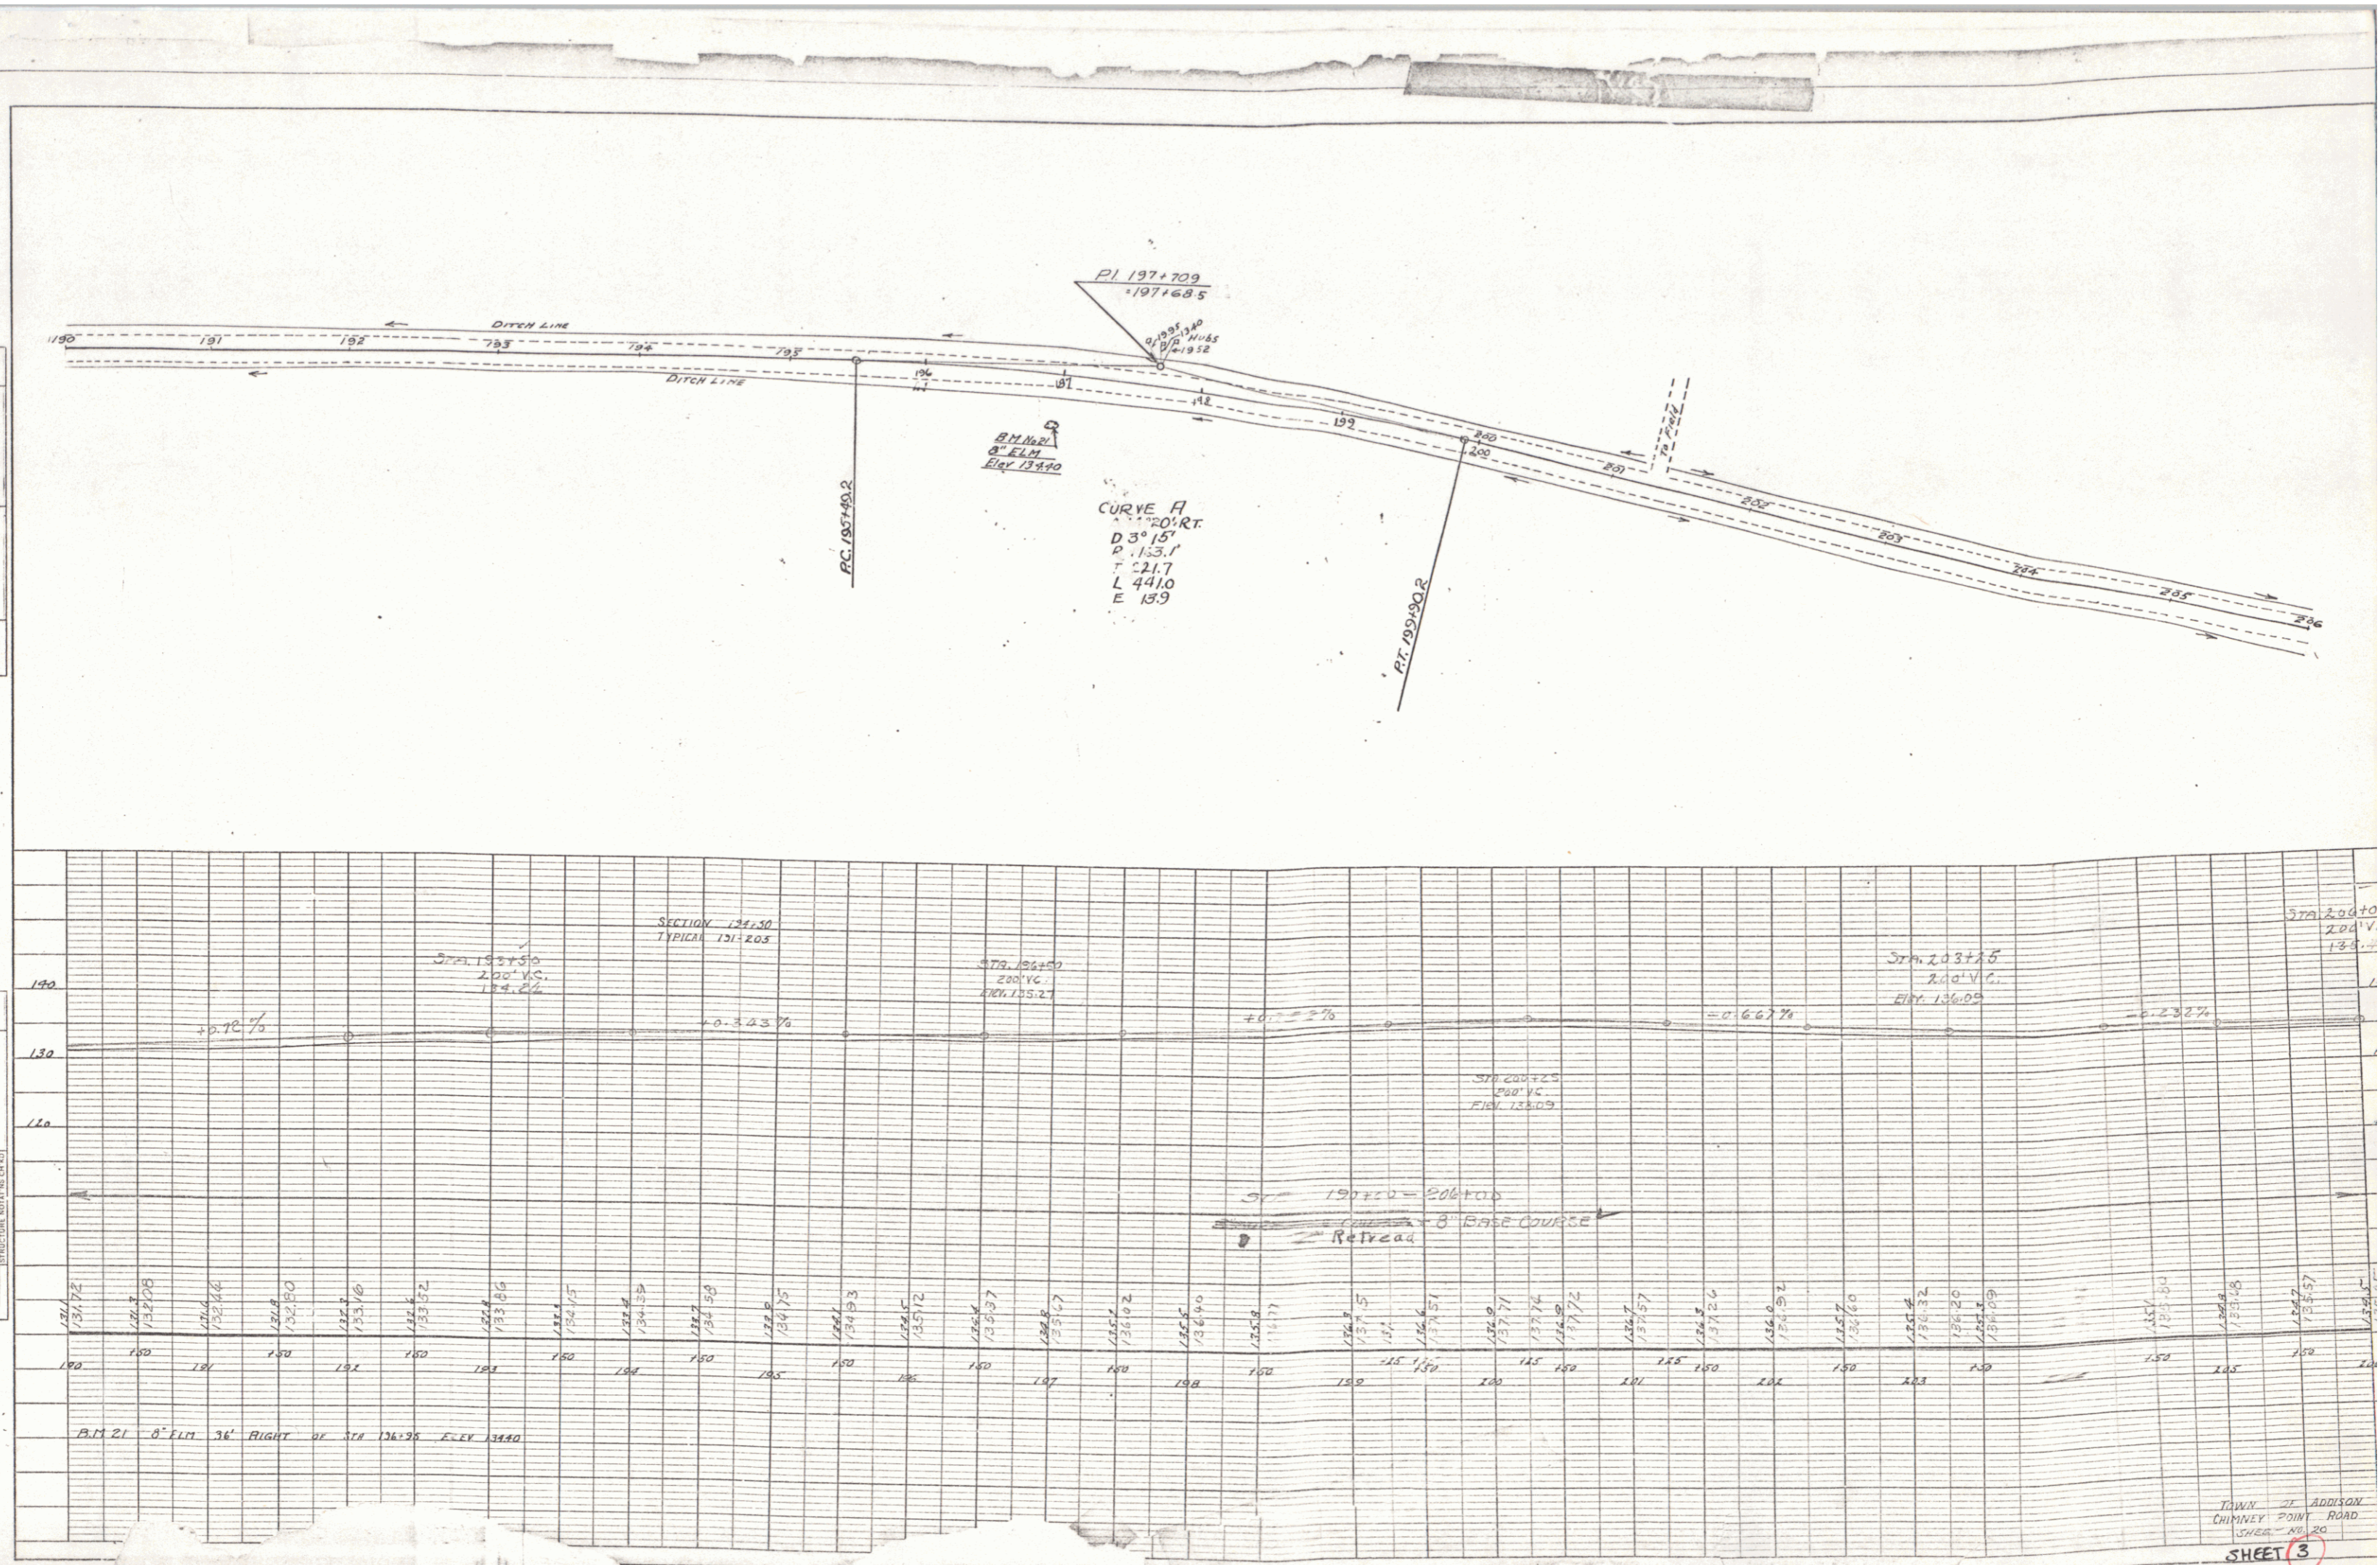

TOWN OF ADDISON
 CHIMNEY POINT ROAD
 SHEET 3

3