
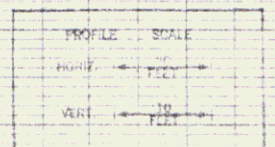
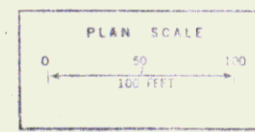


PLAN  
 DATE: \_\_\_\_\_  
 DRAWN BY: \_\_\_\_\_  
 CHECKED BY: \_\_\_\_\_  
 NO. \_\_\_\_\_

PROFILE  
 DATE: \_\_\_\_\_  
 DRAWN BY: \_\_\_\_\_  
 CHECKED BY: \_\_\_\_\_  
 NO. \_\_\_\_\_

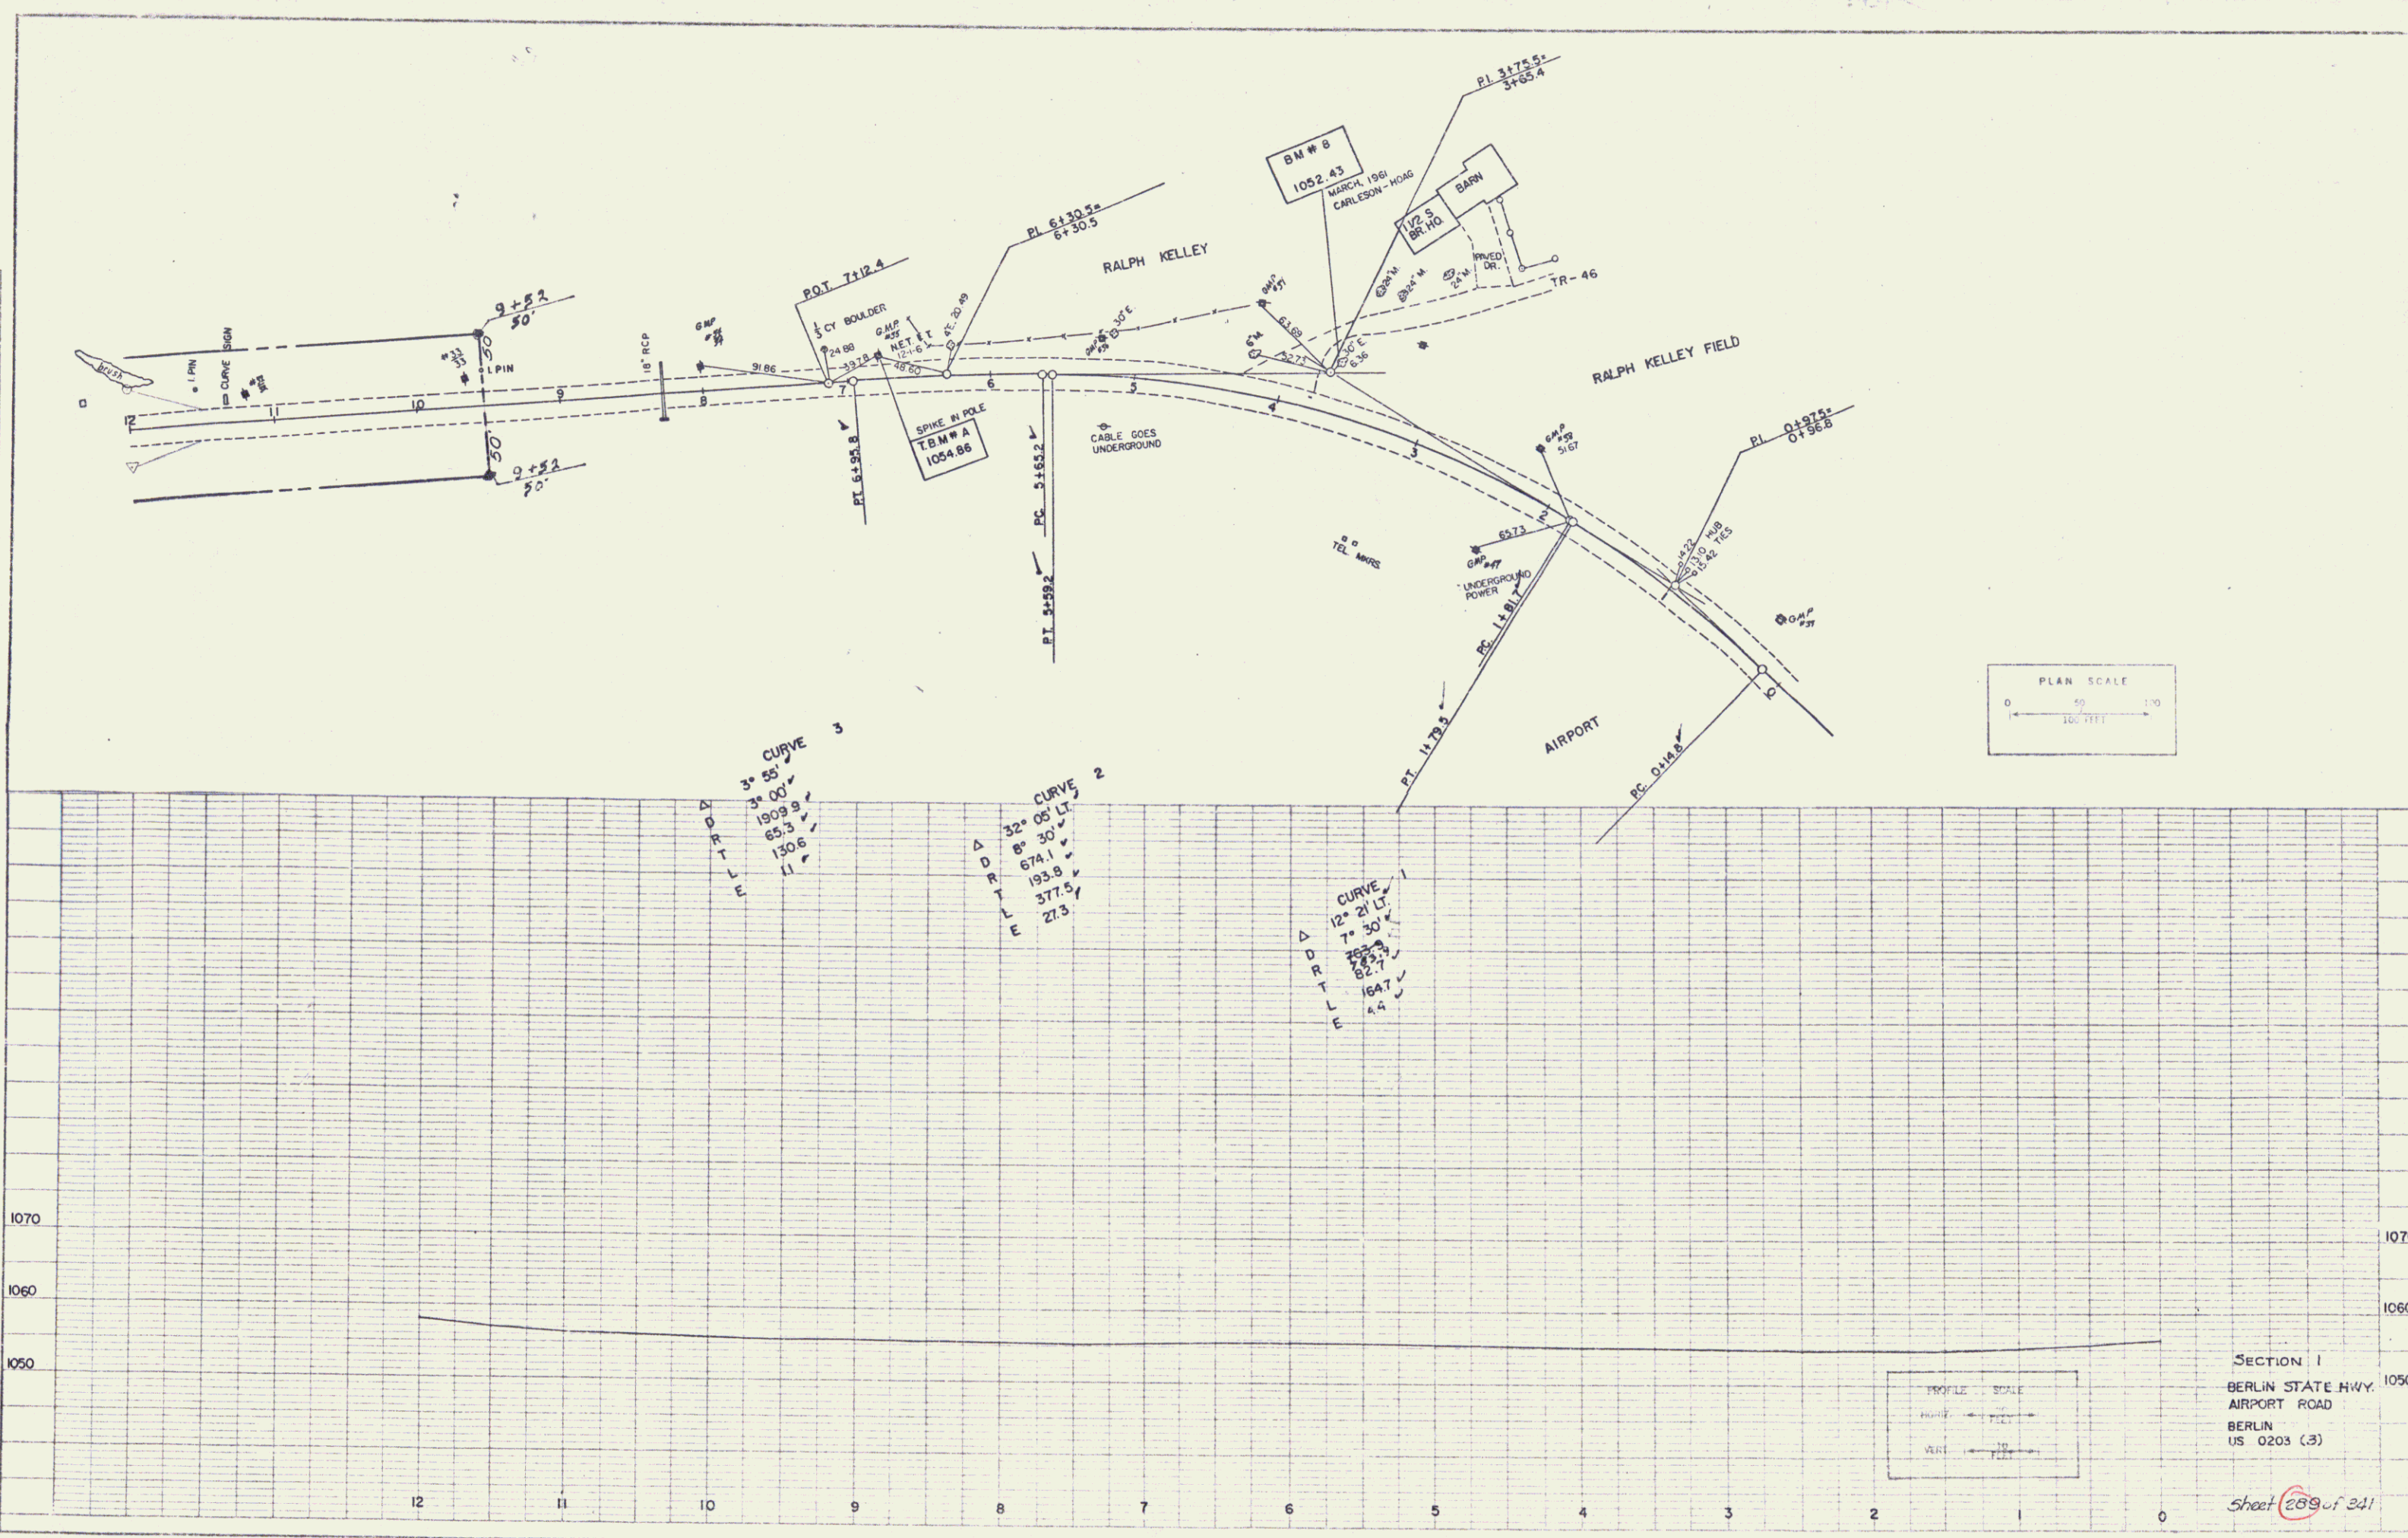

SECTION 1  
 BERLIN STATE HWY.  
 AIRPORT ROAD  
 BERLIN  
 US 0203 (.3)

Sheet 289 of 241

PLANNING & ENGINEERING  
 1215 N. 10TH ST.  
 MILWAUKEE, WIS. 53233