


See Row plans for Sell-off.

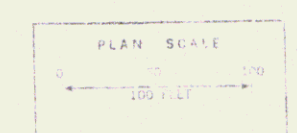

BERLIN
 BERLIN STATE HIGHWAY SECTION 2
 SURVEYED BY JEWETT DATE JUN 1970
 DRAWN BY R.A.B. DATE JUL 1970
 TRACED BY R.A.B. DATE AUG 1970

PROJ. NO. NO. 0203 (3)
 SHEET 293 OF 341

OC= 1992 ADT
 (OO)= 1992 DHV
 OC= 1992 DDHV
 W BELT TO MAPLE AVE. # I-89 OPER