



MP 1.028-0.163

RIGHT-OF-WAY DIVISION
TOWN FILE
PERPETUAL
Town of Berlin SH

Re built
in this area


PLAN
DESIGNED BY
CHECKED BY
DATE
BY

PROFILE
DESIGNED BY
CHECKED BY
DATE
BY

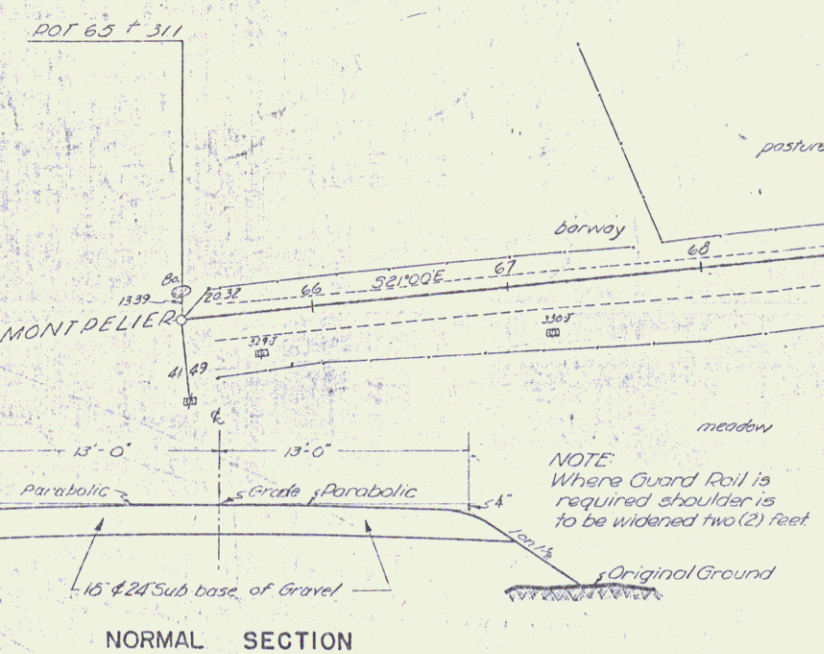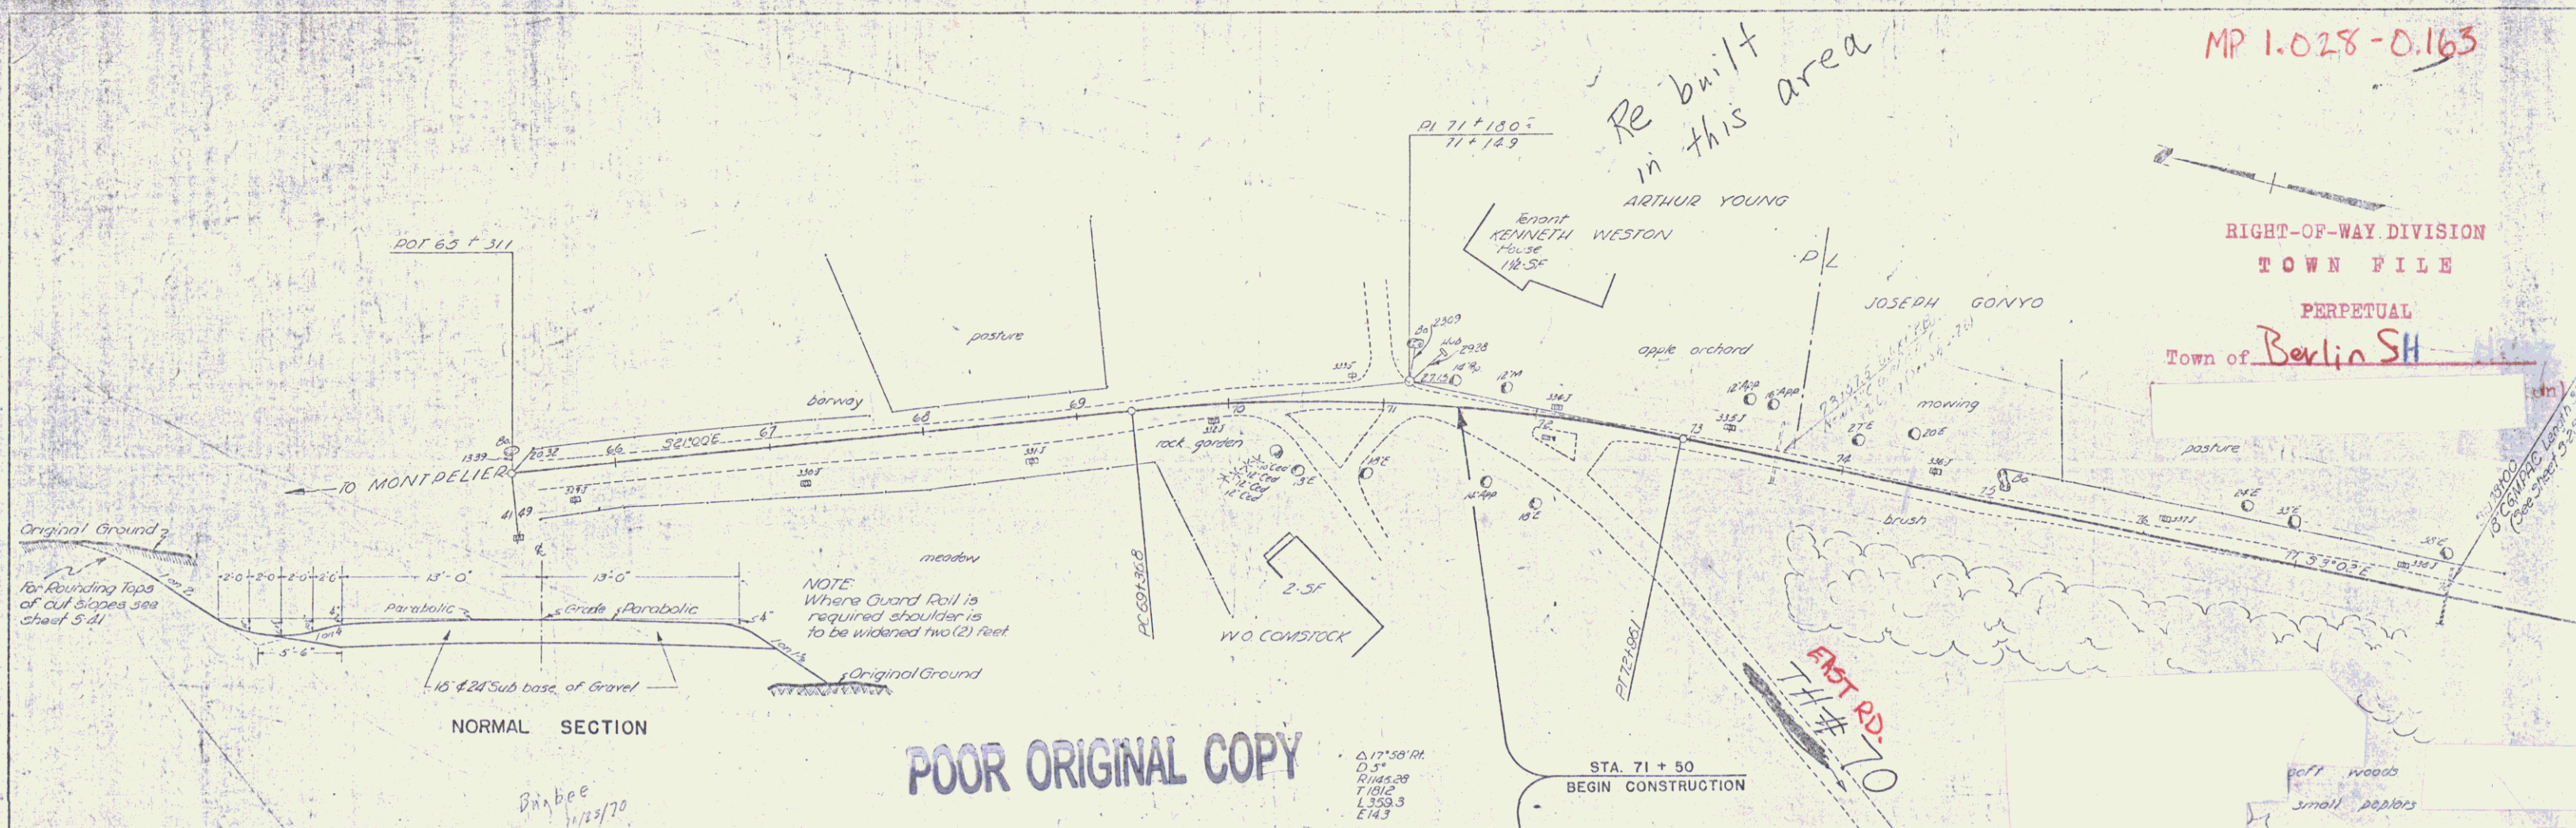


POOR ORIGINAL COPY

TOWN OF BERLIN
Project SA 1945
Pin # 01R148
Route ST HWY
Date 1/1/1945

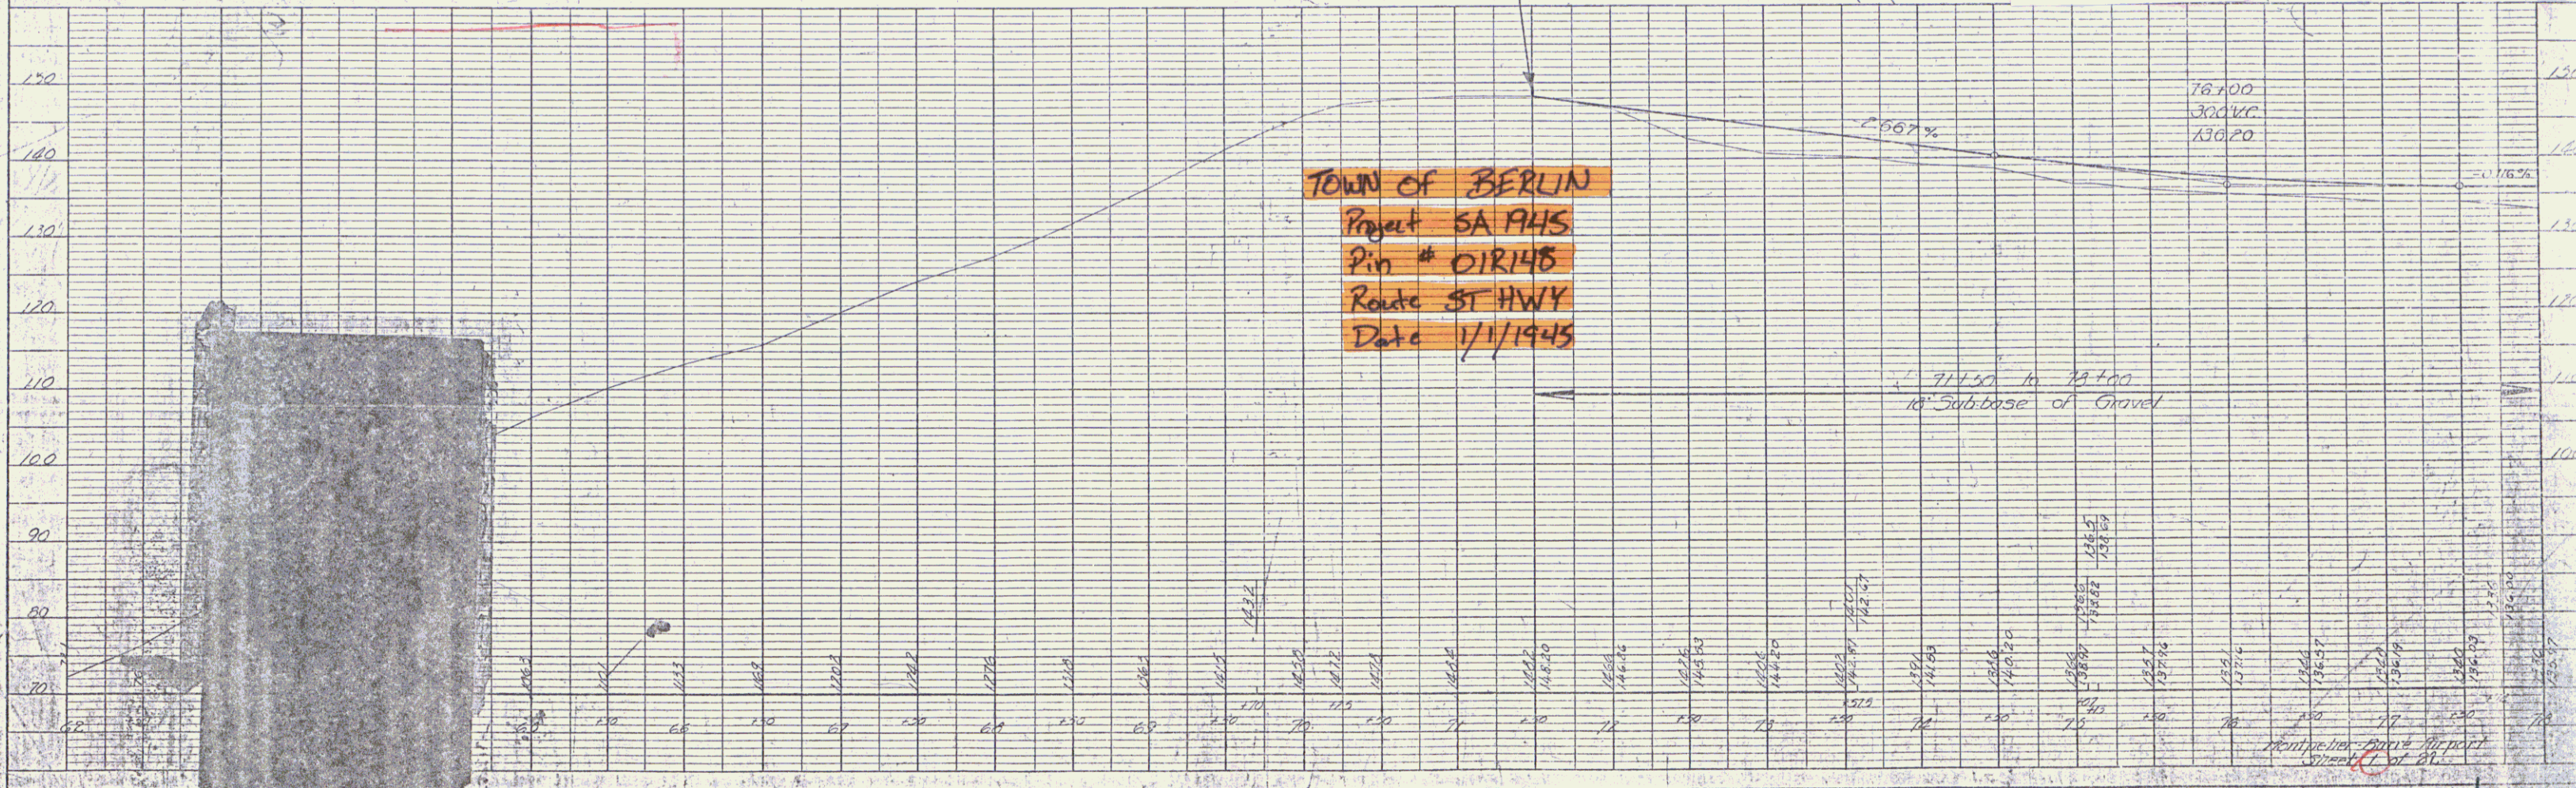


PLAN	DATE
PROJECT	BY
NOTED	BY
NOTE BOOK	NO.
NO.	

PROFILE	DATE
PROJECT	BY
NOTED	BY
NOTE BOOK	NO.
NO.	

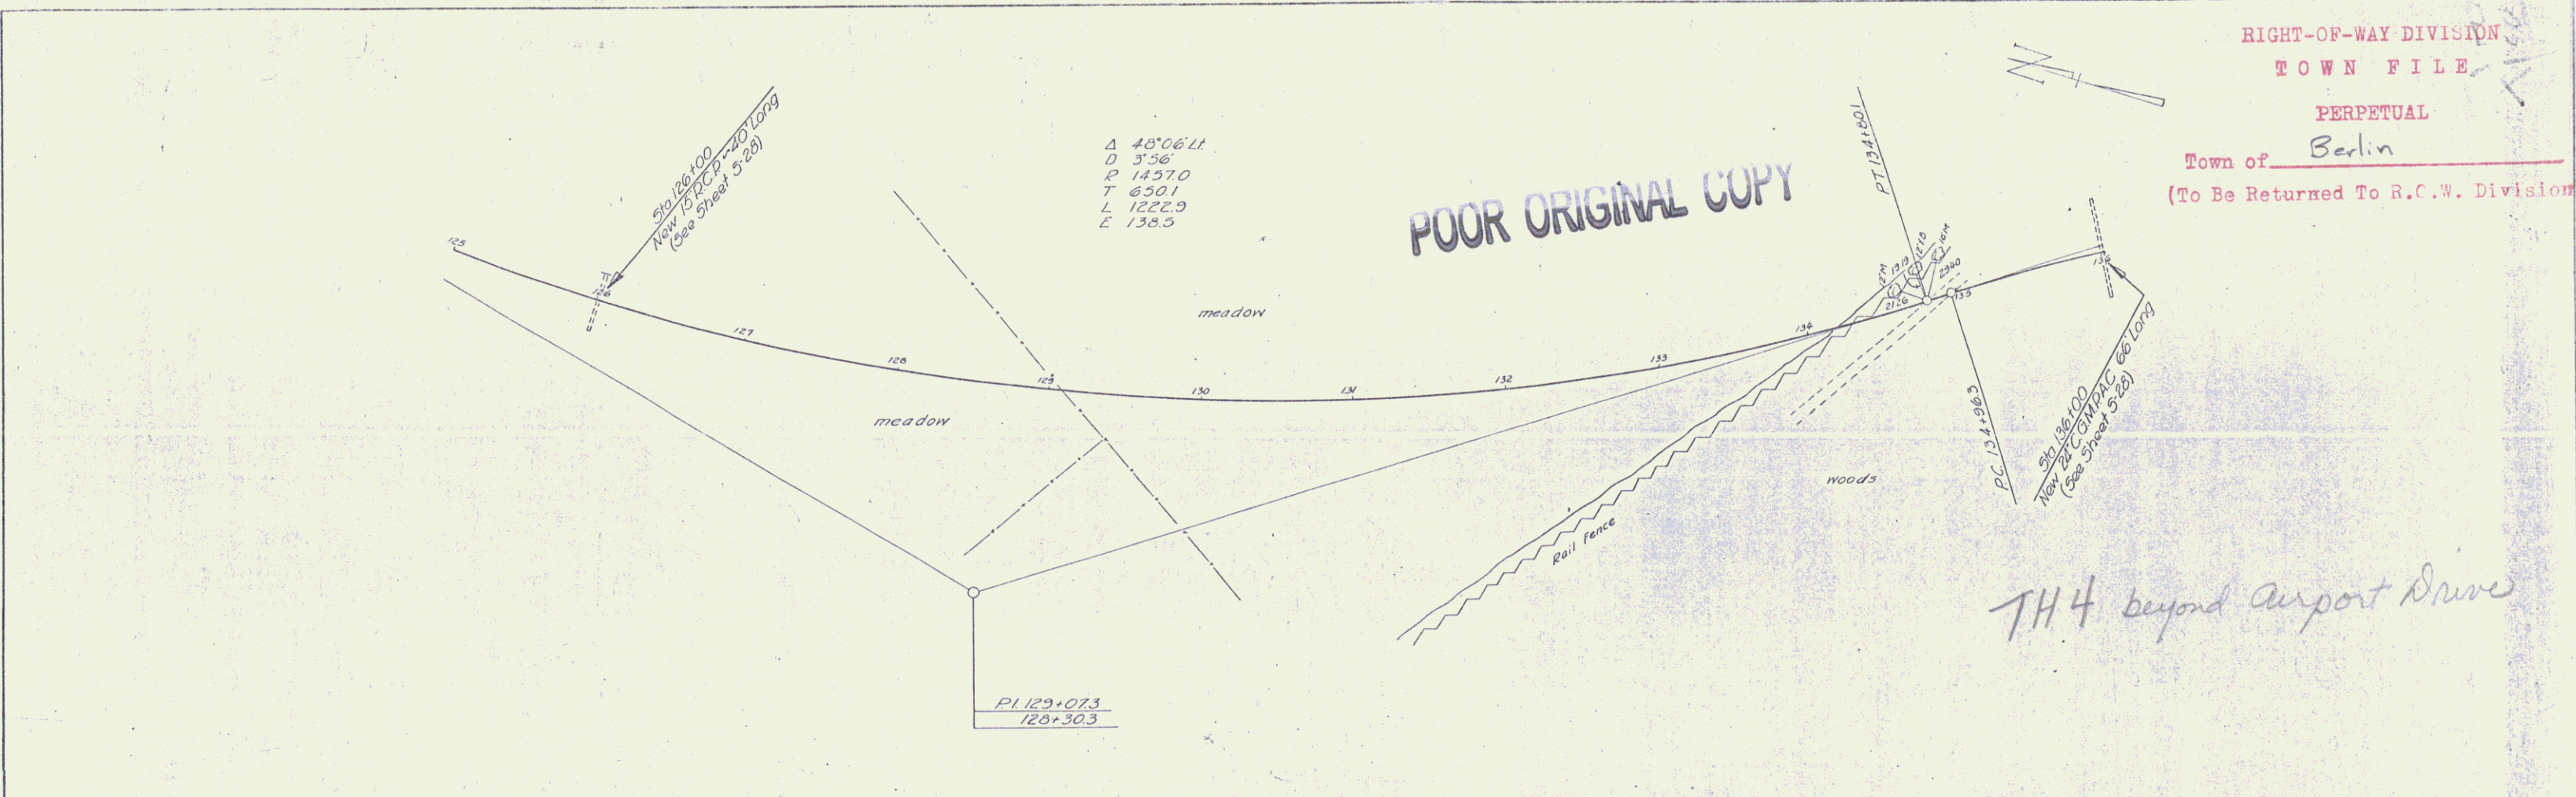

RIGHT-OF-WAY DIVISION
TOWN FILE
PERPETUAL
Town of Berlin
(To Be Returned To R.C.W. Division)

TH 4 beyond Airport Drive

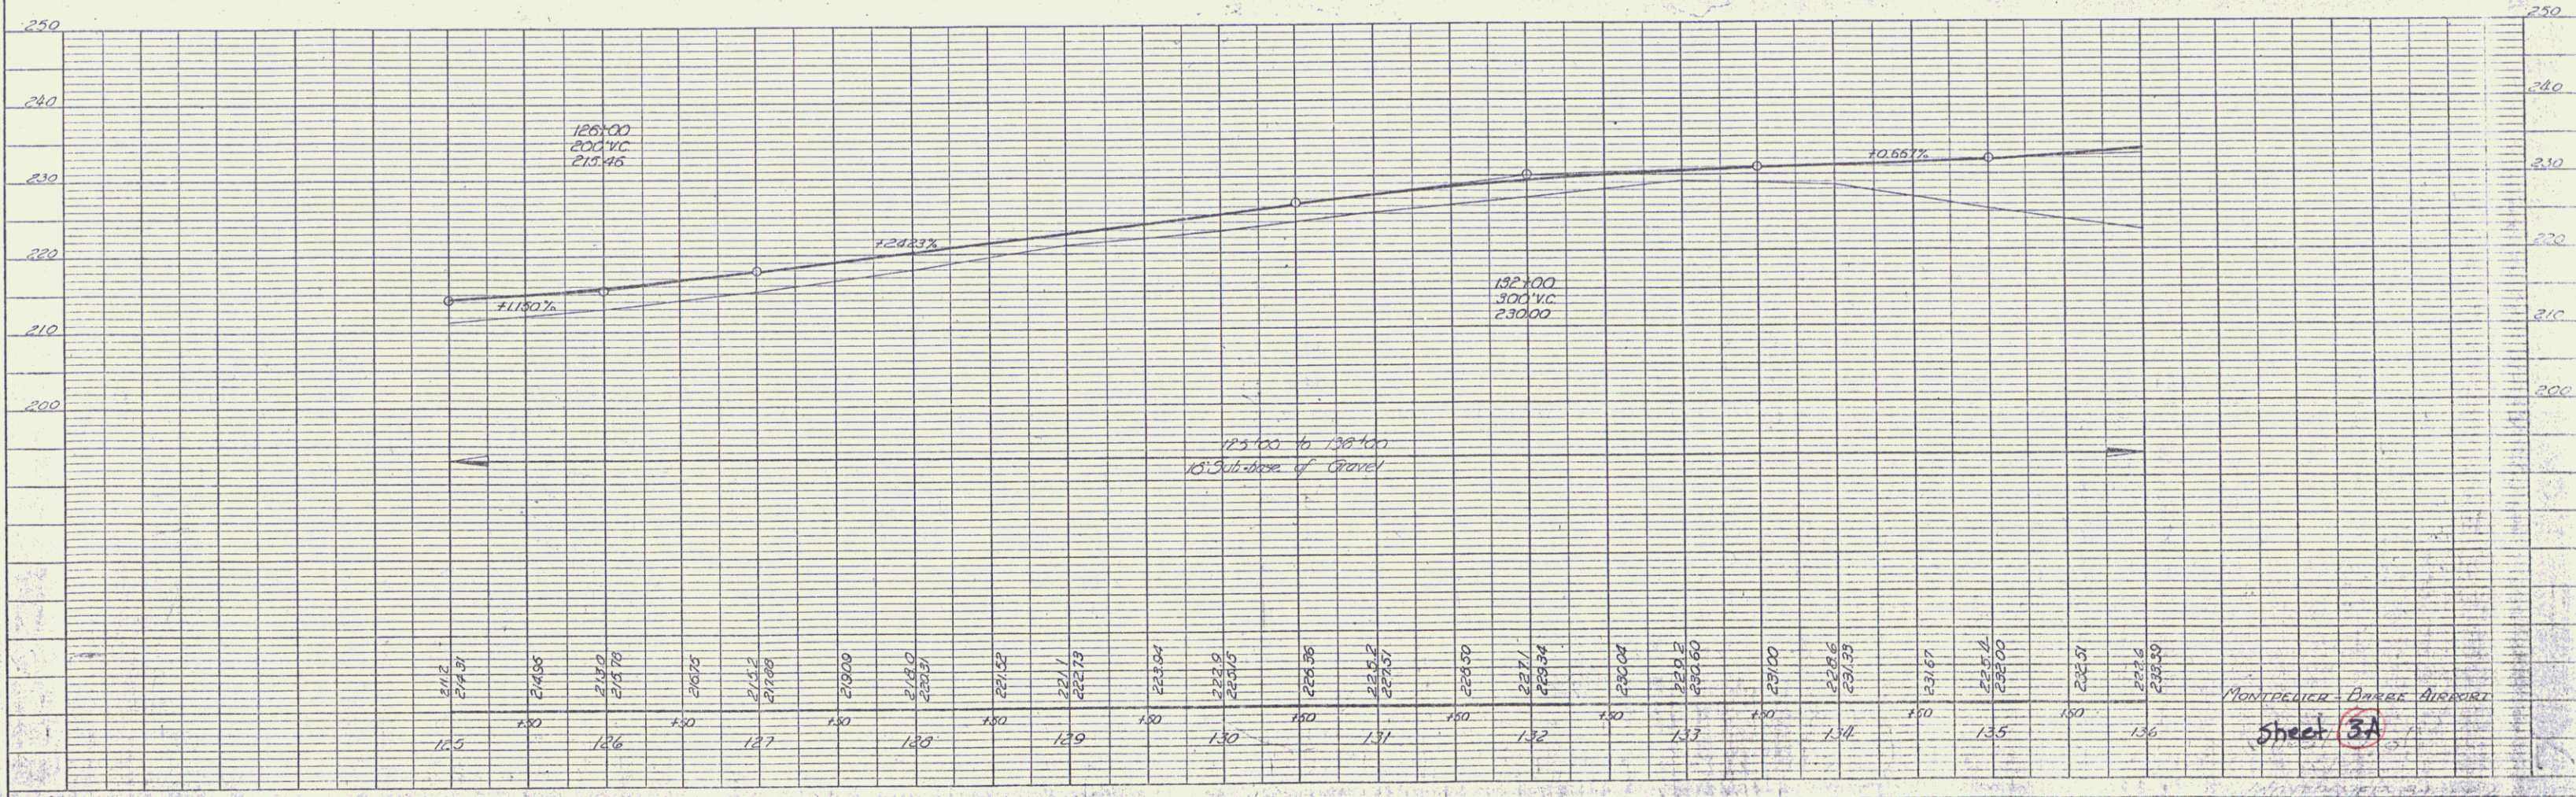

MONROE - BANK AIRPORT
Sheet 3A