
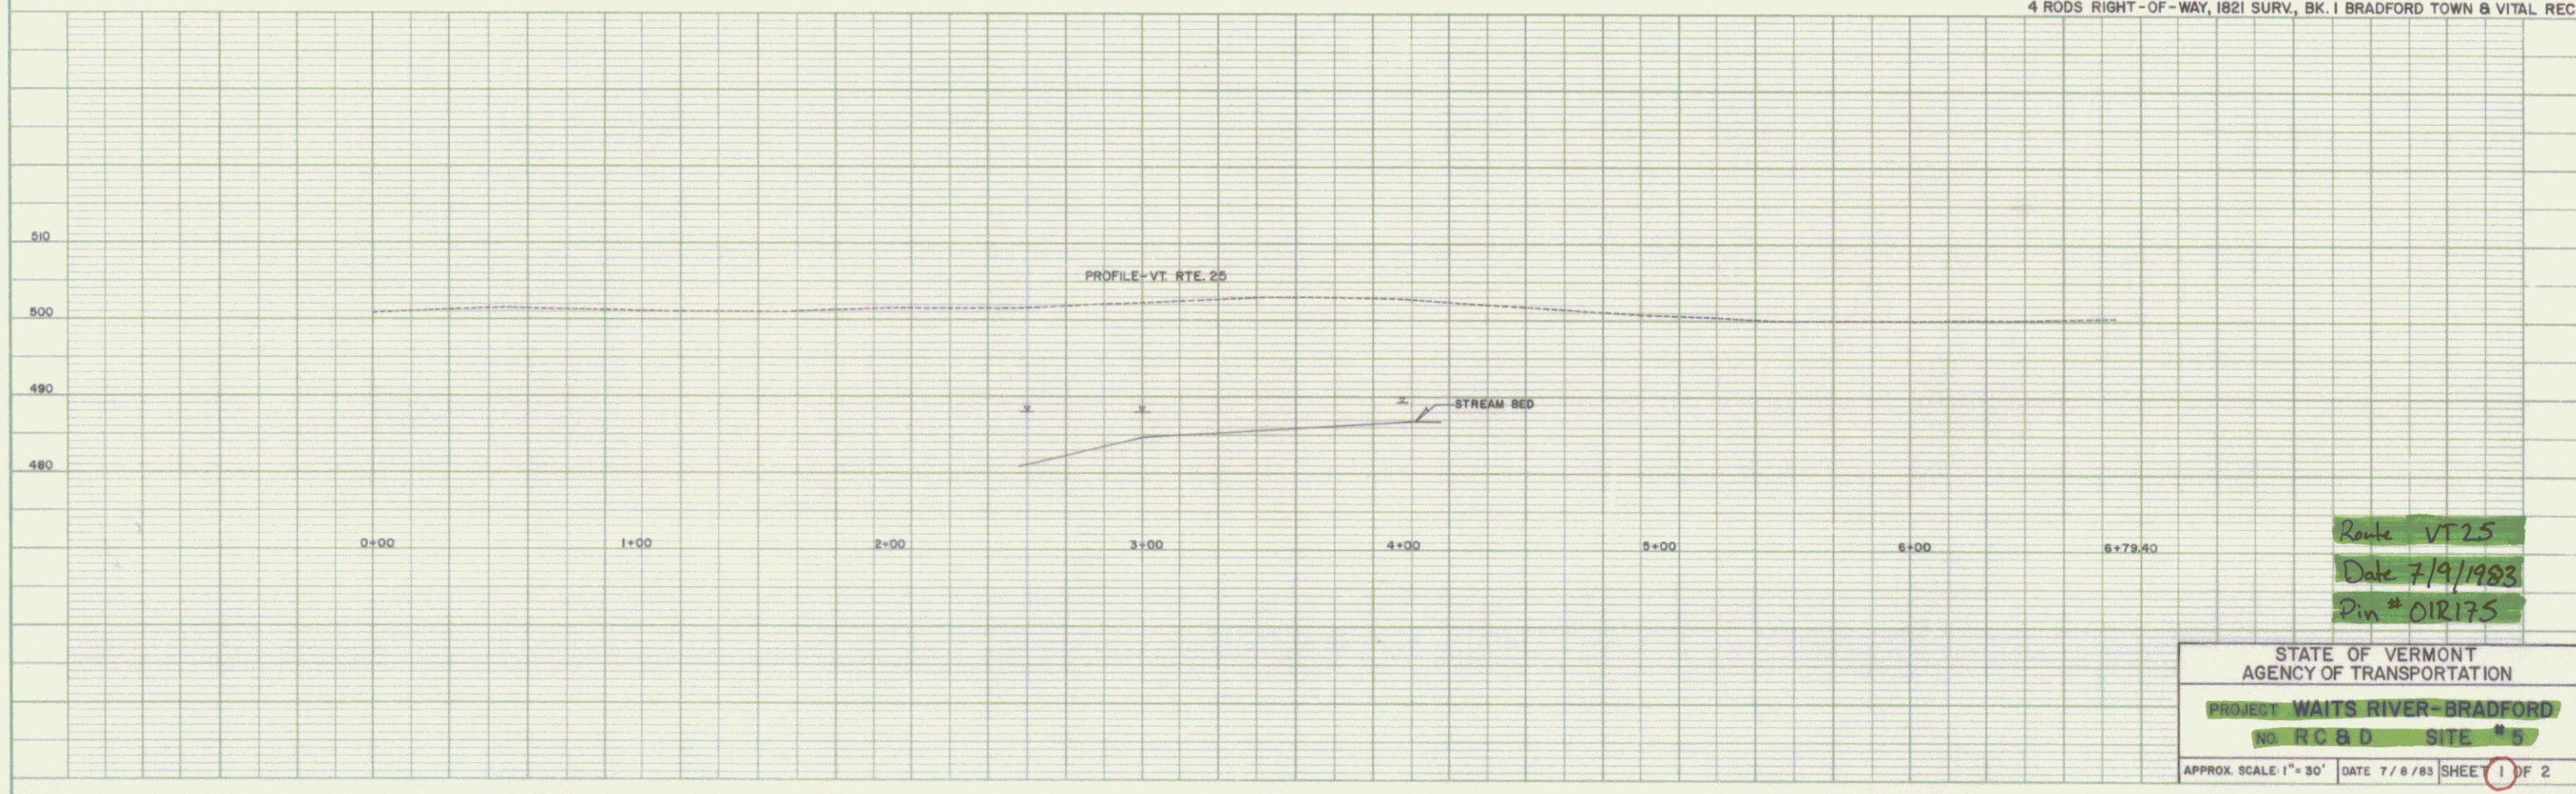


R.O.W. PLANS

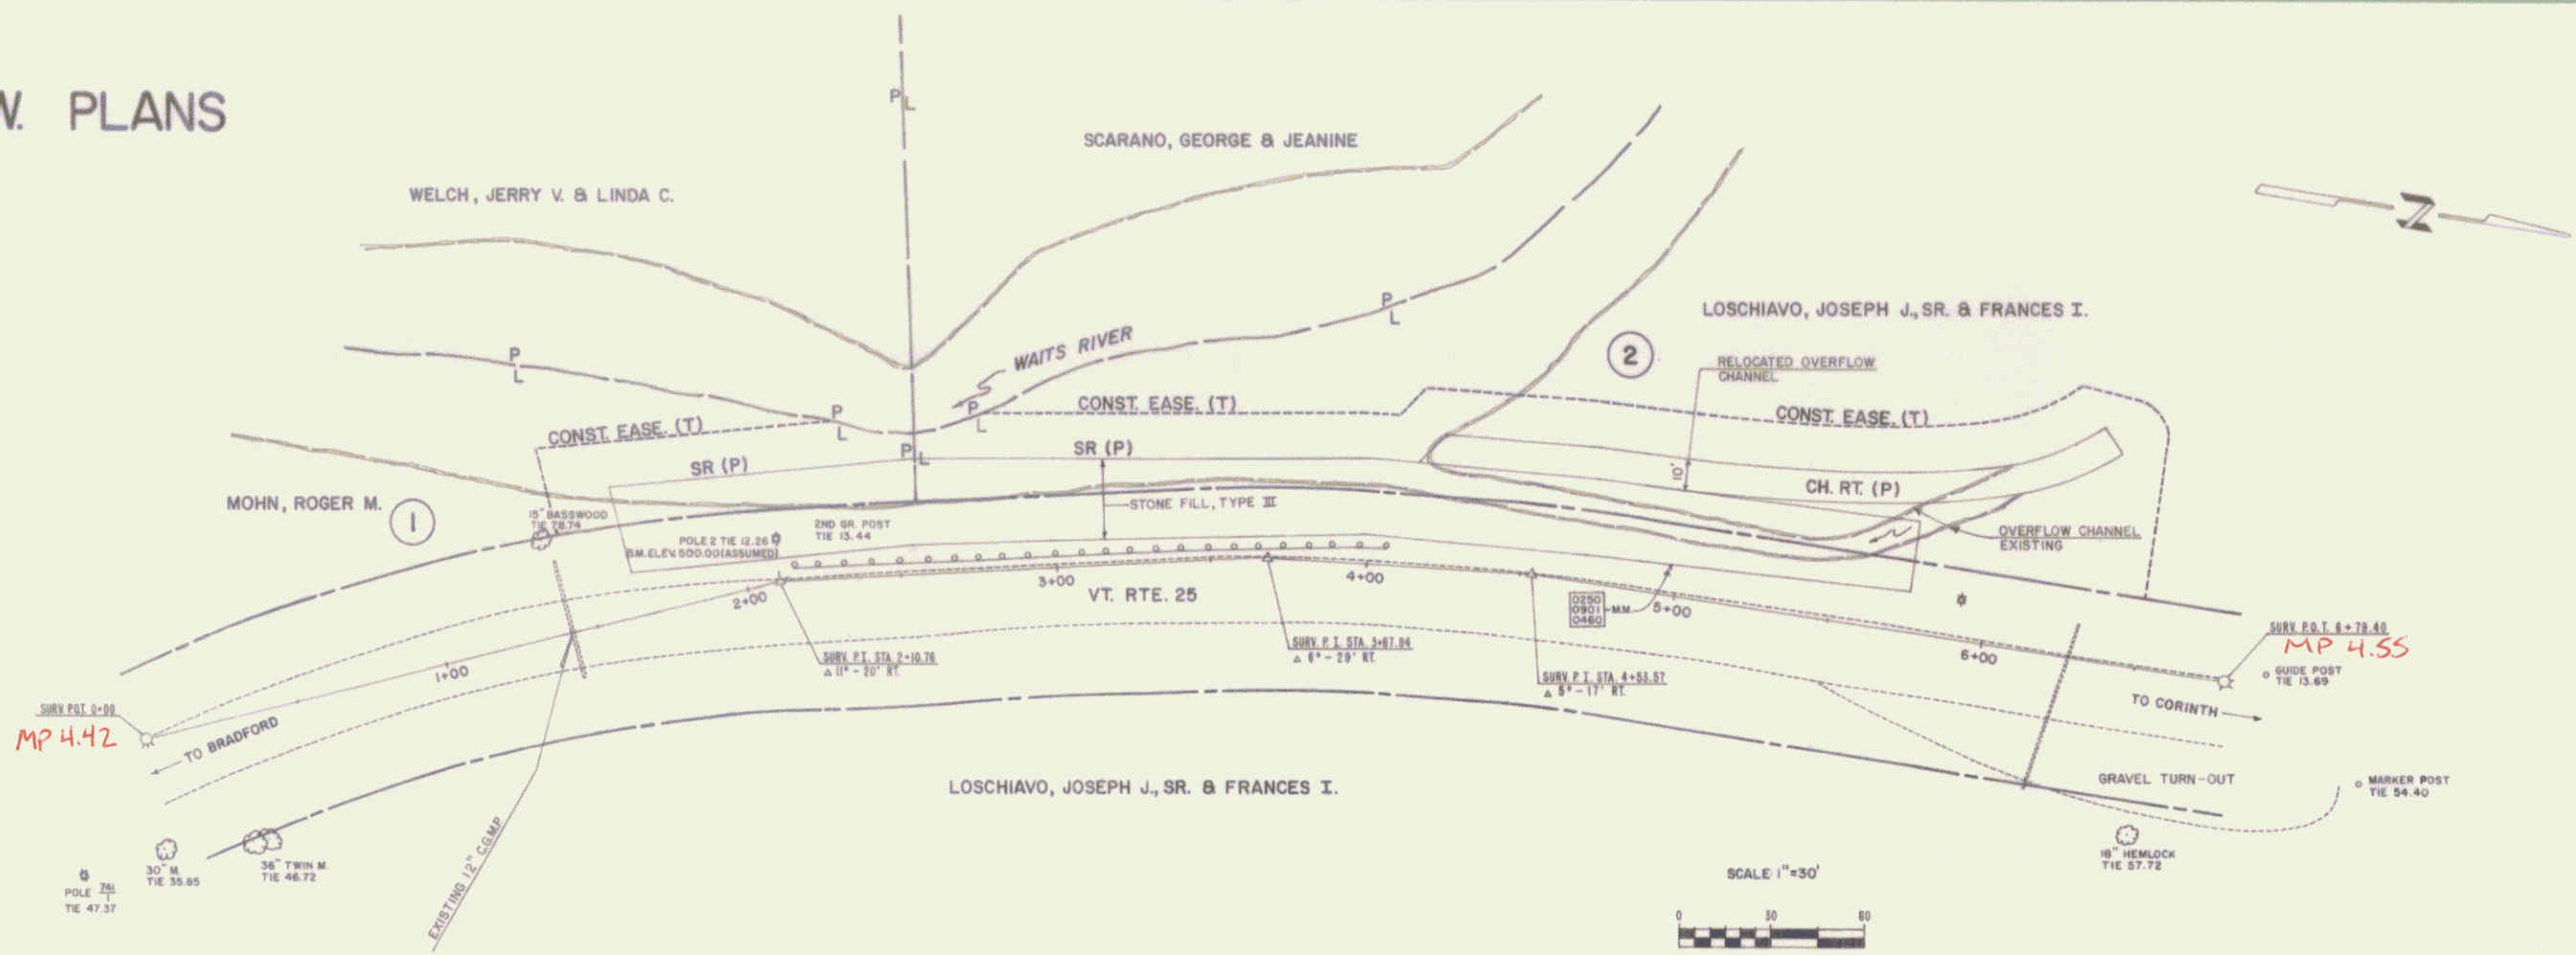

Route VT 25
 Date 7/9/1983
 Pin # 01R175

STATE OF VERMONT AGENCY OF TRANSPORTATION	
PROJECT: WAITS RIVER - BRADFORD	
NO. RC & D SITE # 5	
APPROX. SCALE: 1" = 30'	DATE 7/8/83 SHEET 1 OF 2