
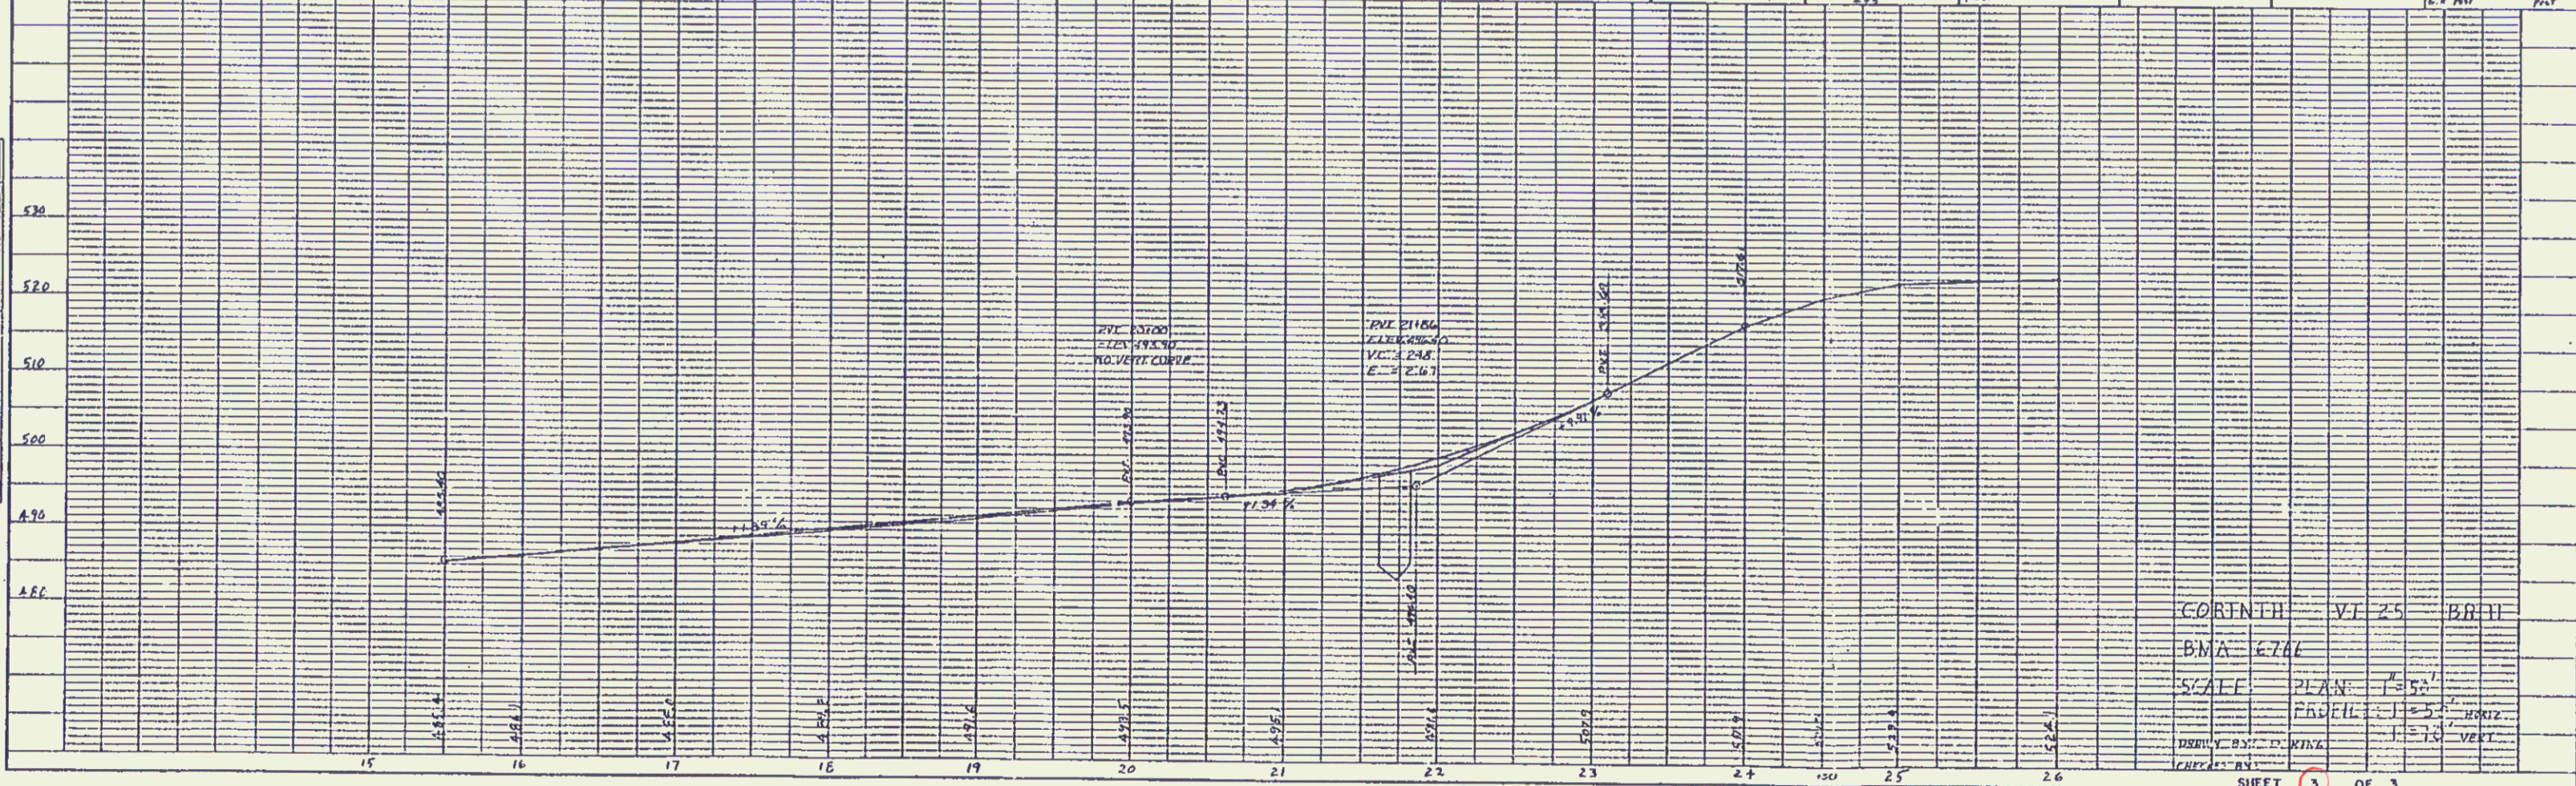
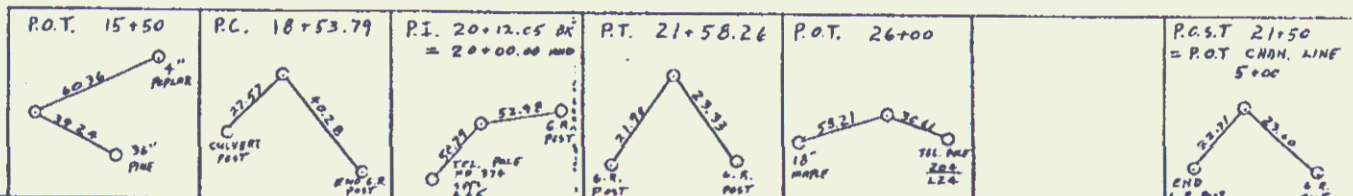


SURVEY CURVE DATA
 CURVE #1
 Δ 38° 31'
 D 12° 40'
 T 158.26
 L 304.47
 E 26.89
 PC. 18+53.79
 PT. 21+58.26
 PI. 20+12.05 BK.
 = 20+00.00 AND.

REVISED CURVE DATA
 Δ 41° 40' 24"
 D 12° 4'
 T 181.73
 L 347.28
 E 33.41
 PC. 18+38.21
 PT. 21+65.99 BK =
 21+01.25 AND
 PI. 20+19.94 BK =
 20+03.76 AND.
 BANK 0.070 %/ft

PLAN
 DRAWN BY: []
 CHECKED BY: []
 DATE: []

PROFILE
 DRAWN BY: []
 CHECKED BY: []
 DATE: []

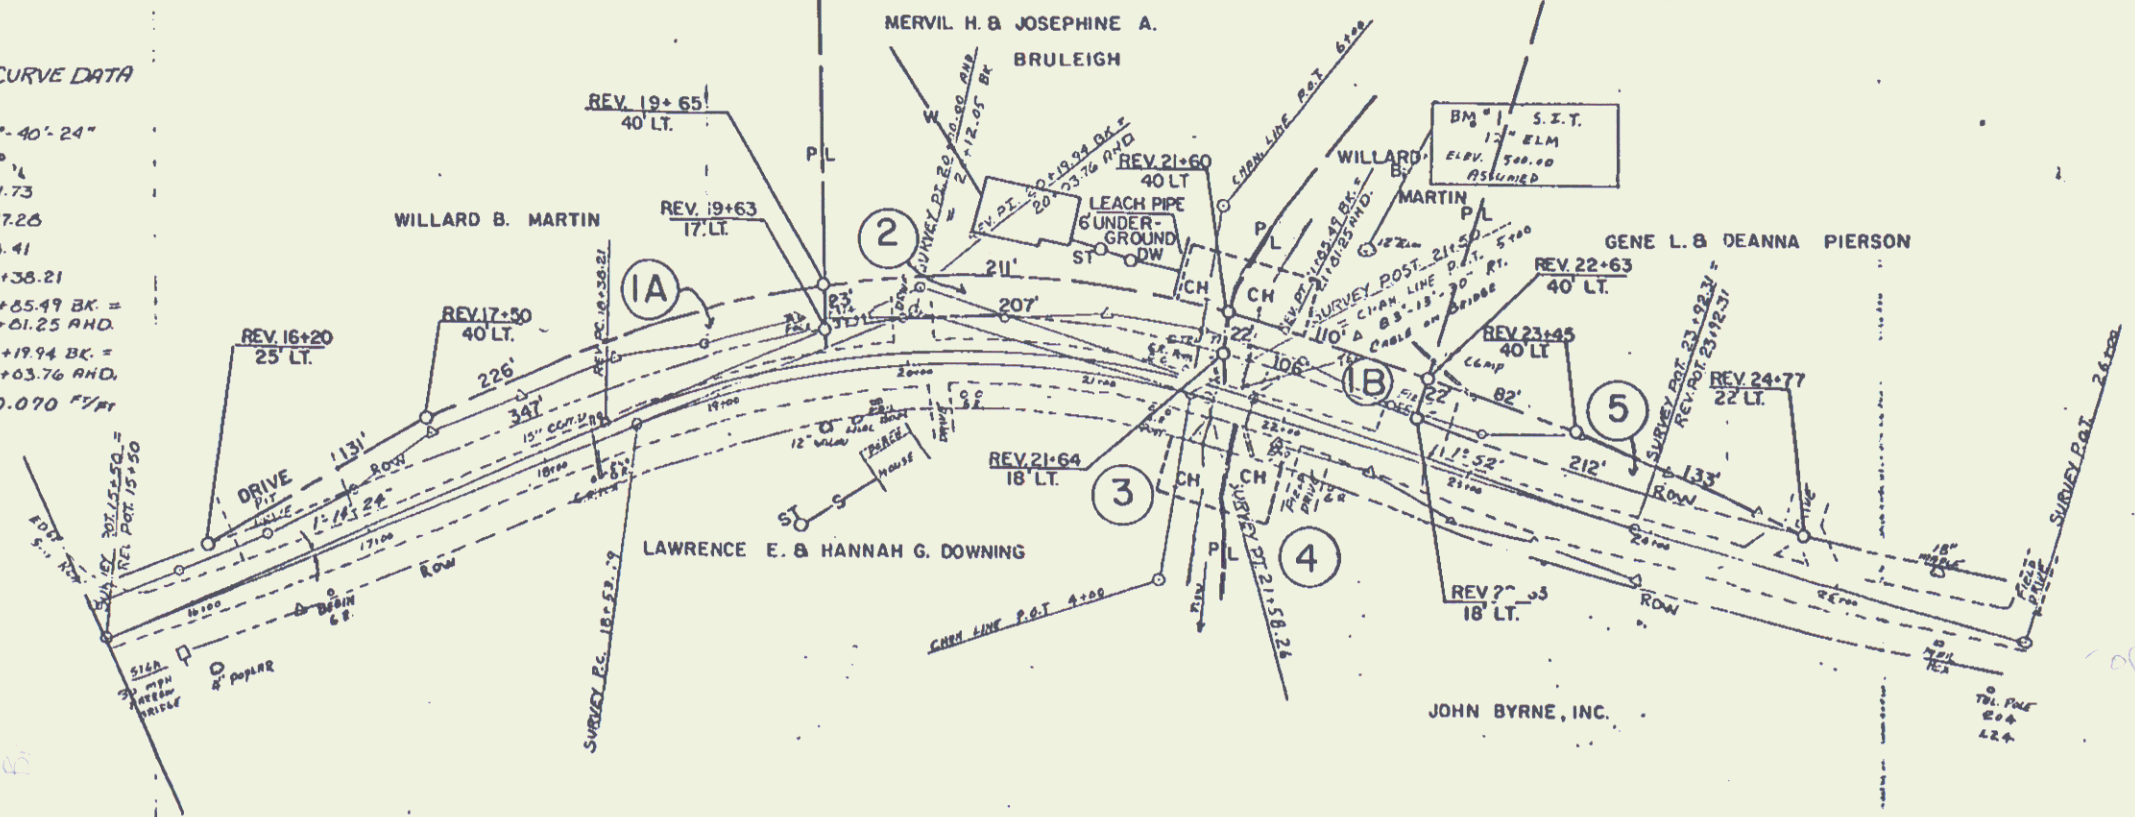

CORINTH VI 25 BR II
 B.M.A. 6761
 SCALE PLAN 1"=50'
 PROFILE 1"=5' VERT
 SHEET 3 OF 3

PLATE 1, PLAN-PROFILE
 KE
 48 7064 HERCULENE®

ADD 04 1077