

INDEX OF SHEETS	
SHEET NO.	DESCRIPTION
1	TITLE PAGE
2	TYPICAL CROSS-SECTION OF IMPROVEMENT
3	QUANTITY SHEET (ITEMS)
4	EARTHWORK SHEET (ROADWAY)
5	PRELIMINARY INFORMATION SHEET
6-7	PLAN AND PROFILE SHEET SHEETS
8	DETAILS OF SUPERSTRUCTURE
9	DETAILS OF ABUTMENT NO. 1
10	DETAILS OF ABUTMENT NO. 2
11	DETAILS OF REINFORCING STEEL
12	STANDARD BRIDGE SHEET SB-55-1 (BRIDGE RAILING DETAILS)
13	STANDARD BRIDGE SHEET SB-50-20 (DETAILS C, D, E, H, J, K AND L)
14	STANDARD STRUCTURE SHEET SB-11 (BARRICADES, SIGNS AND LIGHTS)
15	STANDARD STRUCTURE SHEET S-48-46 (THREE CABLE GUARD RAIL)
16	CONSTRUCTION DETAILS (C-D) DRAINAGE AND MARKERS
17	CONSTRUCTION DETAILS (C-D-1) DITCHES
18-22	CROSS SECTIONS
23-25	CHANNEL SECTIONS

STATE OF VERMONT DEPARTMENT OF HIGHWAYS

PROPOSED IMPROVEMENT



FEDERAL AID
SECONDARY PROJECT

TOWN OF FAIRFIELD COUNTY OF FRANKLIN STATE AID ROUTE 2 BRIDGE OVER FAIRFIELD RIVER

BEGINNING AT A POINT APPROXIMATELY 0.20 MI. EAST OF THE INTERSECTION OF STATE AID ROUTES 2 AND 3 AND EXTENDING 350.0 FEET EASTERLY

LENGTH OF ROADWAY 261.0 FEET+0.049 MILE
LENGTH OF BRIDGE 89.0 FEET+0.017 MILE
LENGTH OF PROJECT 350.0 FEET+0.066 MILE

PROJECT MAP NO. 5-53(7)
FAIRFIELD-5-53(7)
 CONSTRUCTION OF BRIDGE OVER FAIRFIELD RIVER
 CONTRACTOR: OSCAR L. OLSON
 CONTRACT STARTED: JULY 20, 1954
 CONTRACT COMPLETED: MAY 31, 1955
 CONTRACT ACCEPTED: MAY 31, 1955

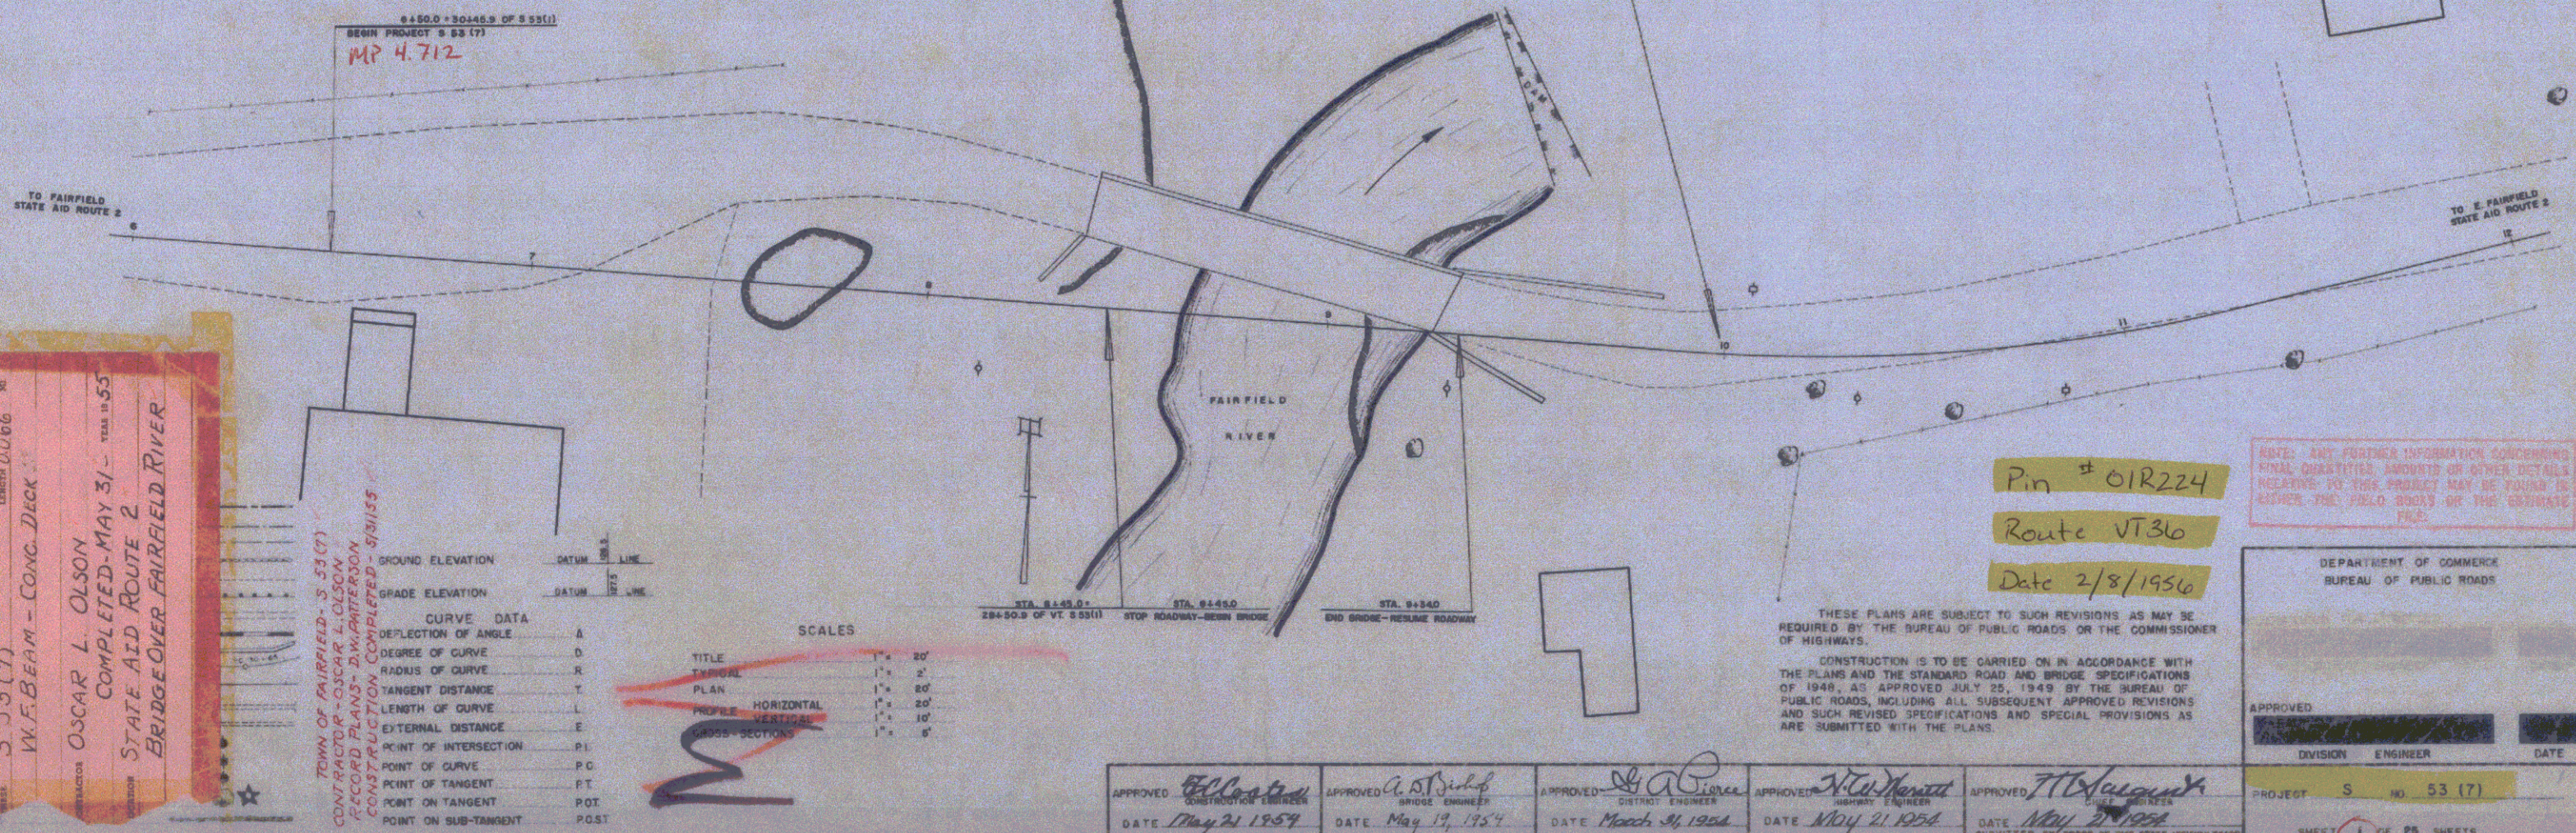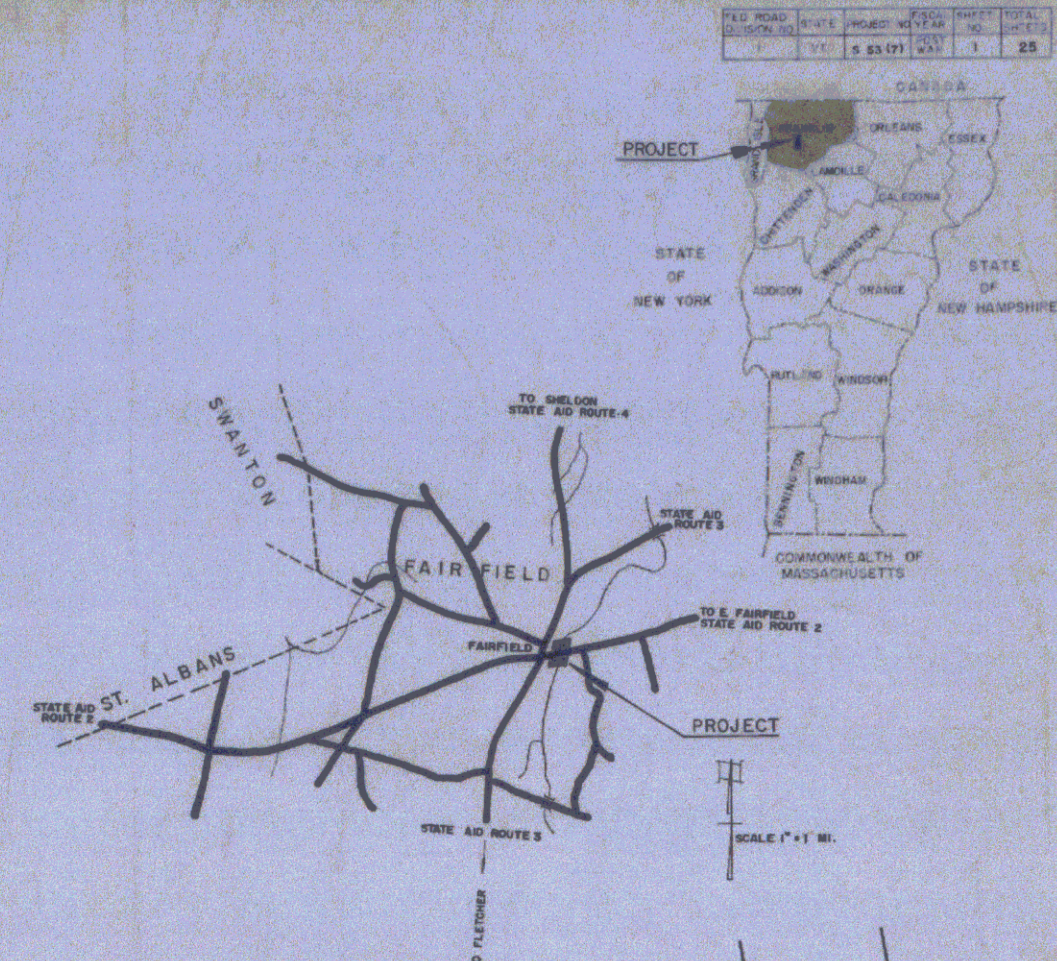

FAIRFIELD
5-53(7)
YK.F.B.E.A.M. - CONC. DIK.
OSCAR L. OLSON
COMPLETED-MAY 31, 1955
STATE AID ROUTE 2
BRIDGE OVER FAIRFIELD RIVER

TOWN OF FAIRFIELD-5-53(7)	
CONTRACTOR-OSCAR L. OLSON	
RECORD PLANS-DIVISION OF HIGHWAYS	
CONSTRUCTION COMPLETED 5/31/55	
DATE 2/8/1956	
PIN # 01R224	
ROUTE VT36	
DATE 2/8/1956	
PIN # 01R224	
ROUTE VT36	
DATE 2/8/1956	

CURVE DATA	
DEFLECTION OF ANGLE	A
DEGREE OF CURVE	D
RADIUS OF CURVE	R
TANGENT DISTANCE	T
LENGTH OF CURVE	L
EXTERNAL DISTANCE	E
POINT OF INTERSECTION	P.I.
POINT OF CURVE	P.C.
POINT OF TANGENT	P.T.
POINT ON SUB-TANGENT	P.O.T.

APPROVED		APPROVED		APPROVED		APPROVED		APPROVED	
DATE	May 21, 1954	DATE	May 19, 1954	DATE	March 26, 1954	DATE	May 21, 1954	DATE	May 21, 1954
SHEET 1 OF 25 SHEETS		PROJECT S NO. 53 (7)		DIVISION ENGINEER		DATE		SUBMITTED BY ORDER OF THE STATE HIGHWAY BOARD	