


PLAN
 SCALE 1" = 40'
 DATE 12/19/45
 DRAWN BY [illegible]

PROFILING
 SCALE 1" = 10'
 DATE 12/19/45
 DRAWN BY [illegible]

PARCEL	INSTRUMENT	DATE	GRANTOR	GRANTEE	RECORDED	REMARKS
#					BOOK PAGE DATE	
# 1 A,B,C	W.D.O.E.	9-23-46	PHILLIP & ORISE LE BLANC	ST OF VT.	21 128 10-10-45	
# 2 A,B,C	W.D.O.E.	10-22-46	ALFRED & JESSIE BEDARD	" "	21 140 11-16-46	#2B+C ON 34' S

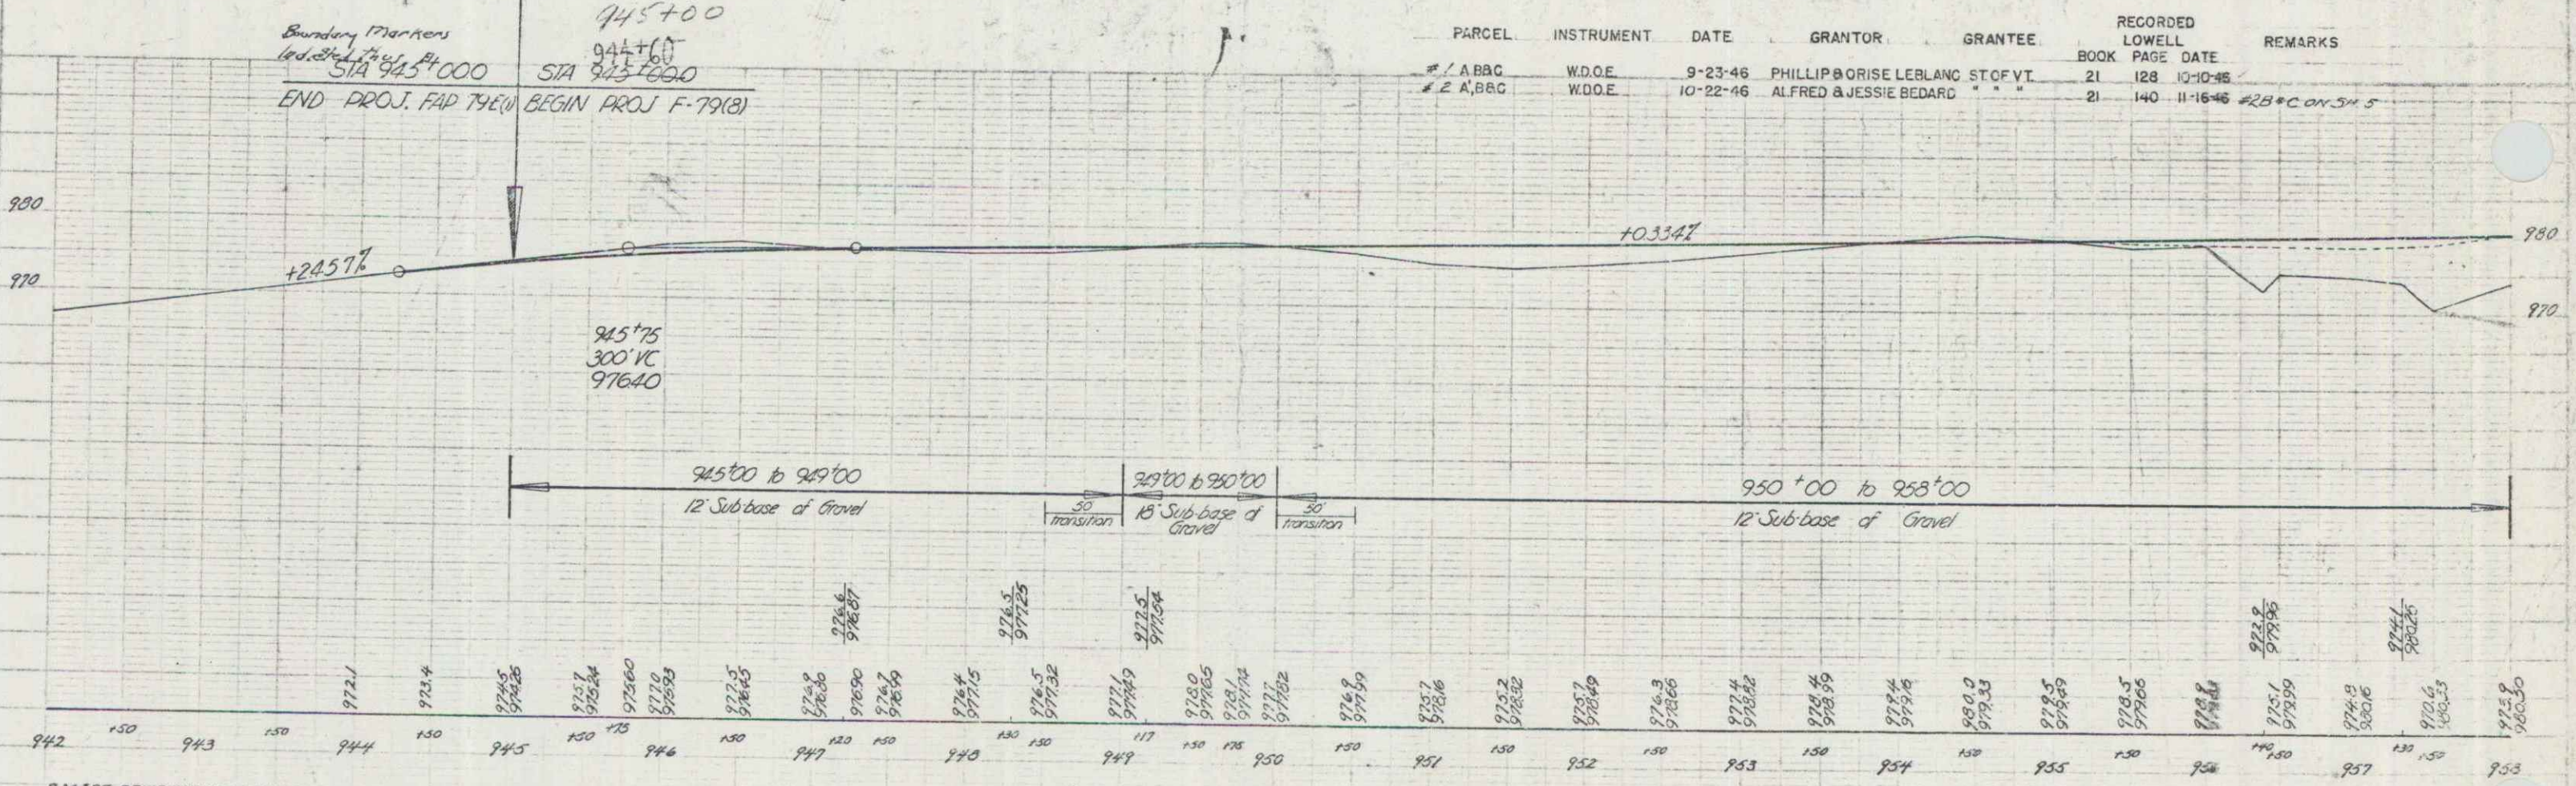

B.M. 97 SPIKE IN ROOT 2 1/2" MAPLE 2 1/2" RT STR 946+70 ELEV 978.21
 B.M. 98 " " " 1 1/2" PINE 10' RT STR 954+72 ELEV 981.44

LOWELL F 79(B)
 Sheet 4 of 117 Sheets