



79(8) 1946 5 117

Spaulding 9403
TOSCO Bulky 1285

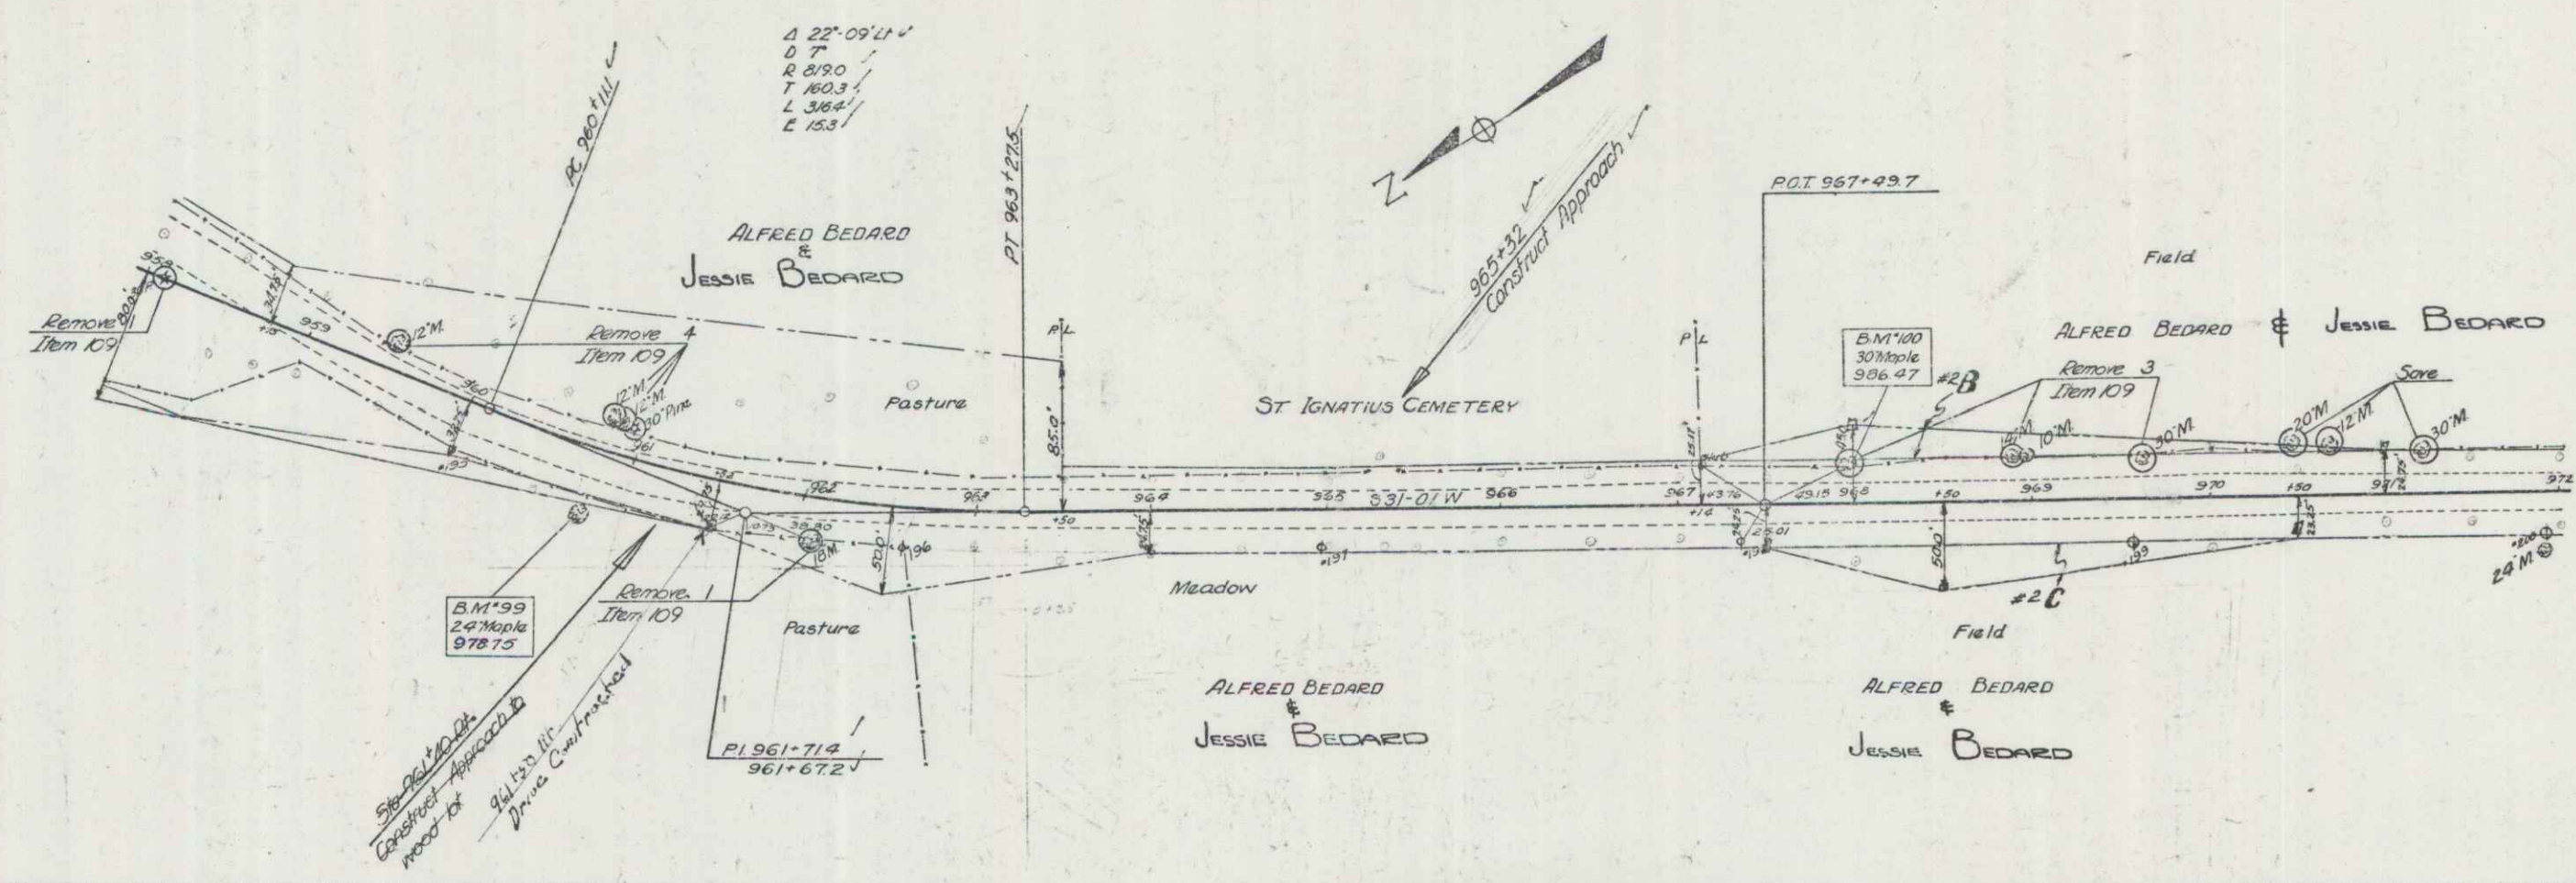

Spaulding 11145

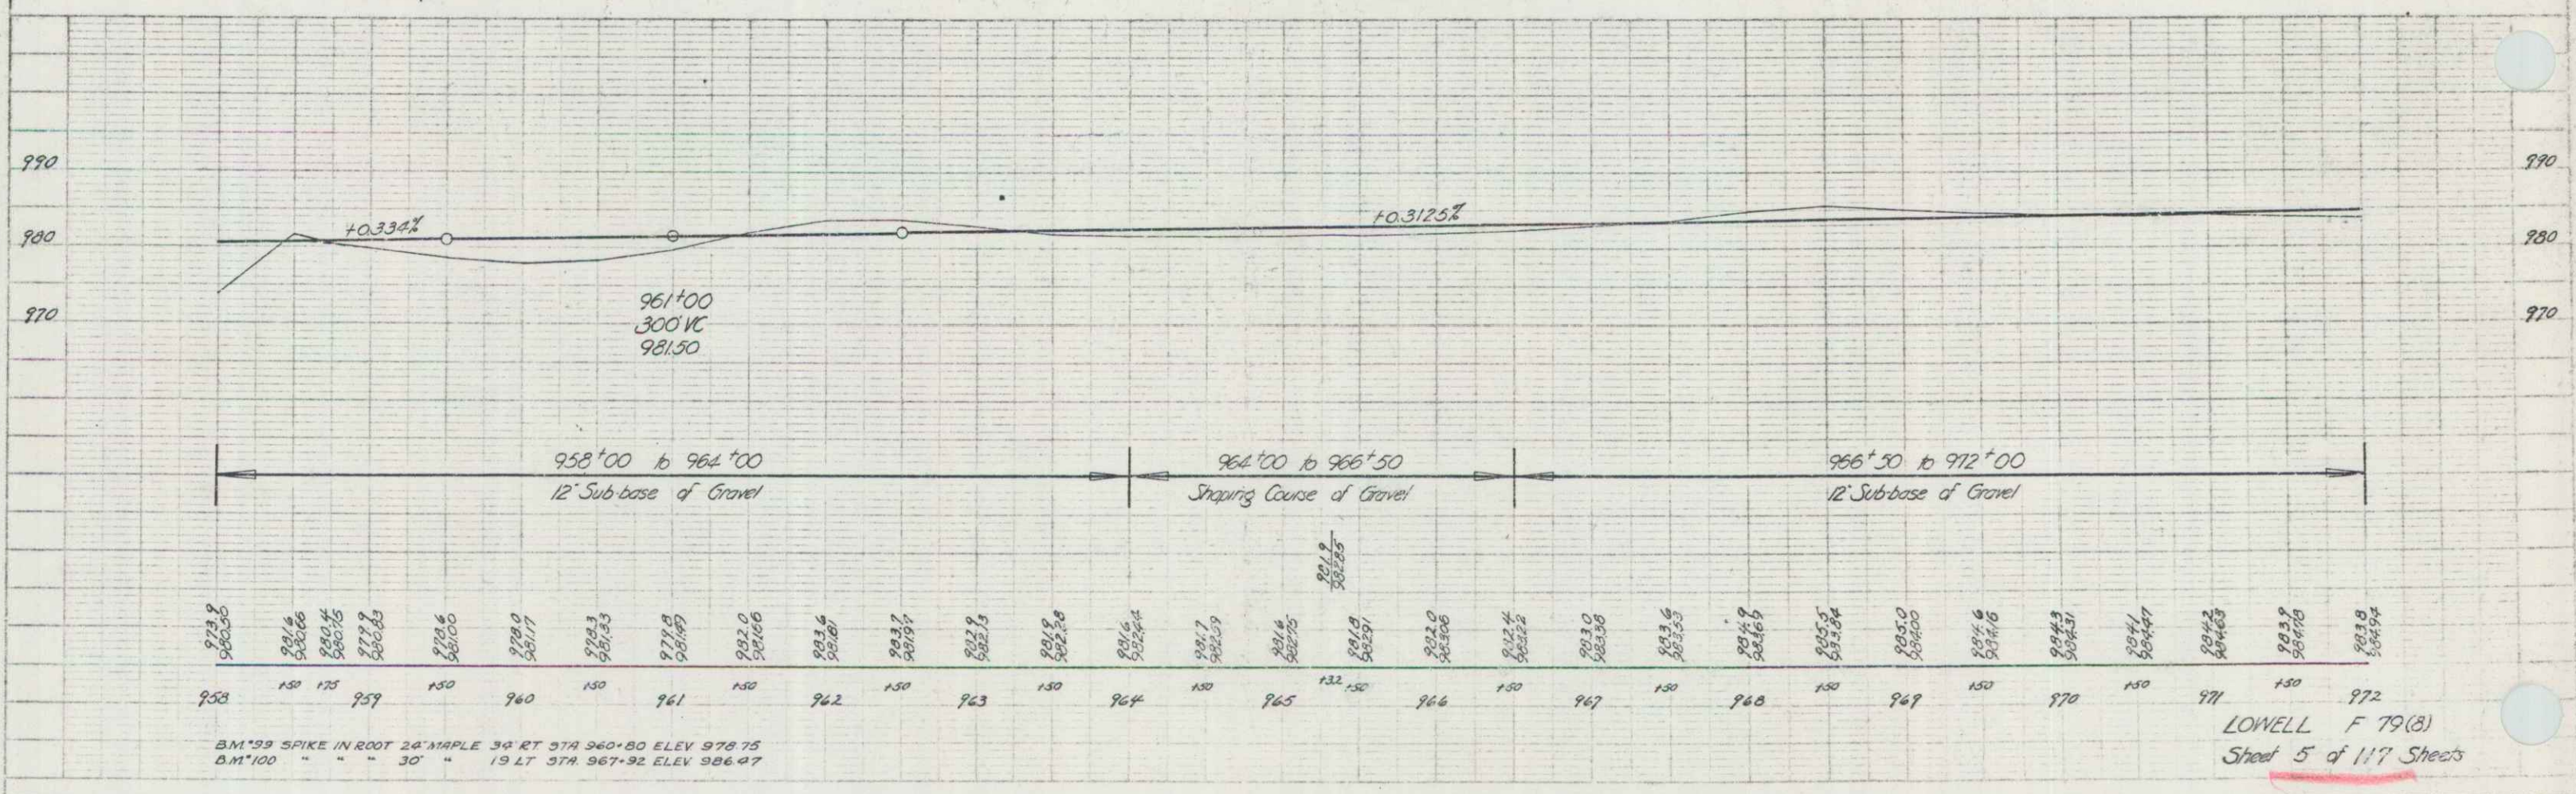

B.M. 99 SPIKE IN ROOT 26' MAPLE 34' RT 97A 960+80 ELEV 976.75
B.M. 100 " " " 30' " 19' LT 97A 967+92 ELEV 986.47

LOWELL F 79(8)
Sheet 5 of 117 Sheets