
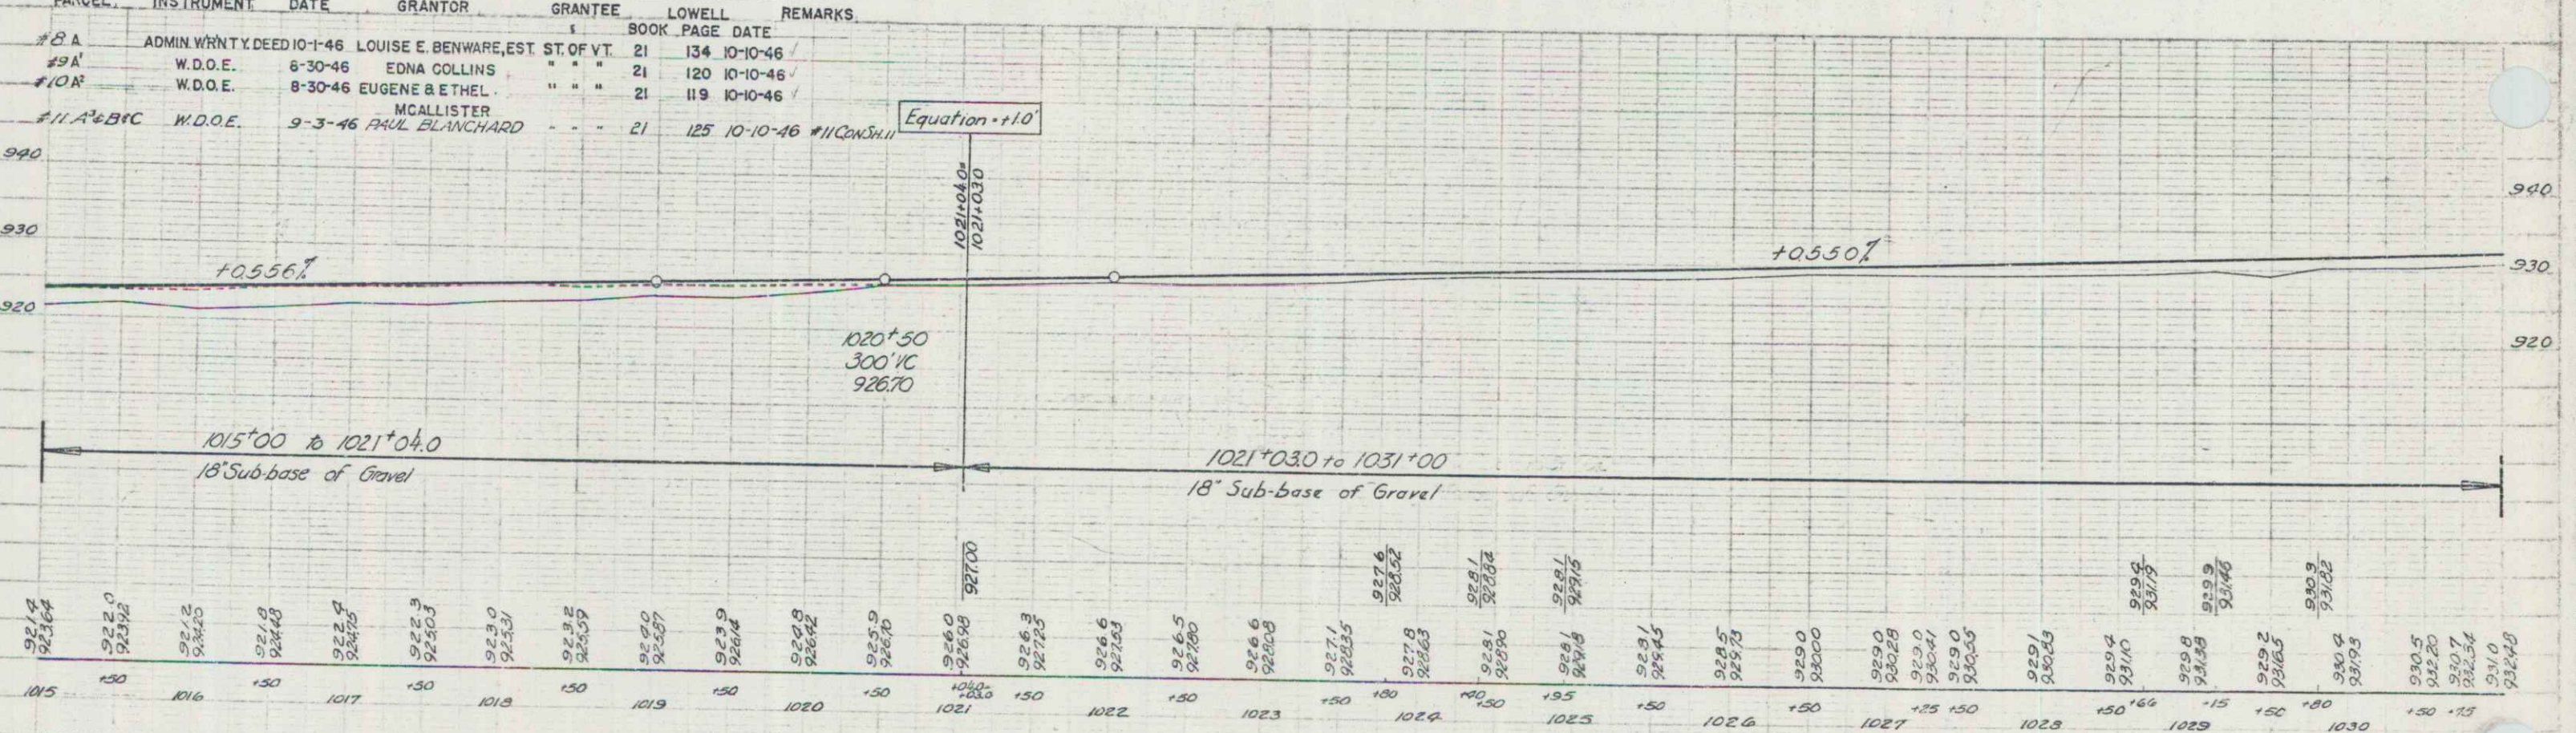


PLAN
 DATE: 12/95
 DRAWN BY: [illegible]
 CHECKED BY: [illegible]

Profile
 DATE: 1/05
 DRAWN BY: [illegible]
 CHECKED BY: [illegible]

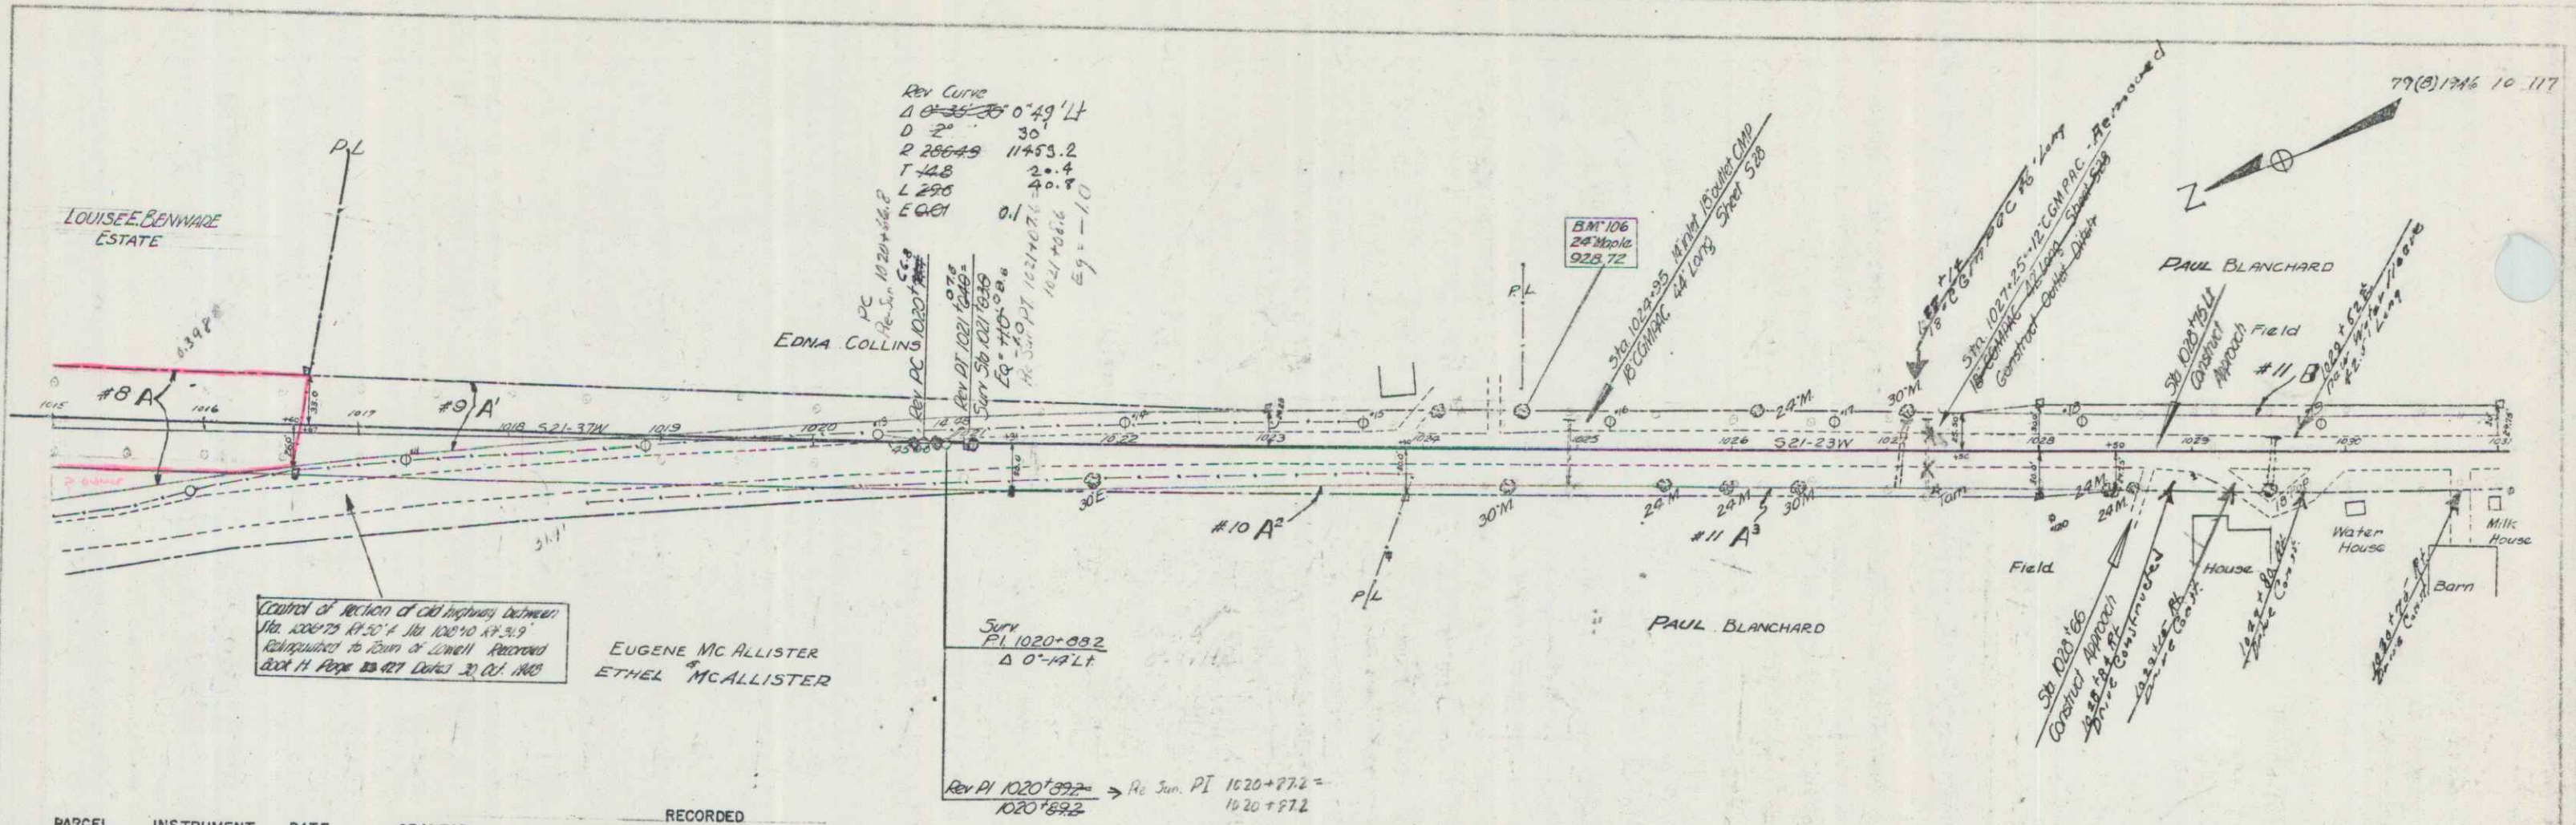

LOWELL F 79(B)
 Sheet 10 of 117 Sheets