



PLAN
 DRAWN BY
 CHECKED BY
 DATE
 9/63
 Spaulding
 11/45

PROFILE
 DRAWN BY
 CHECKED BY
 DATE
 9/63
 Spaulding
 11/45

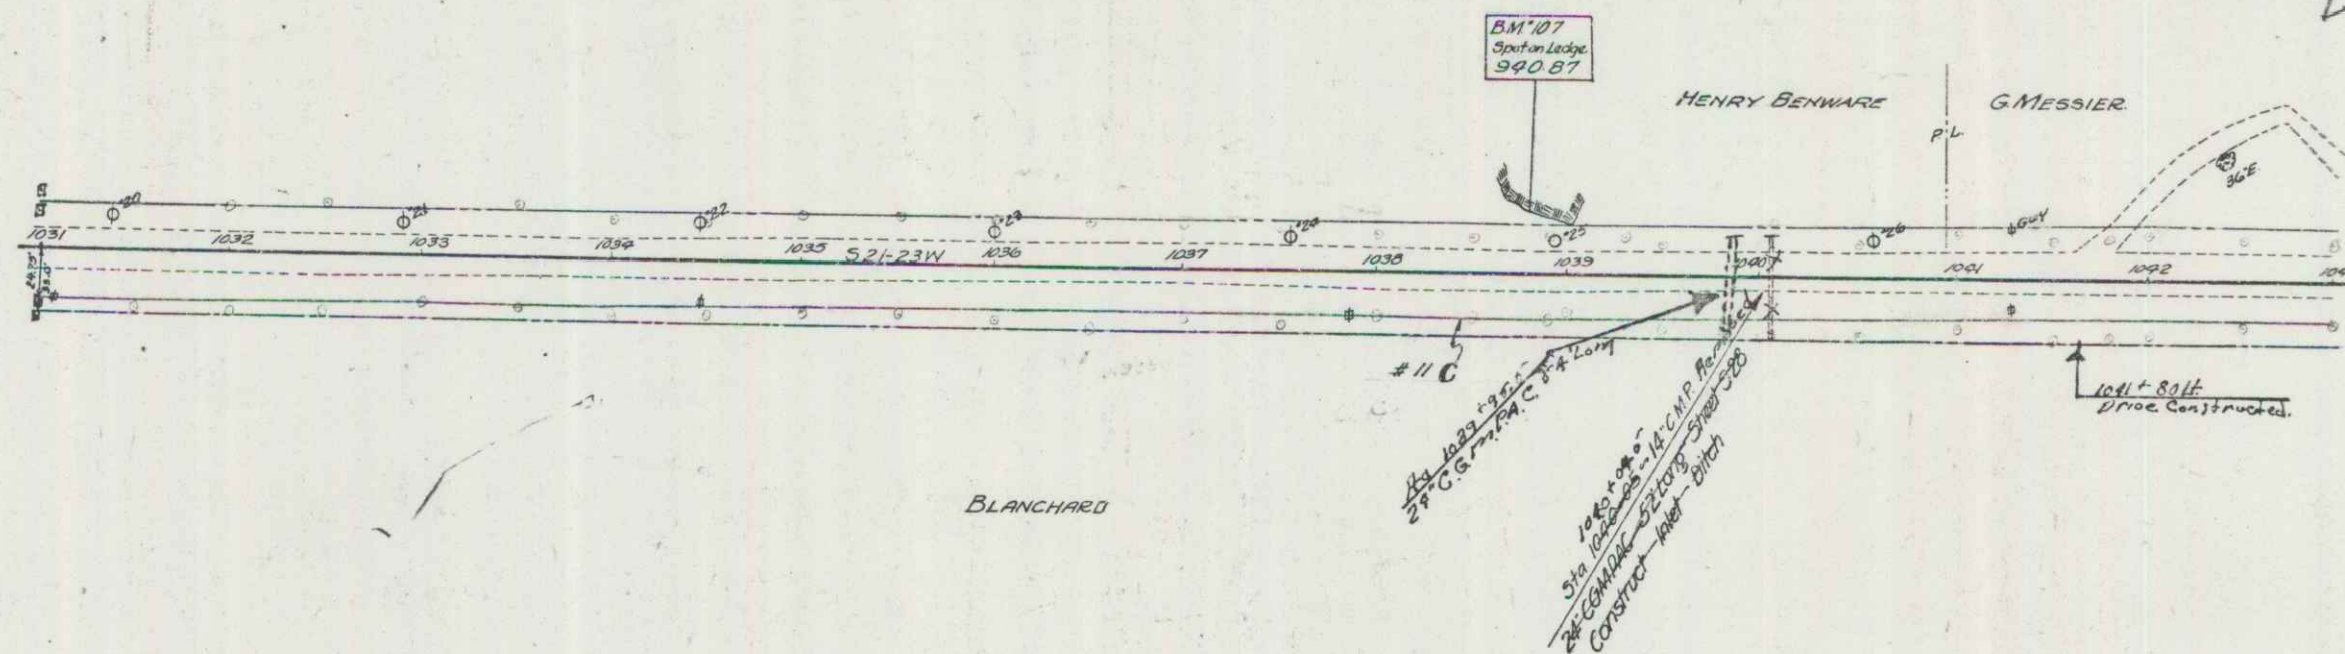

PARCEL	INSTRUMENT	DATE	GRANTOR	GRANTEE	RECORDED	REMARKS
# 11	A.B.C.	W.D.O.E.	9-3-46	PAUL BLANCHARD ST OF VT. 21	BOOK 125 PAGE 10-10-46	LOWELL F 79(B) 11/45

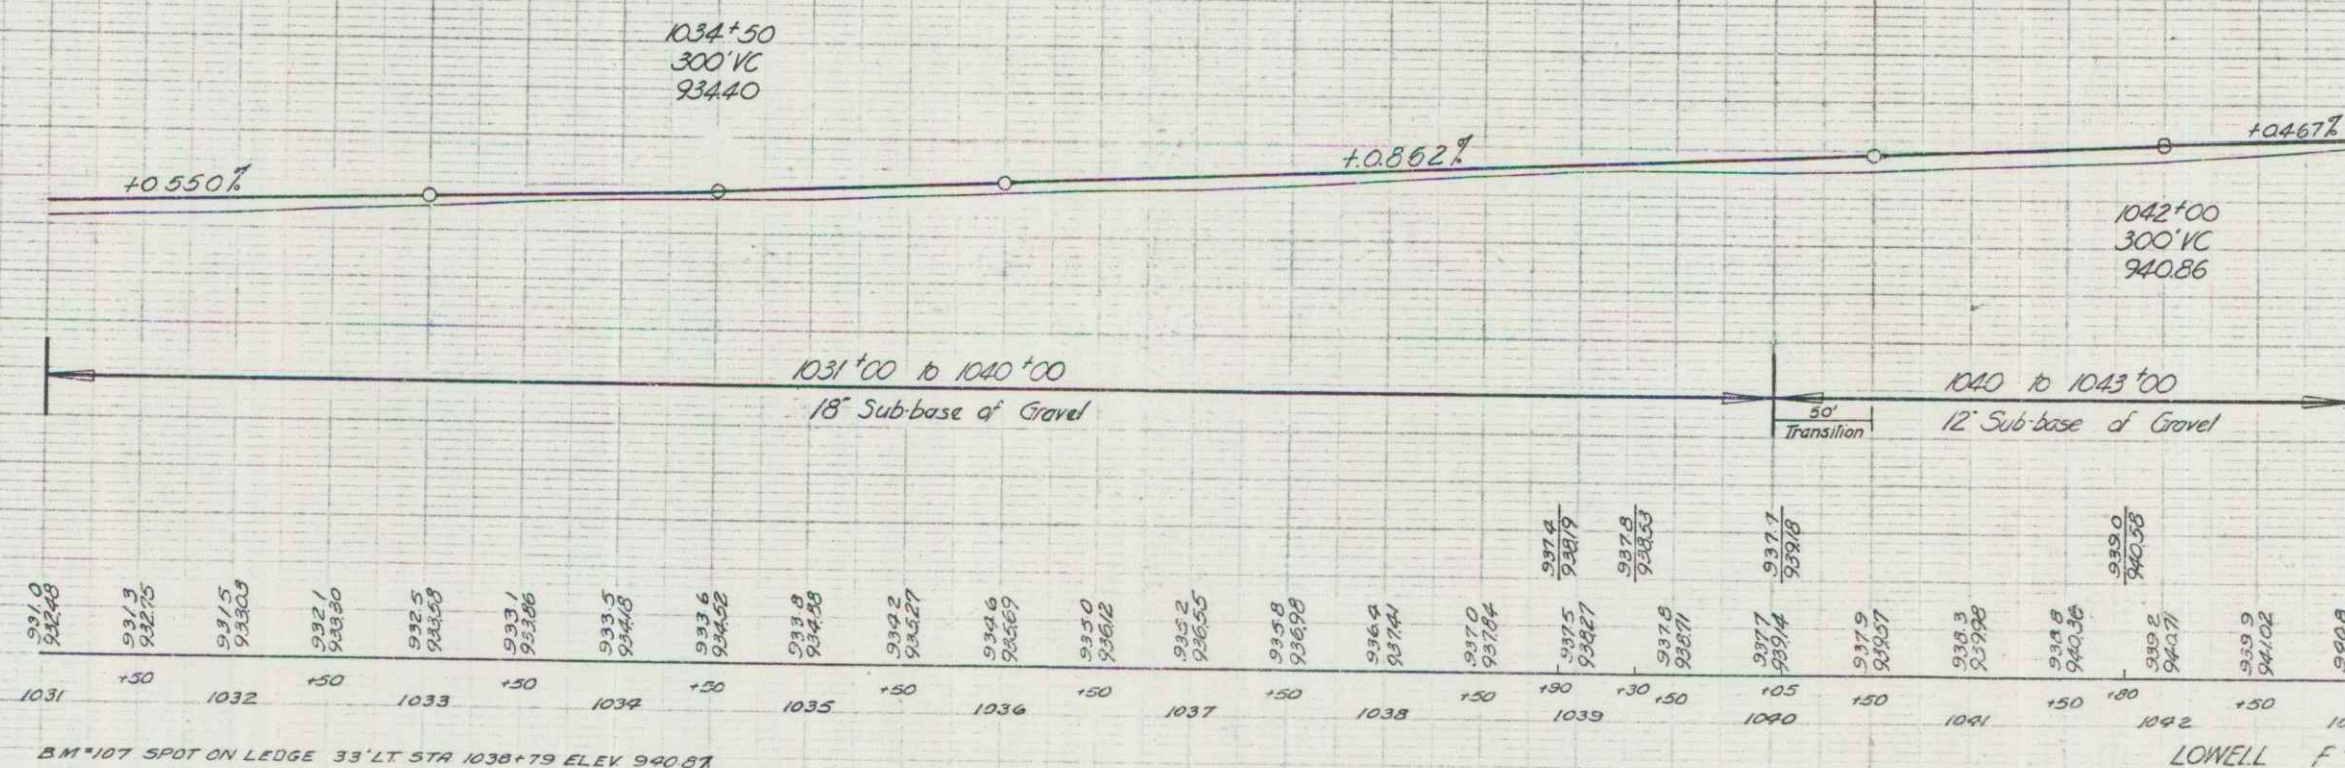

LOWELL F 79(B)
 Sheet 11 of 117 Sheets