

BRIDGE DATA


NEW CONSTRUCTION		OLD	
Type	Conc T-Bm	Type	Conc T-Bm
Overall Span	33'-0"	Overall Span	33'-0"
Clear Span	30'-0"	Clear Span	30'-0"
Clear Height	8'-0"	Clear Height	8'-0"
Roadway Width	12'-0"	Roadway Width	12'-0"
Waterway	12'-0"	Waterway	12'-0"
stream data		stream data	
Velocity		Velocity	
Drift		Drift	
Ice Conditions		Ice Conditions	

Sta 1043+89 ± Lt
Channel Excav, Item 15 & Stone Fill, Item 09
See X-section sheets 61-64 of 117



Sta 1049+45 ± Lt - Sta 1053+75 ± Lt
Channel Excav, Item 15 & Stone Fill, Item 09
See X-section sheets 67-69 of 117.

PARCEL	INSTRUMENT	DATE	GRANTOR	GRANTEE	RECORDED	REMARKS
12 A	W.D.O.E.	10-1-46	HARRY T, BERTIE & JENNIE GELO	STOF VT. 21	135 10-10-46	
12 B	W.D.O.E.	9-13-46	LULA SHUFELT	STOF VT. 21	126 10-10-46	

79(2) 1946 12 117

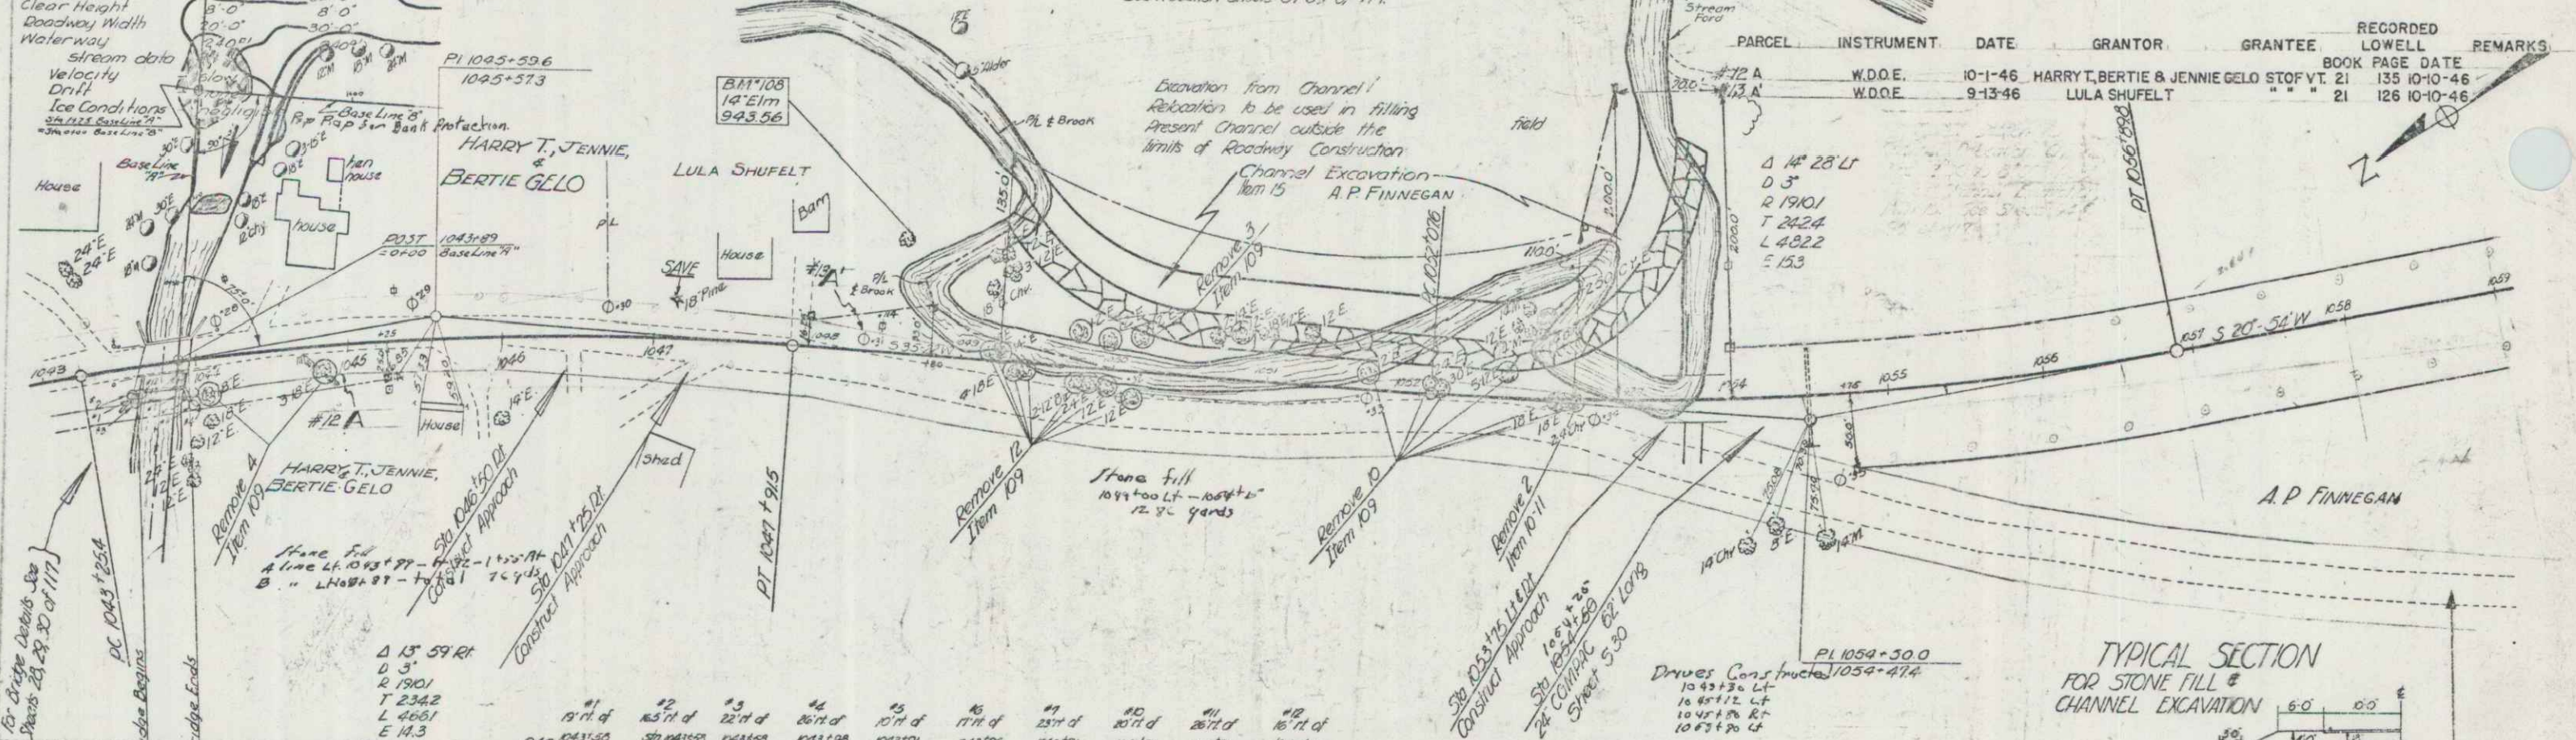

TYPICAL SECTION FOR STONE FILL & CHANNEL EXCAVATION

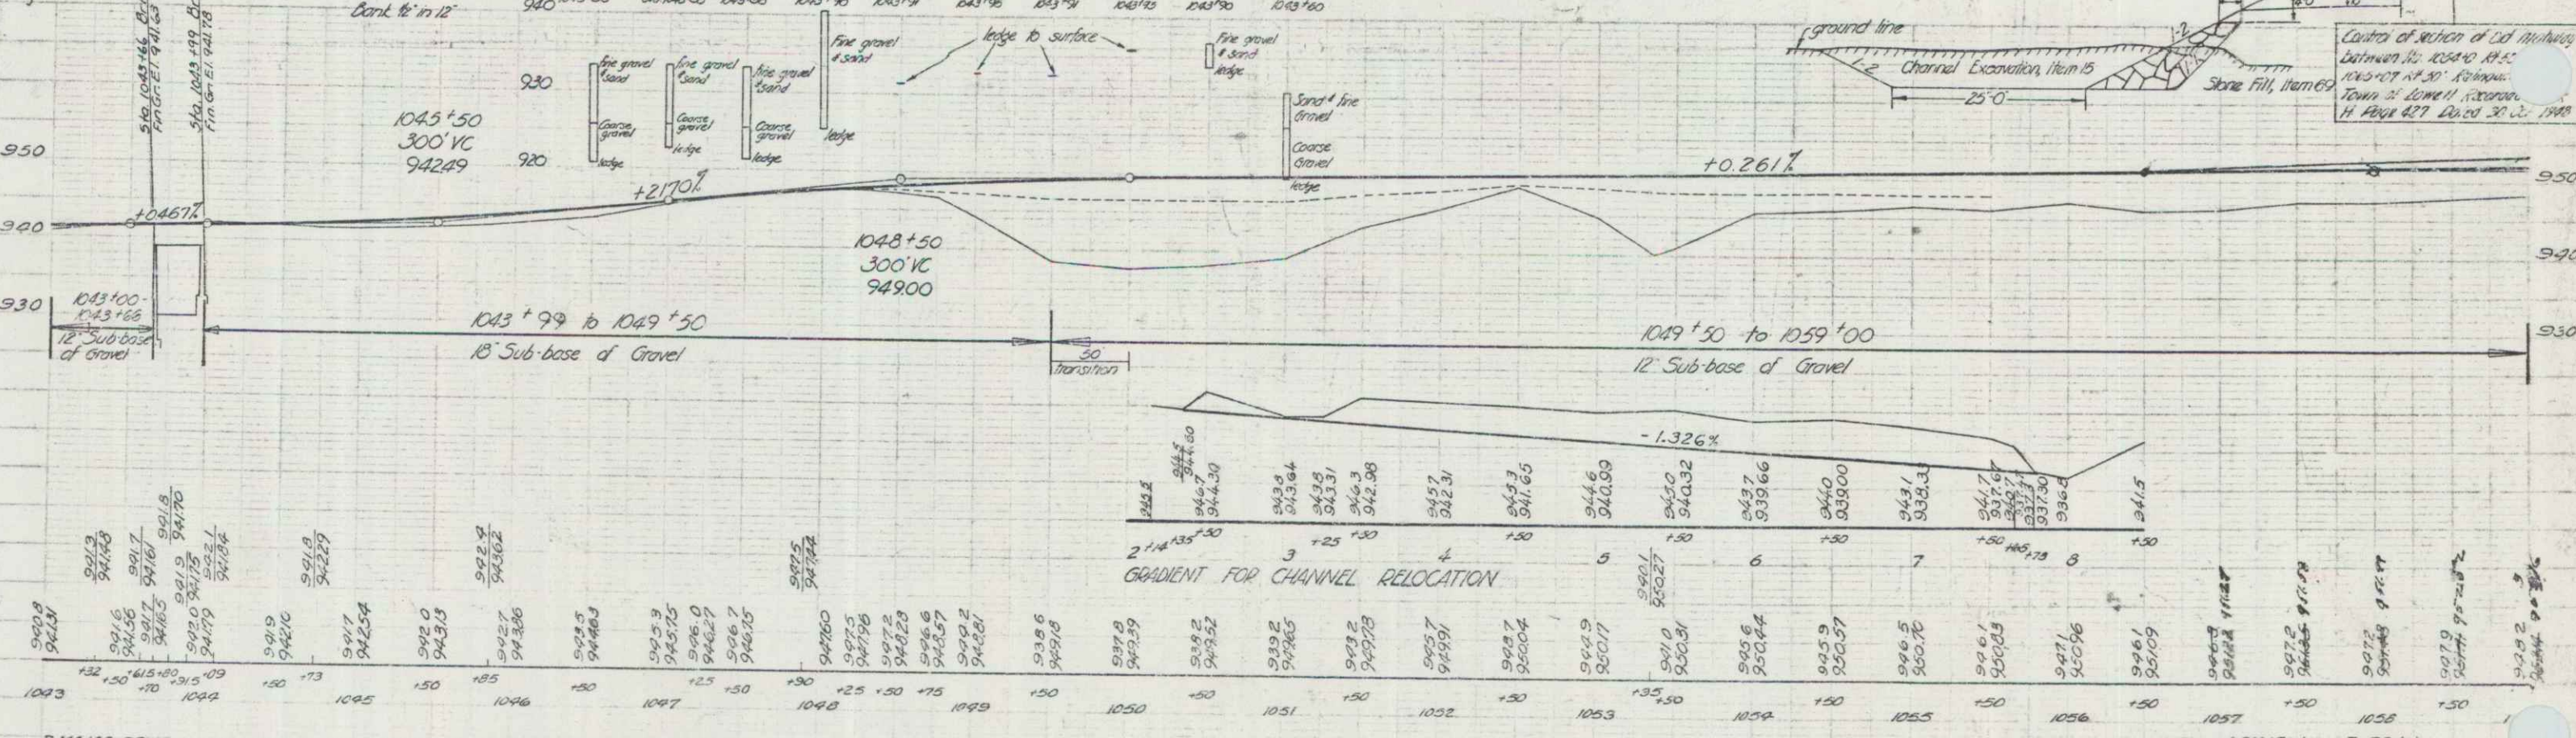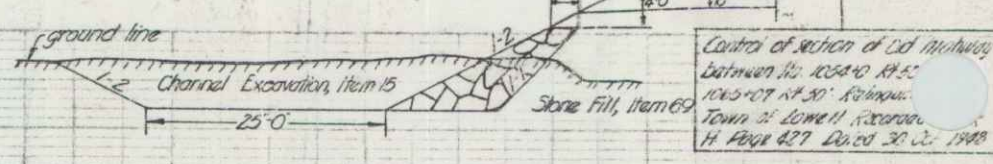

B.M. 108 SPIKE IN ROOT 12 ELM TO LT STA 1048+60 ELEV 943.56

LOWELL F 79(3)
Sheet 12 of 117 Sheets