



Spanning 945  
 Traced Butler 1845

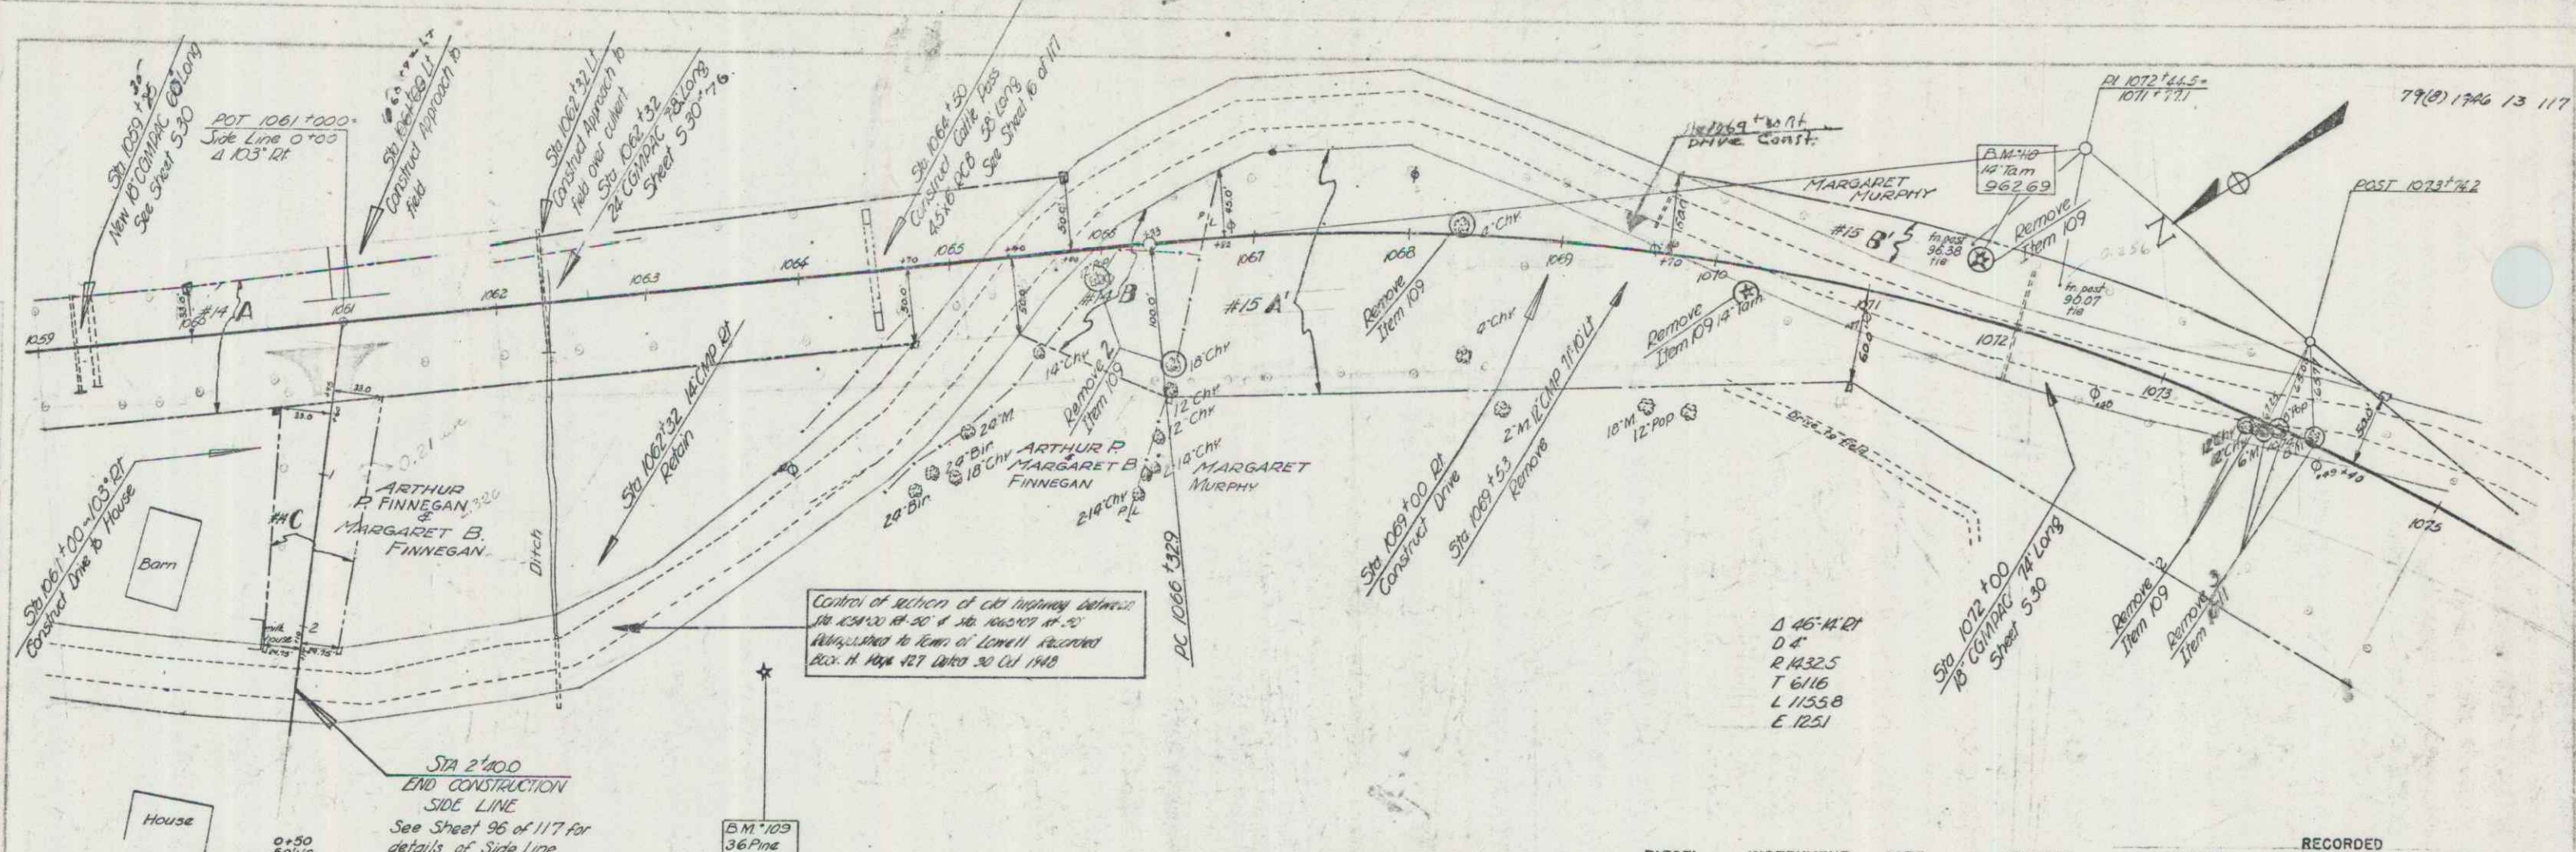

Spanning 1145

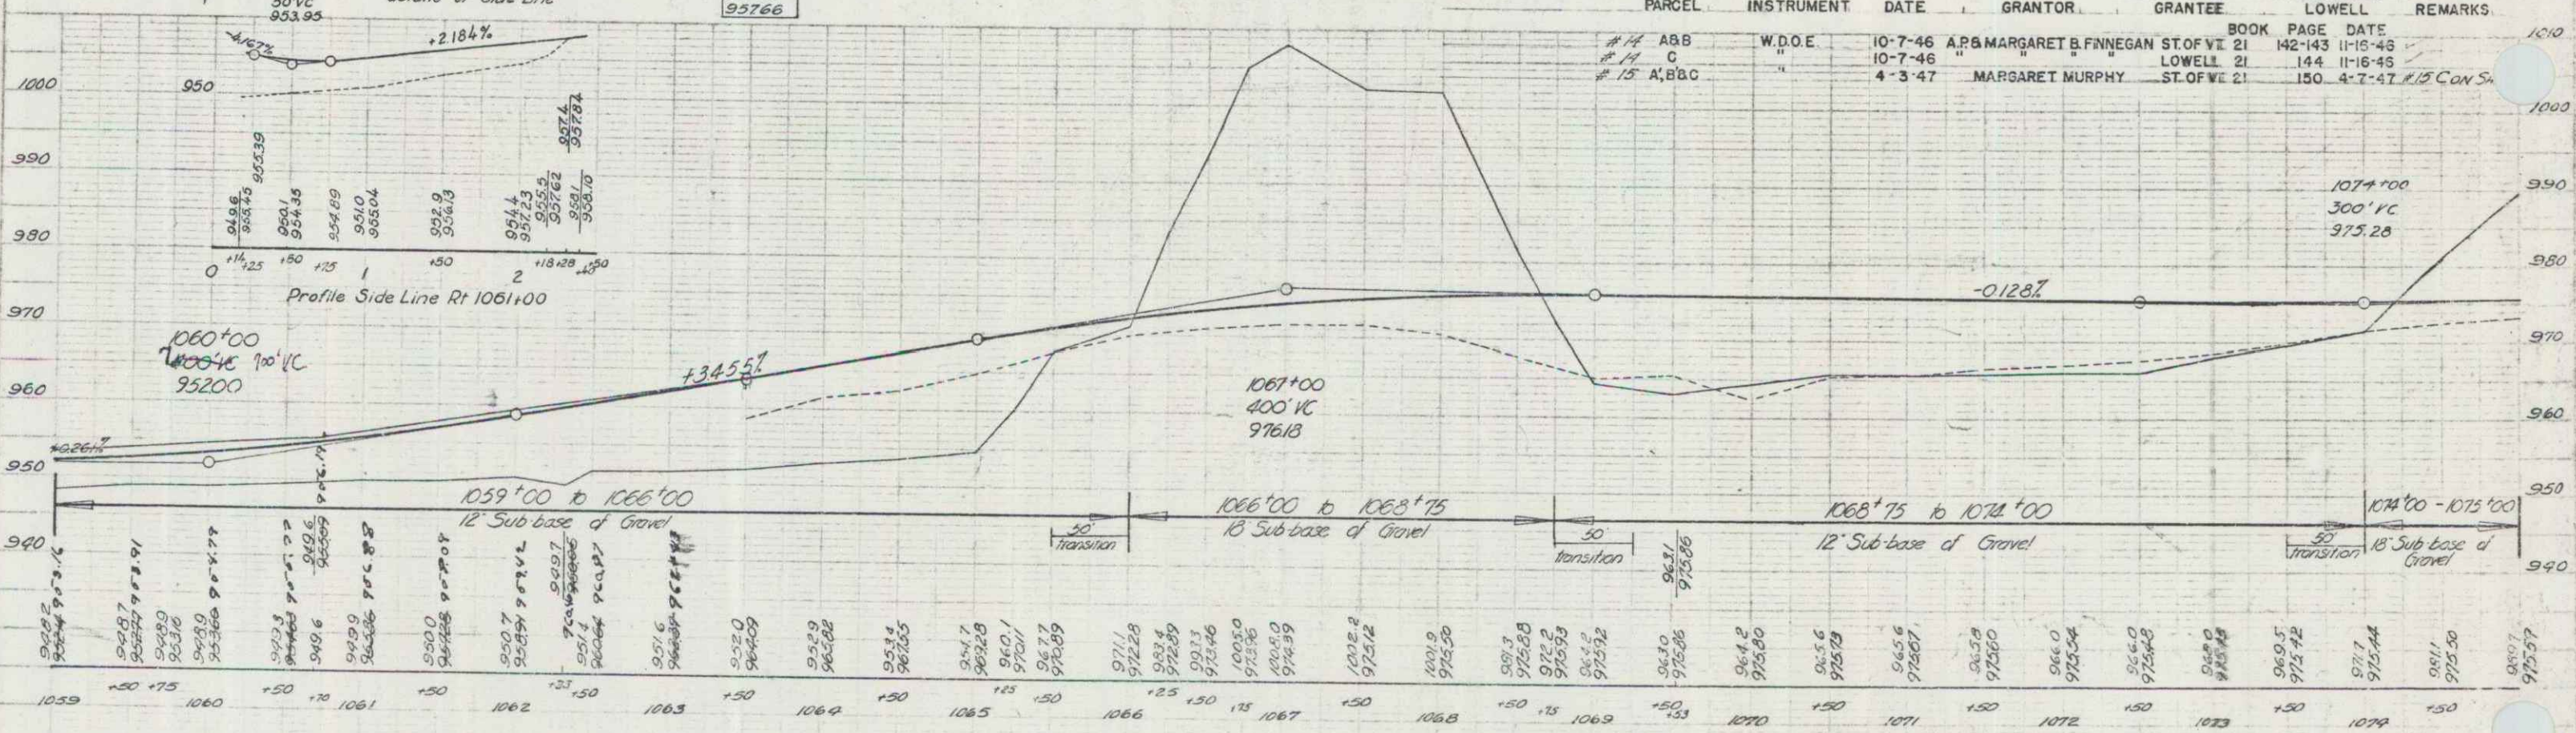

BM 109 SPIKE IN ROOT 36" PINE 217' RT STA 1063+67 ELEV 95766  
 BM 110 " " " 19" TRM 110' LT STA 1071+50 ELEV 96269

LOWELL F 79 (8)  
 Sheet 13 of 117 Streets