



PLAN  
 DRAWN BY: A. Gagnon  
 CHECKED BY: J. Gagnon  
 DATE: 11/82

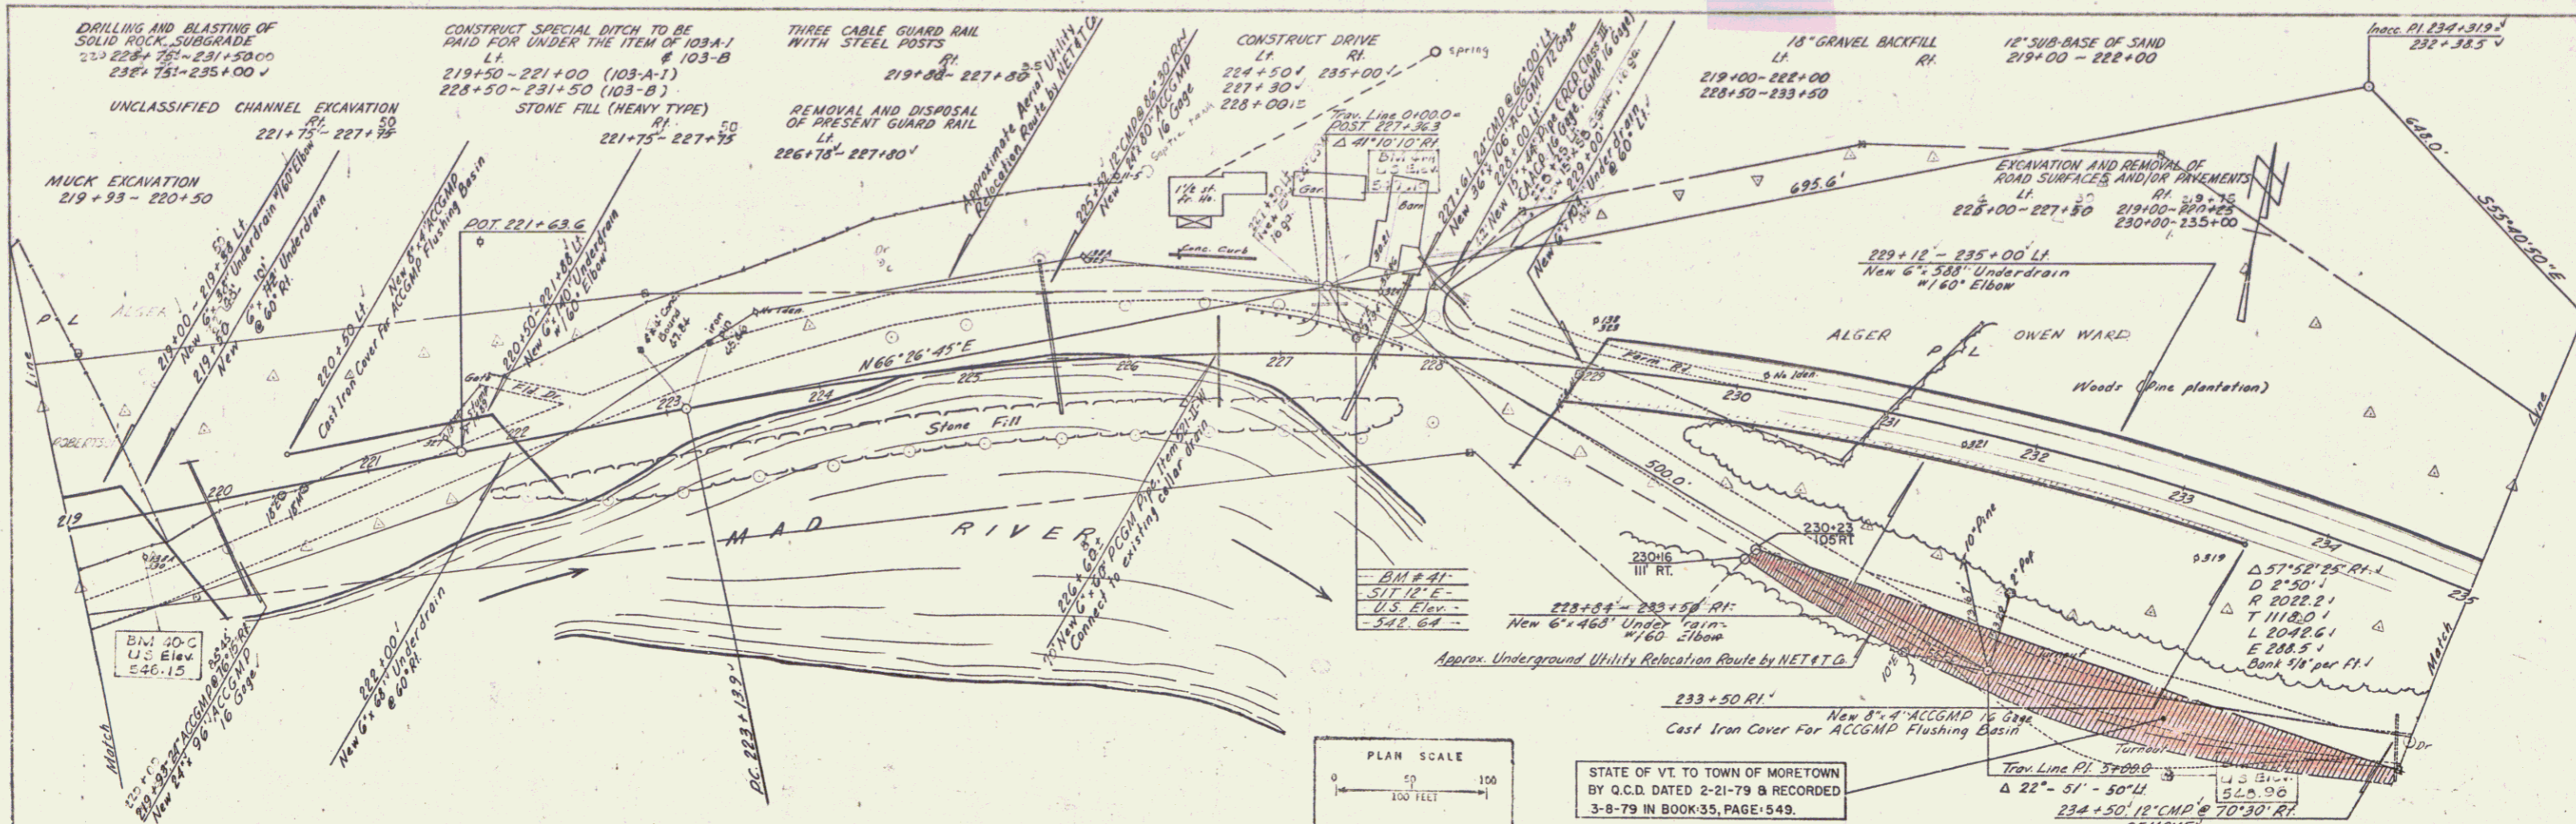

PROFILE  
 DRAWN BY: A. Gagnon  
 CHECKED BY: J. Gagnon  
 DATE: 11/82

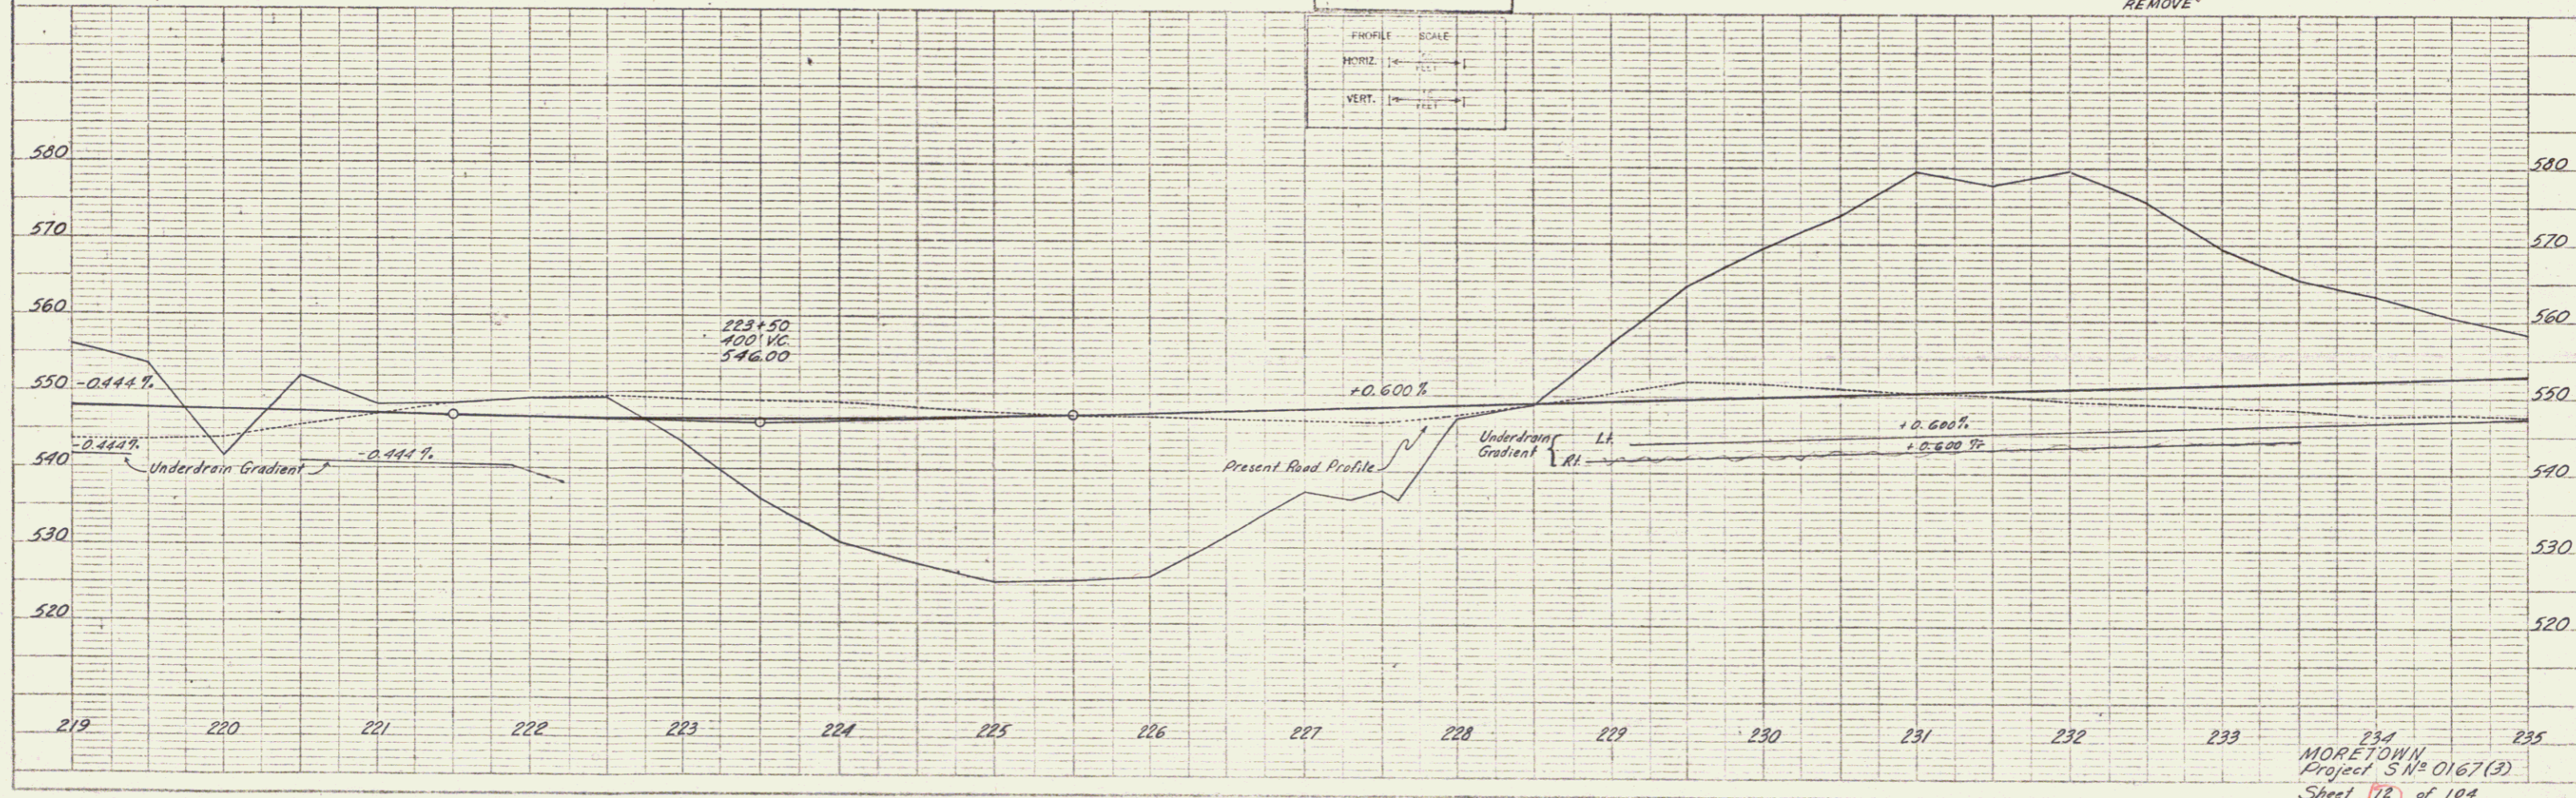

APR 16 1979