



St. of VT to TOWN OF MORETOWN
 BY QCD OF 2/21/79
 IN BK 35/549

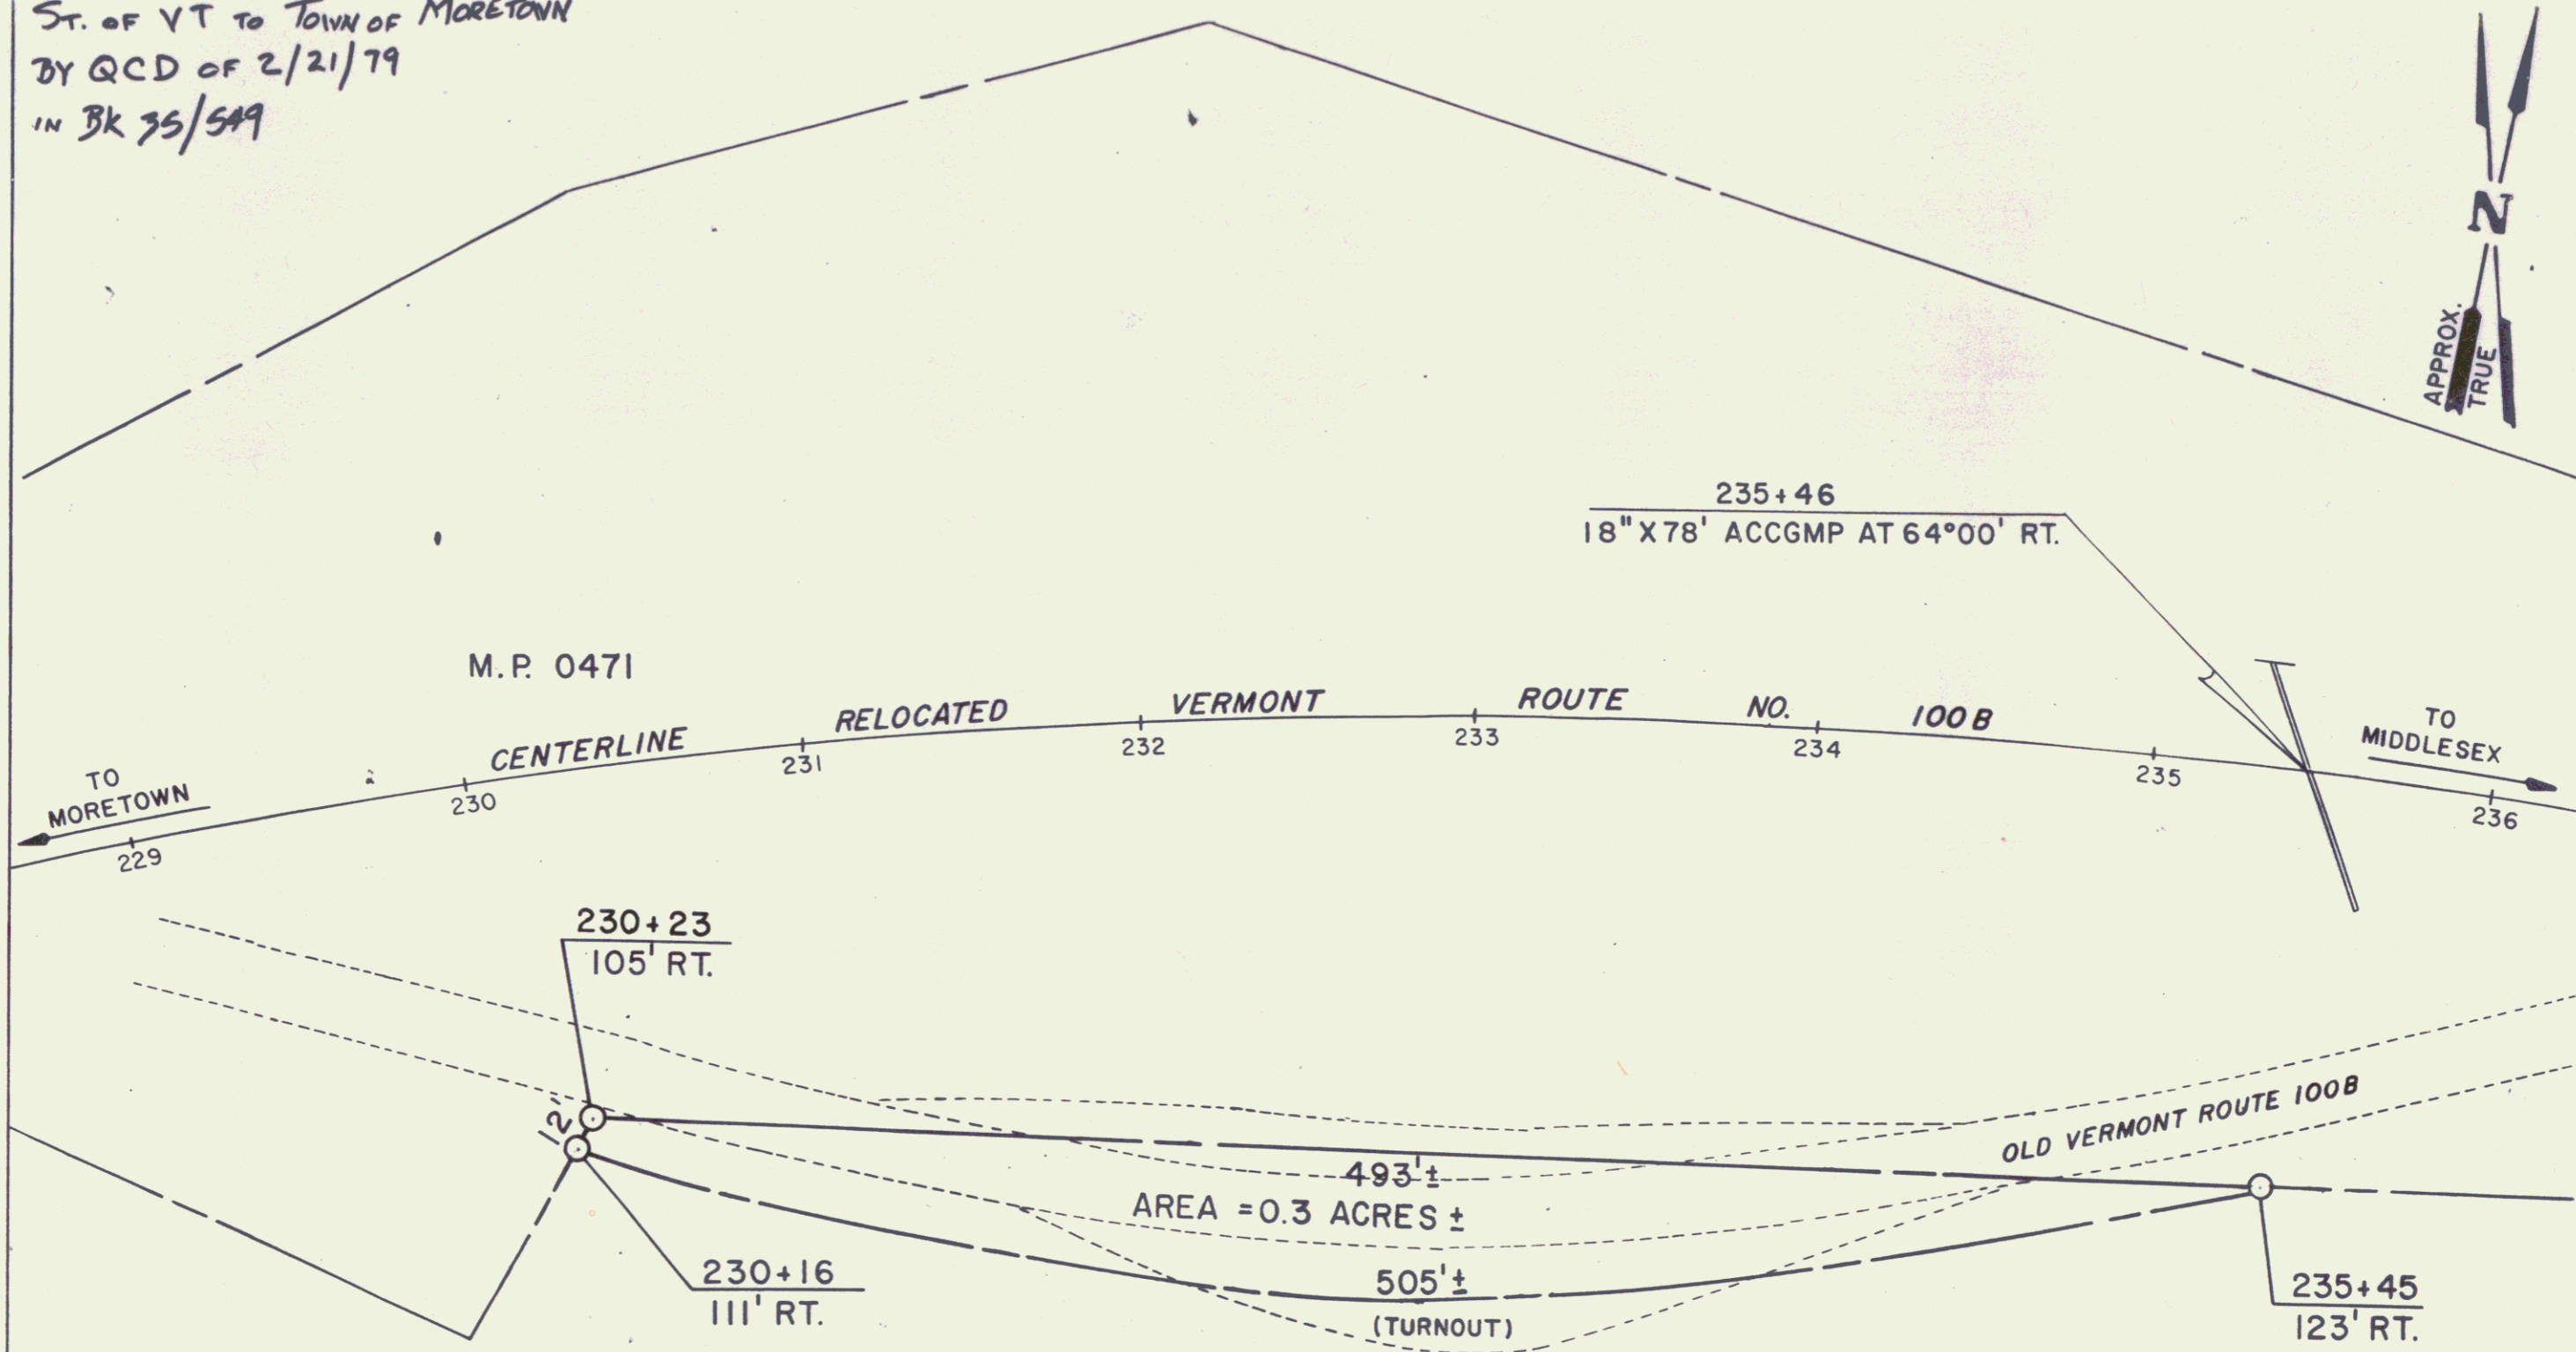

N/F WARD, OWEN M. AND WYMAN B.

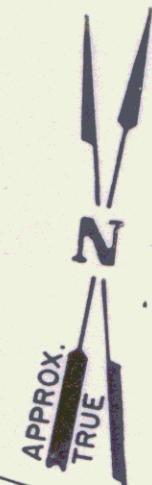

REF SHEETS 11 & 12

STATE OF VERMONT
 AGENCY OF TRANSPORTATION

SHEET 12A

TOWN OF MORETOWN

PROJECT S 0167(3)

APPROX. SCALE 1"=50'

DATE 1/26/79

DRAWN BY
 P. J. HARDIE

5