
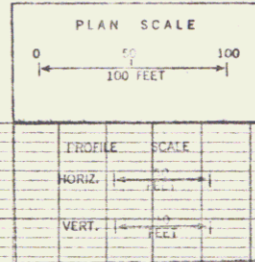
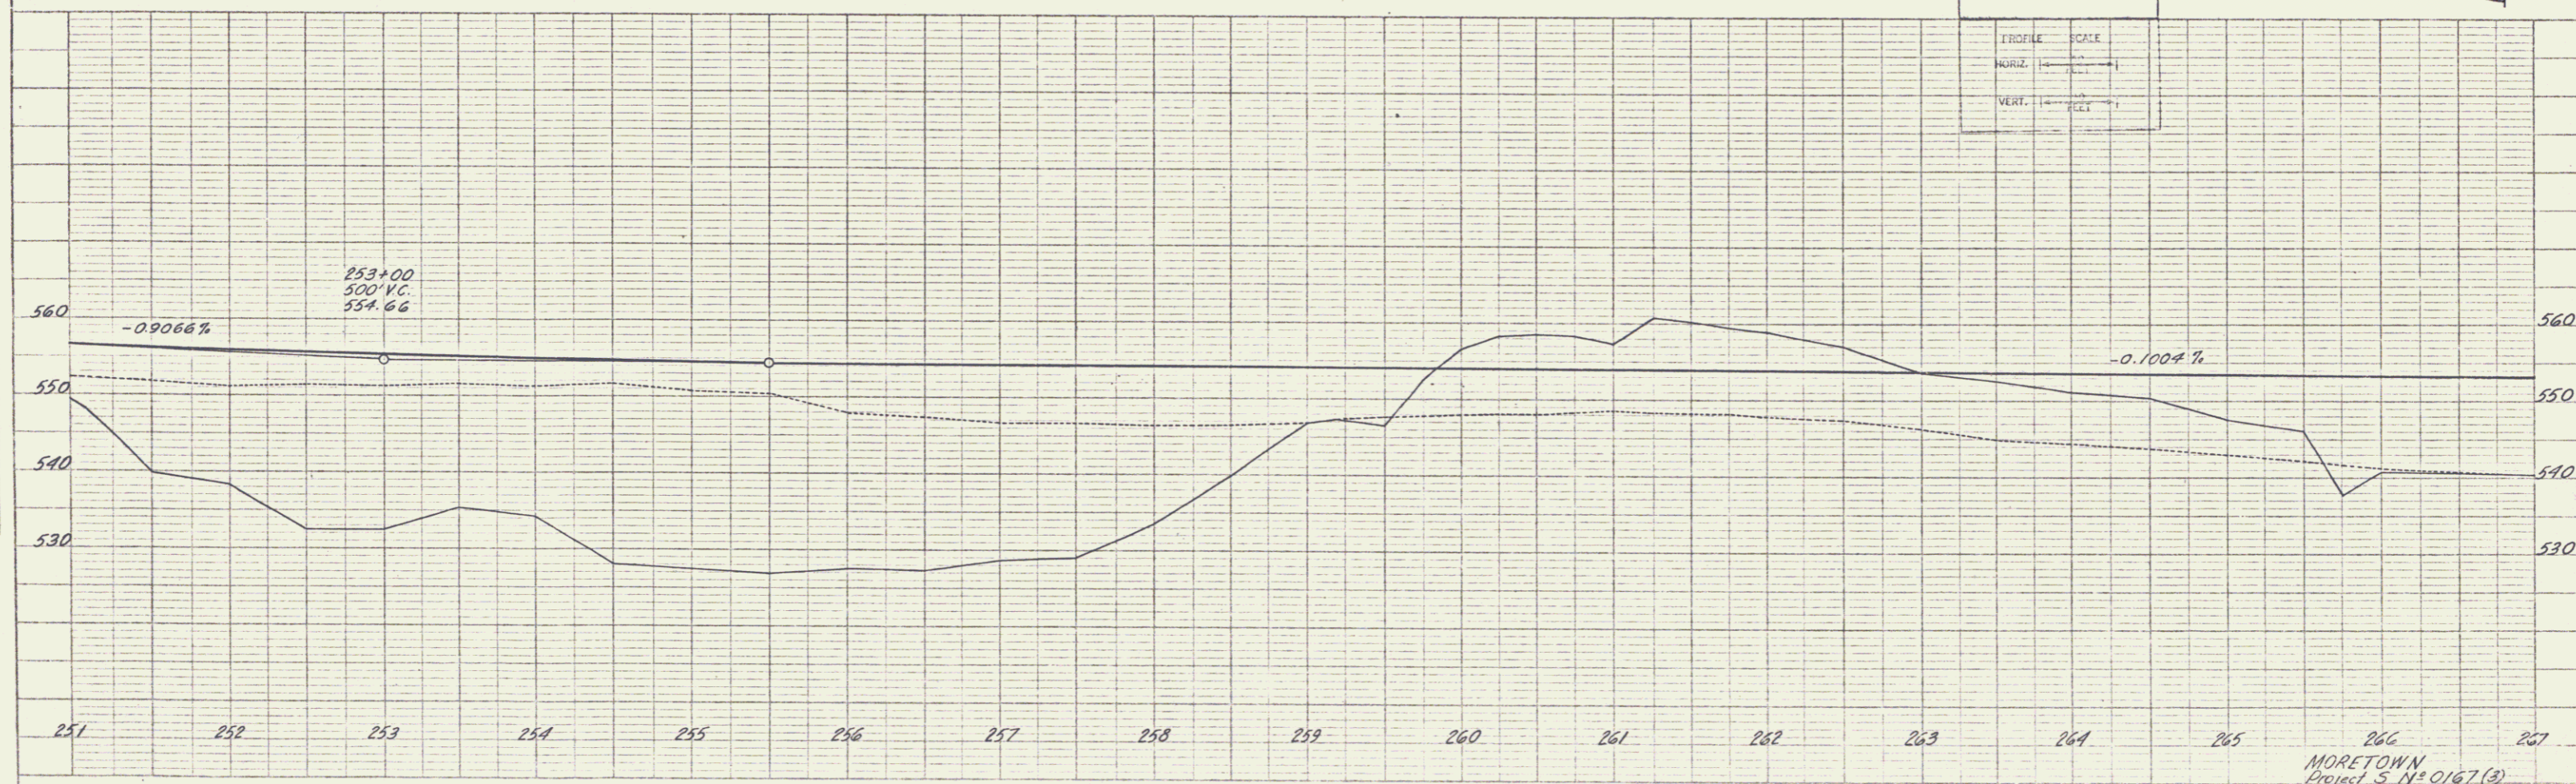


PLAN  
 DRAWN BY  
 A. Gagnon  
 CHECKED BY  
 A. Gagnon

PROFILE  
 DRAWN BY  
 A. Gagnon  
 CHECKED BY  
 A. Gagnon

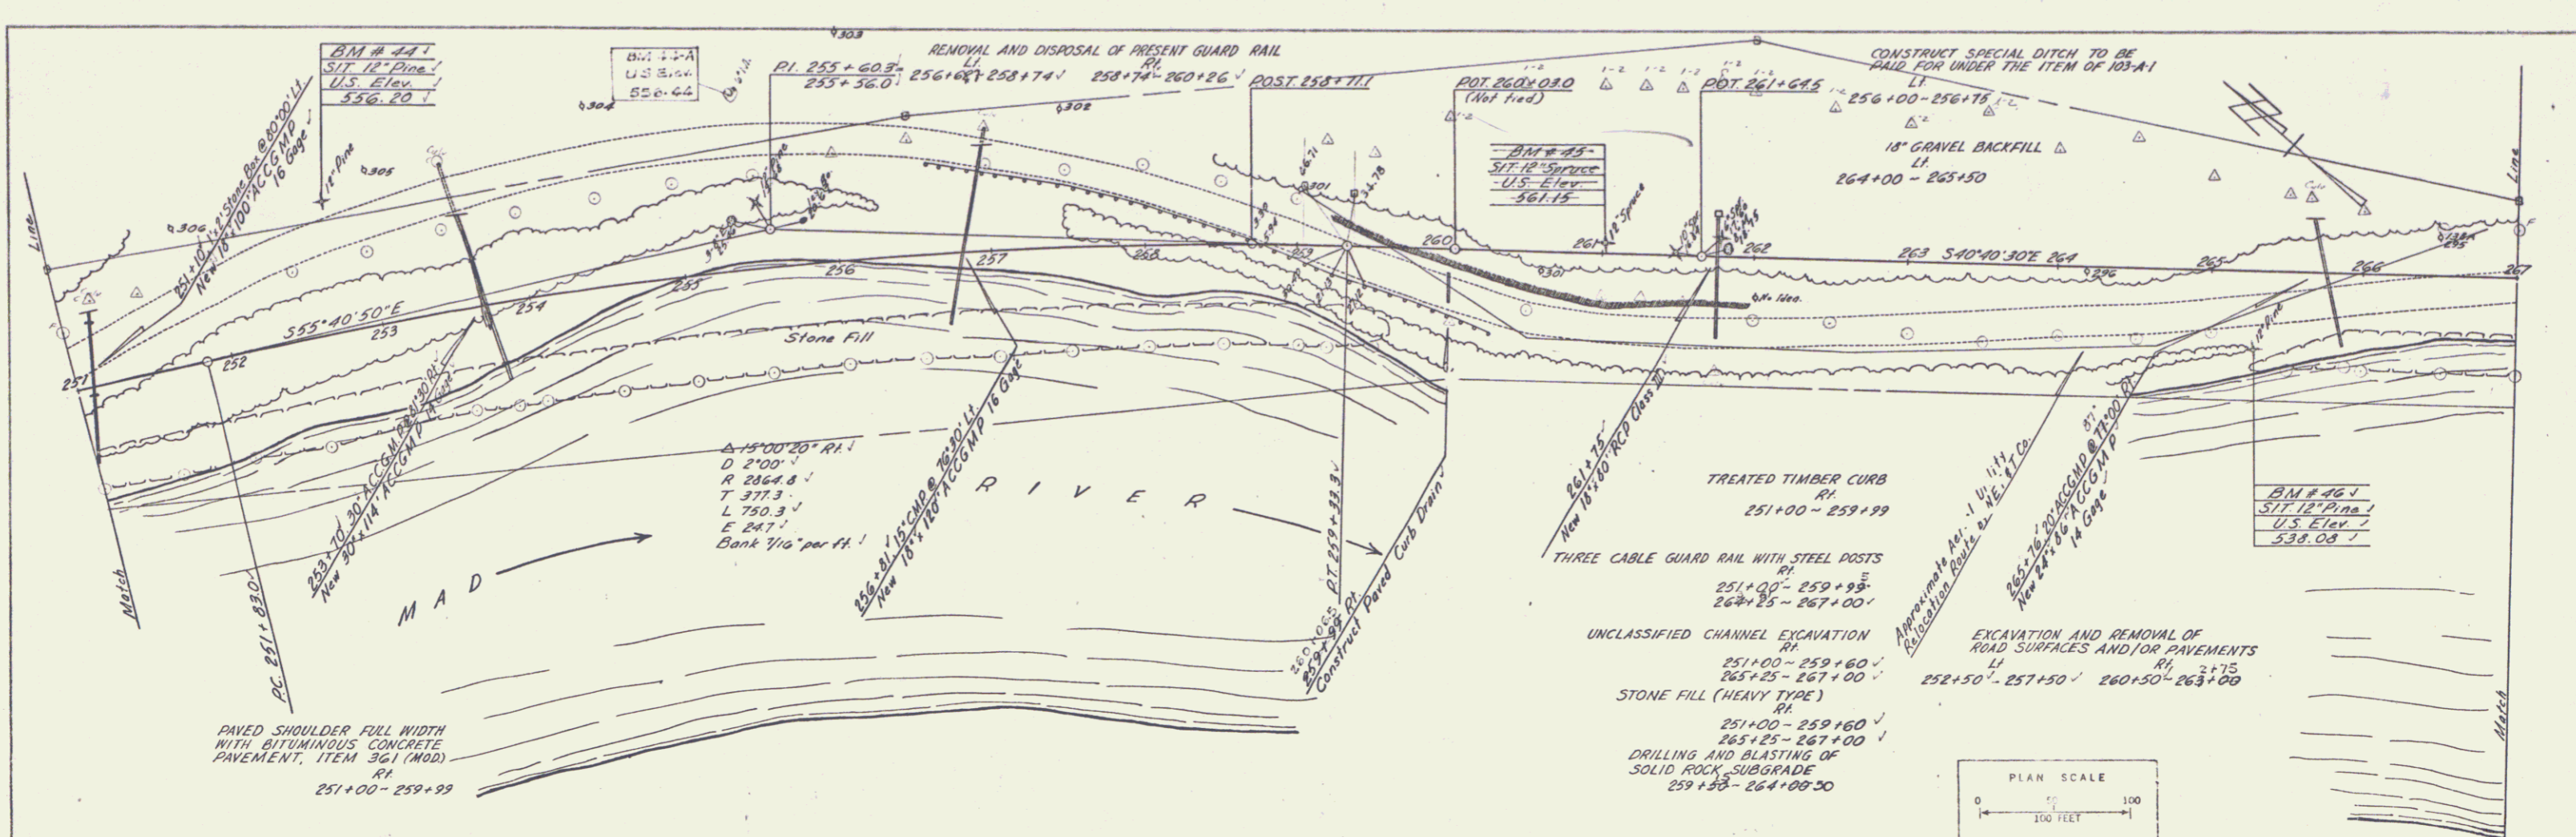

MORETOWN  
 Project S N° 0167(3)  
 Sheet 14 of 104