

PLAN
 DRAWN BY: Miller, A. Gagnon
 CHECKED BY: Miller, A. Gagnon
 DATE: May 24, 1954
 PROJECT: PROJECT 0167(3)
 SHEET: 12 OF 104

PROFILE
 DRAWN BY: Miller, A. Gagnon
 CHECKED BY: Miller, A. Gagnon
 DATE: May 24, 1954
 PROJECT: PROJECT 0167(3)
 SHEET: 12 OF 104

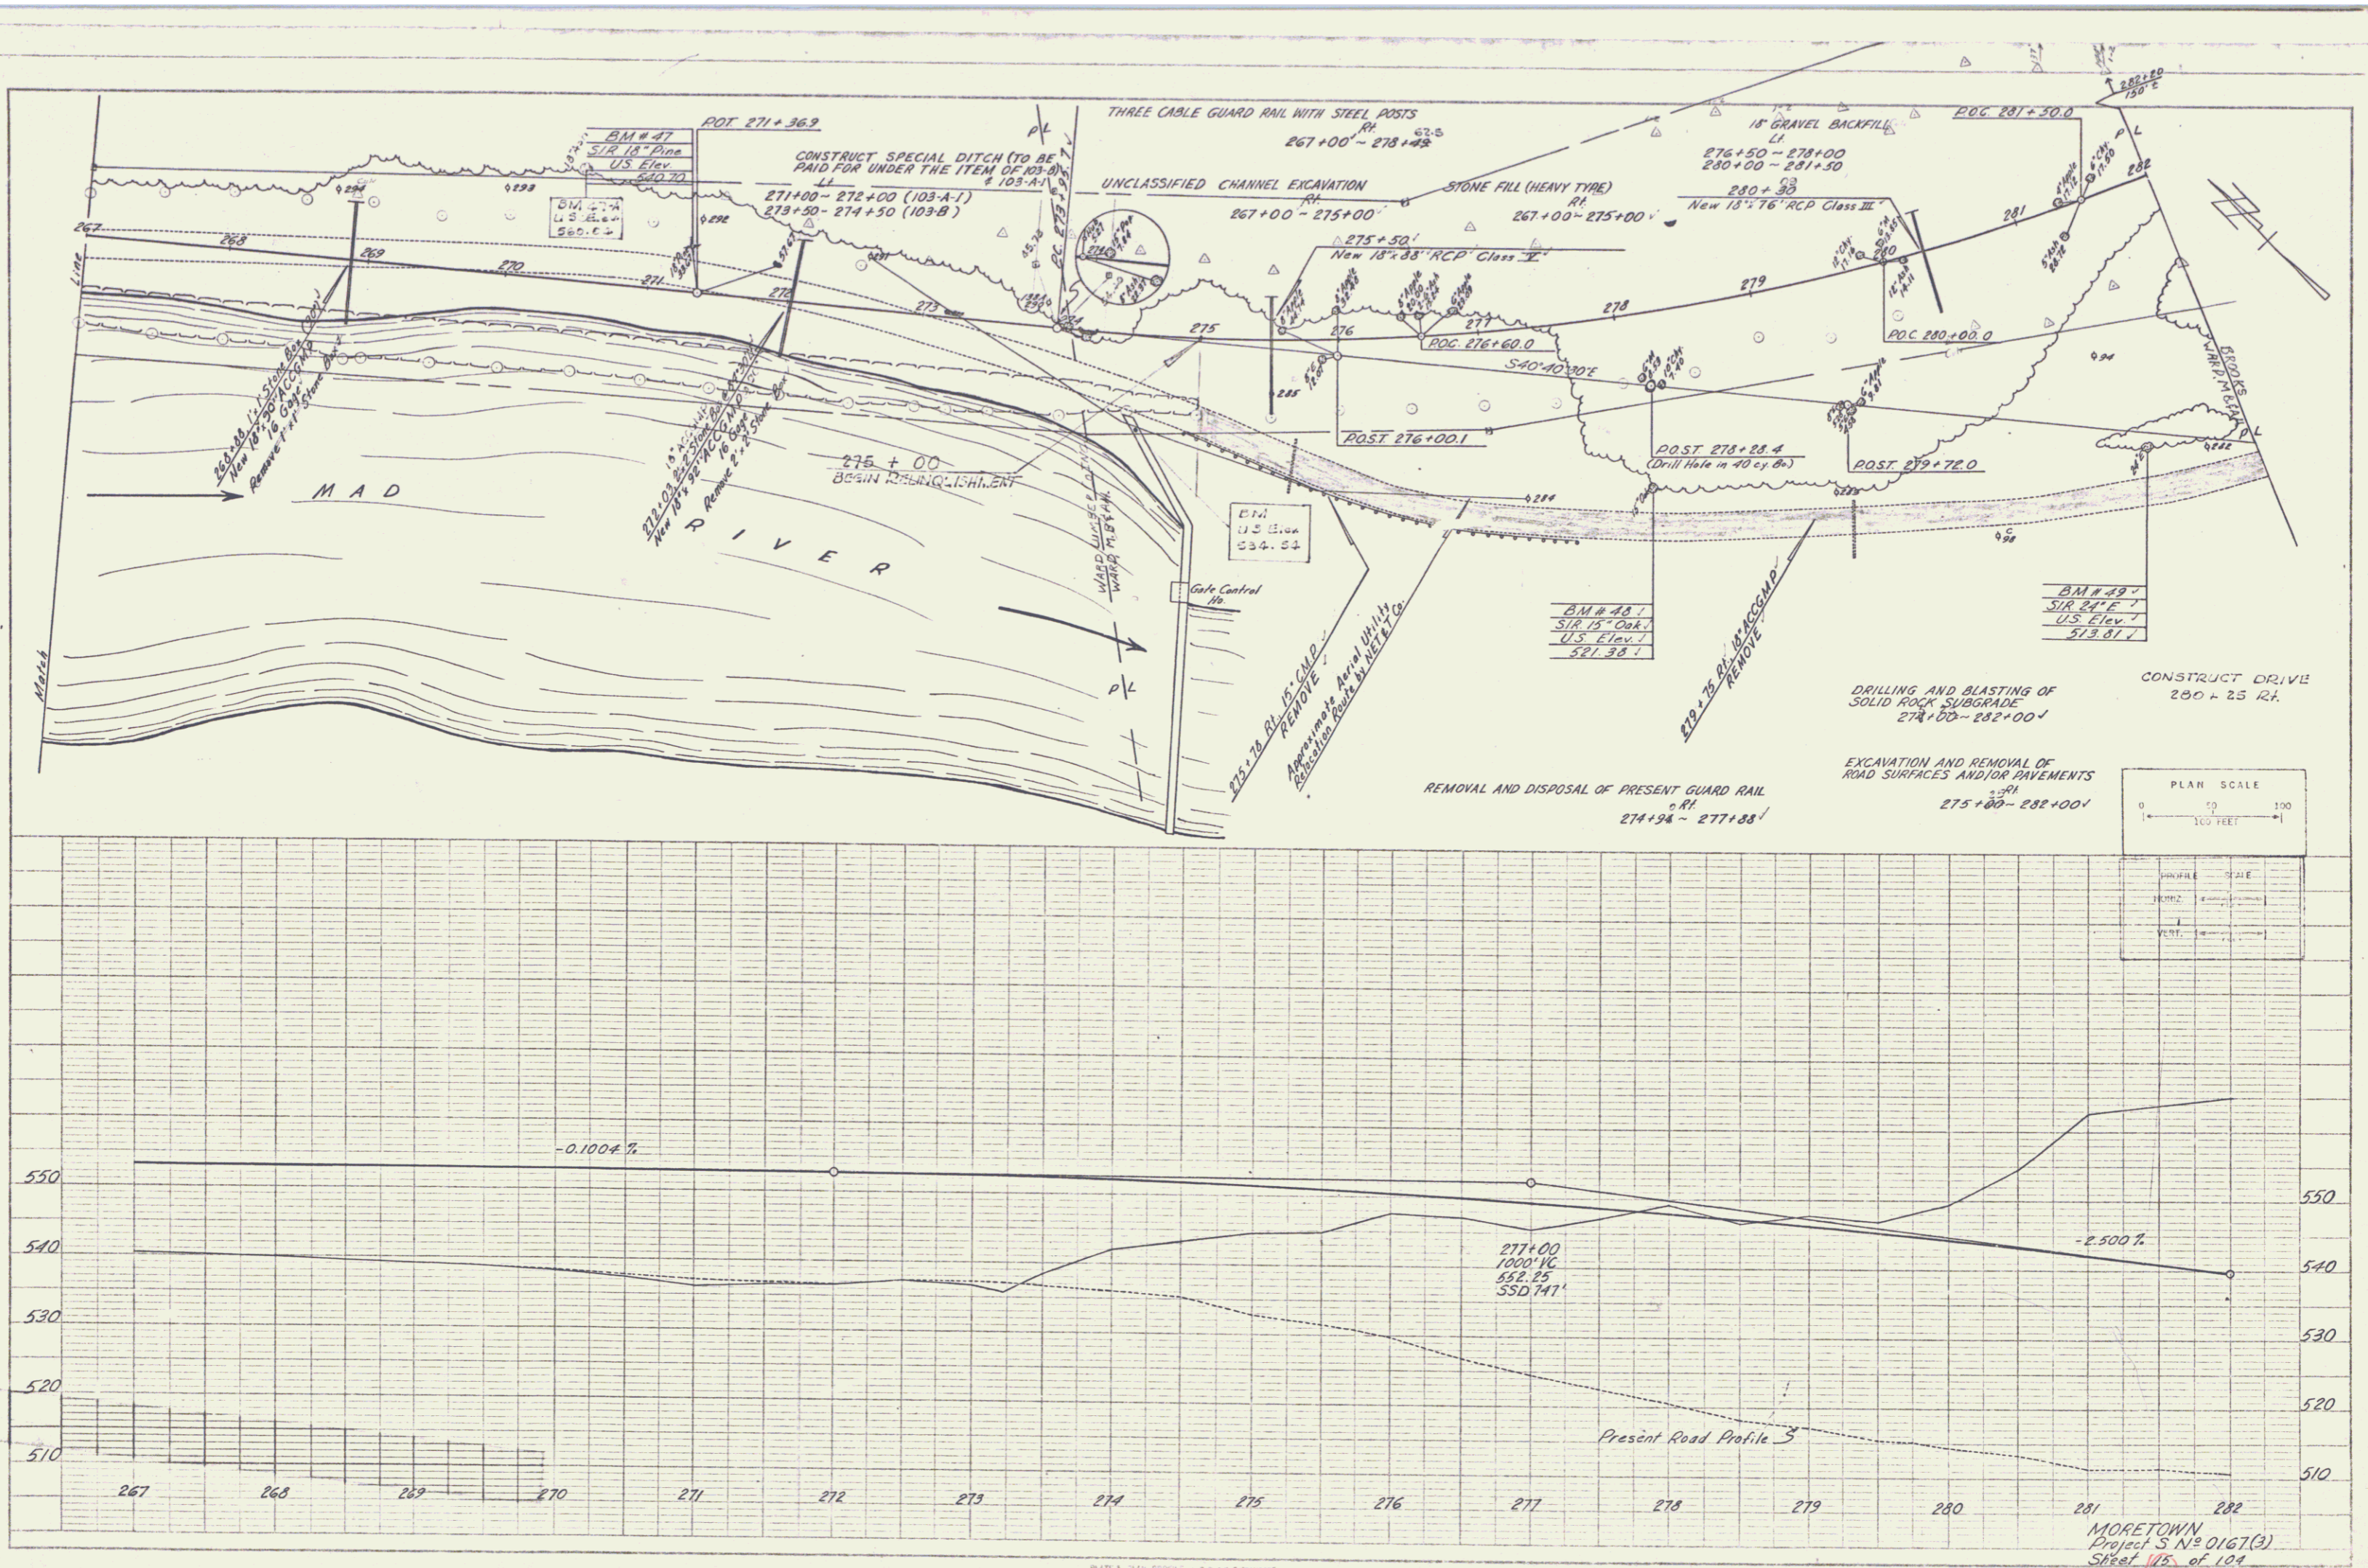


PLATE 3 - PLAN - PROFILE - P. & R. E. STARRS
 PROJECT 0167(3) SHEET 12 OF 104
 MAY 24, 1954

MORETOWN
 Project S N 0167(3)
 Sheet 12 of 104