



PLAN	DATE	BY
REVISED	11/22/20	A. Chapman
NOTED		
CHECKED		
IN CHARGE		

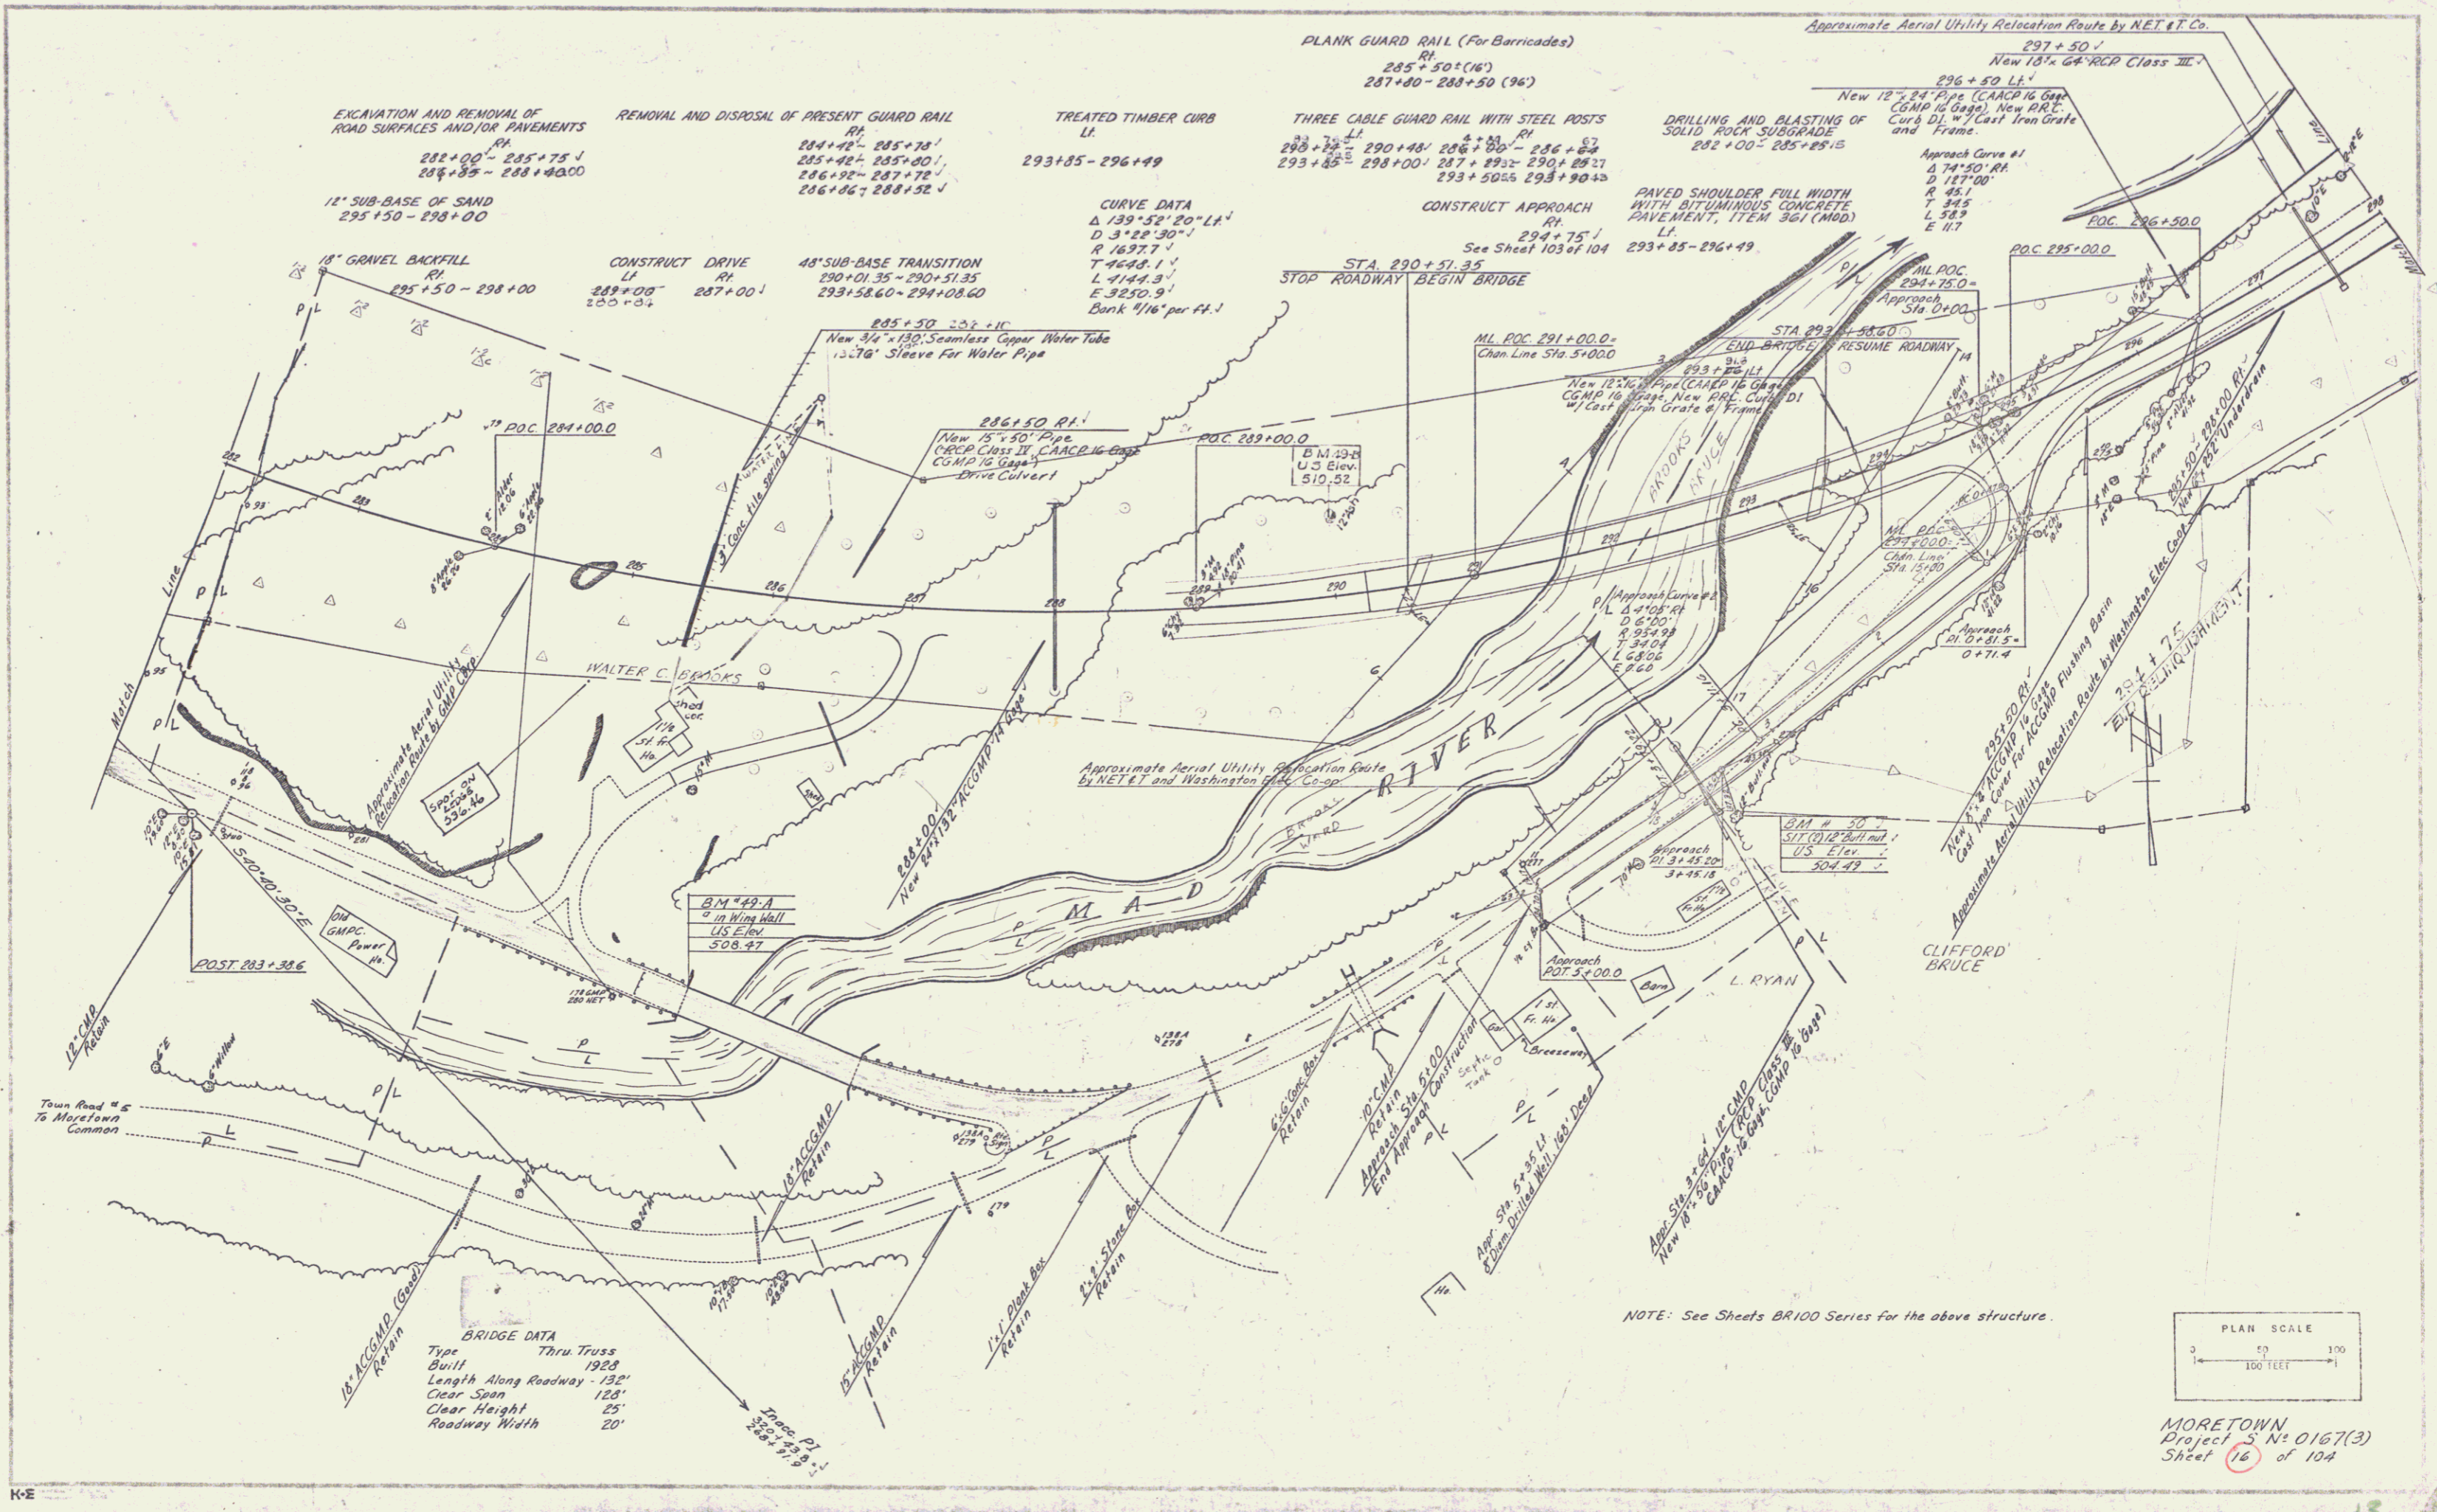

NOTE: See Sheets BR100 Series for the above structure.

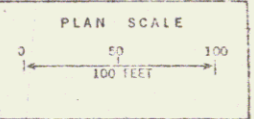

MORETOWN
Project S N: 0167(3)
Sheet 16 of 104