


PLAN
 DRAWN BY: Martin A. Gagnon
 CHECKED BY: A. Gagnon
 DATE: May 83

PROFILE
 DRAWN BY: Martin A. Gagnon
 CHECKED BY: A. Gagnon
 DATE: May 83

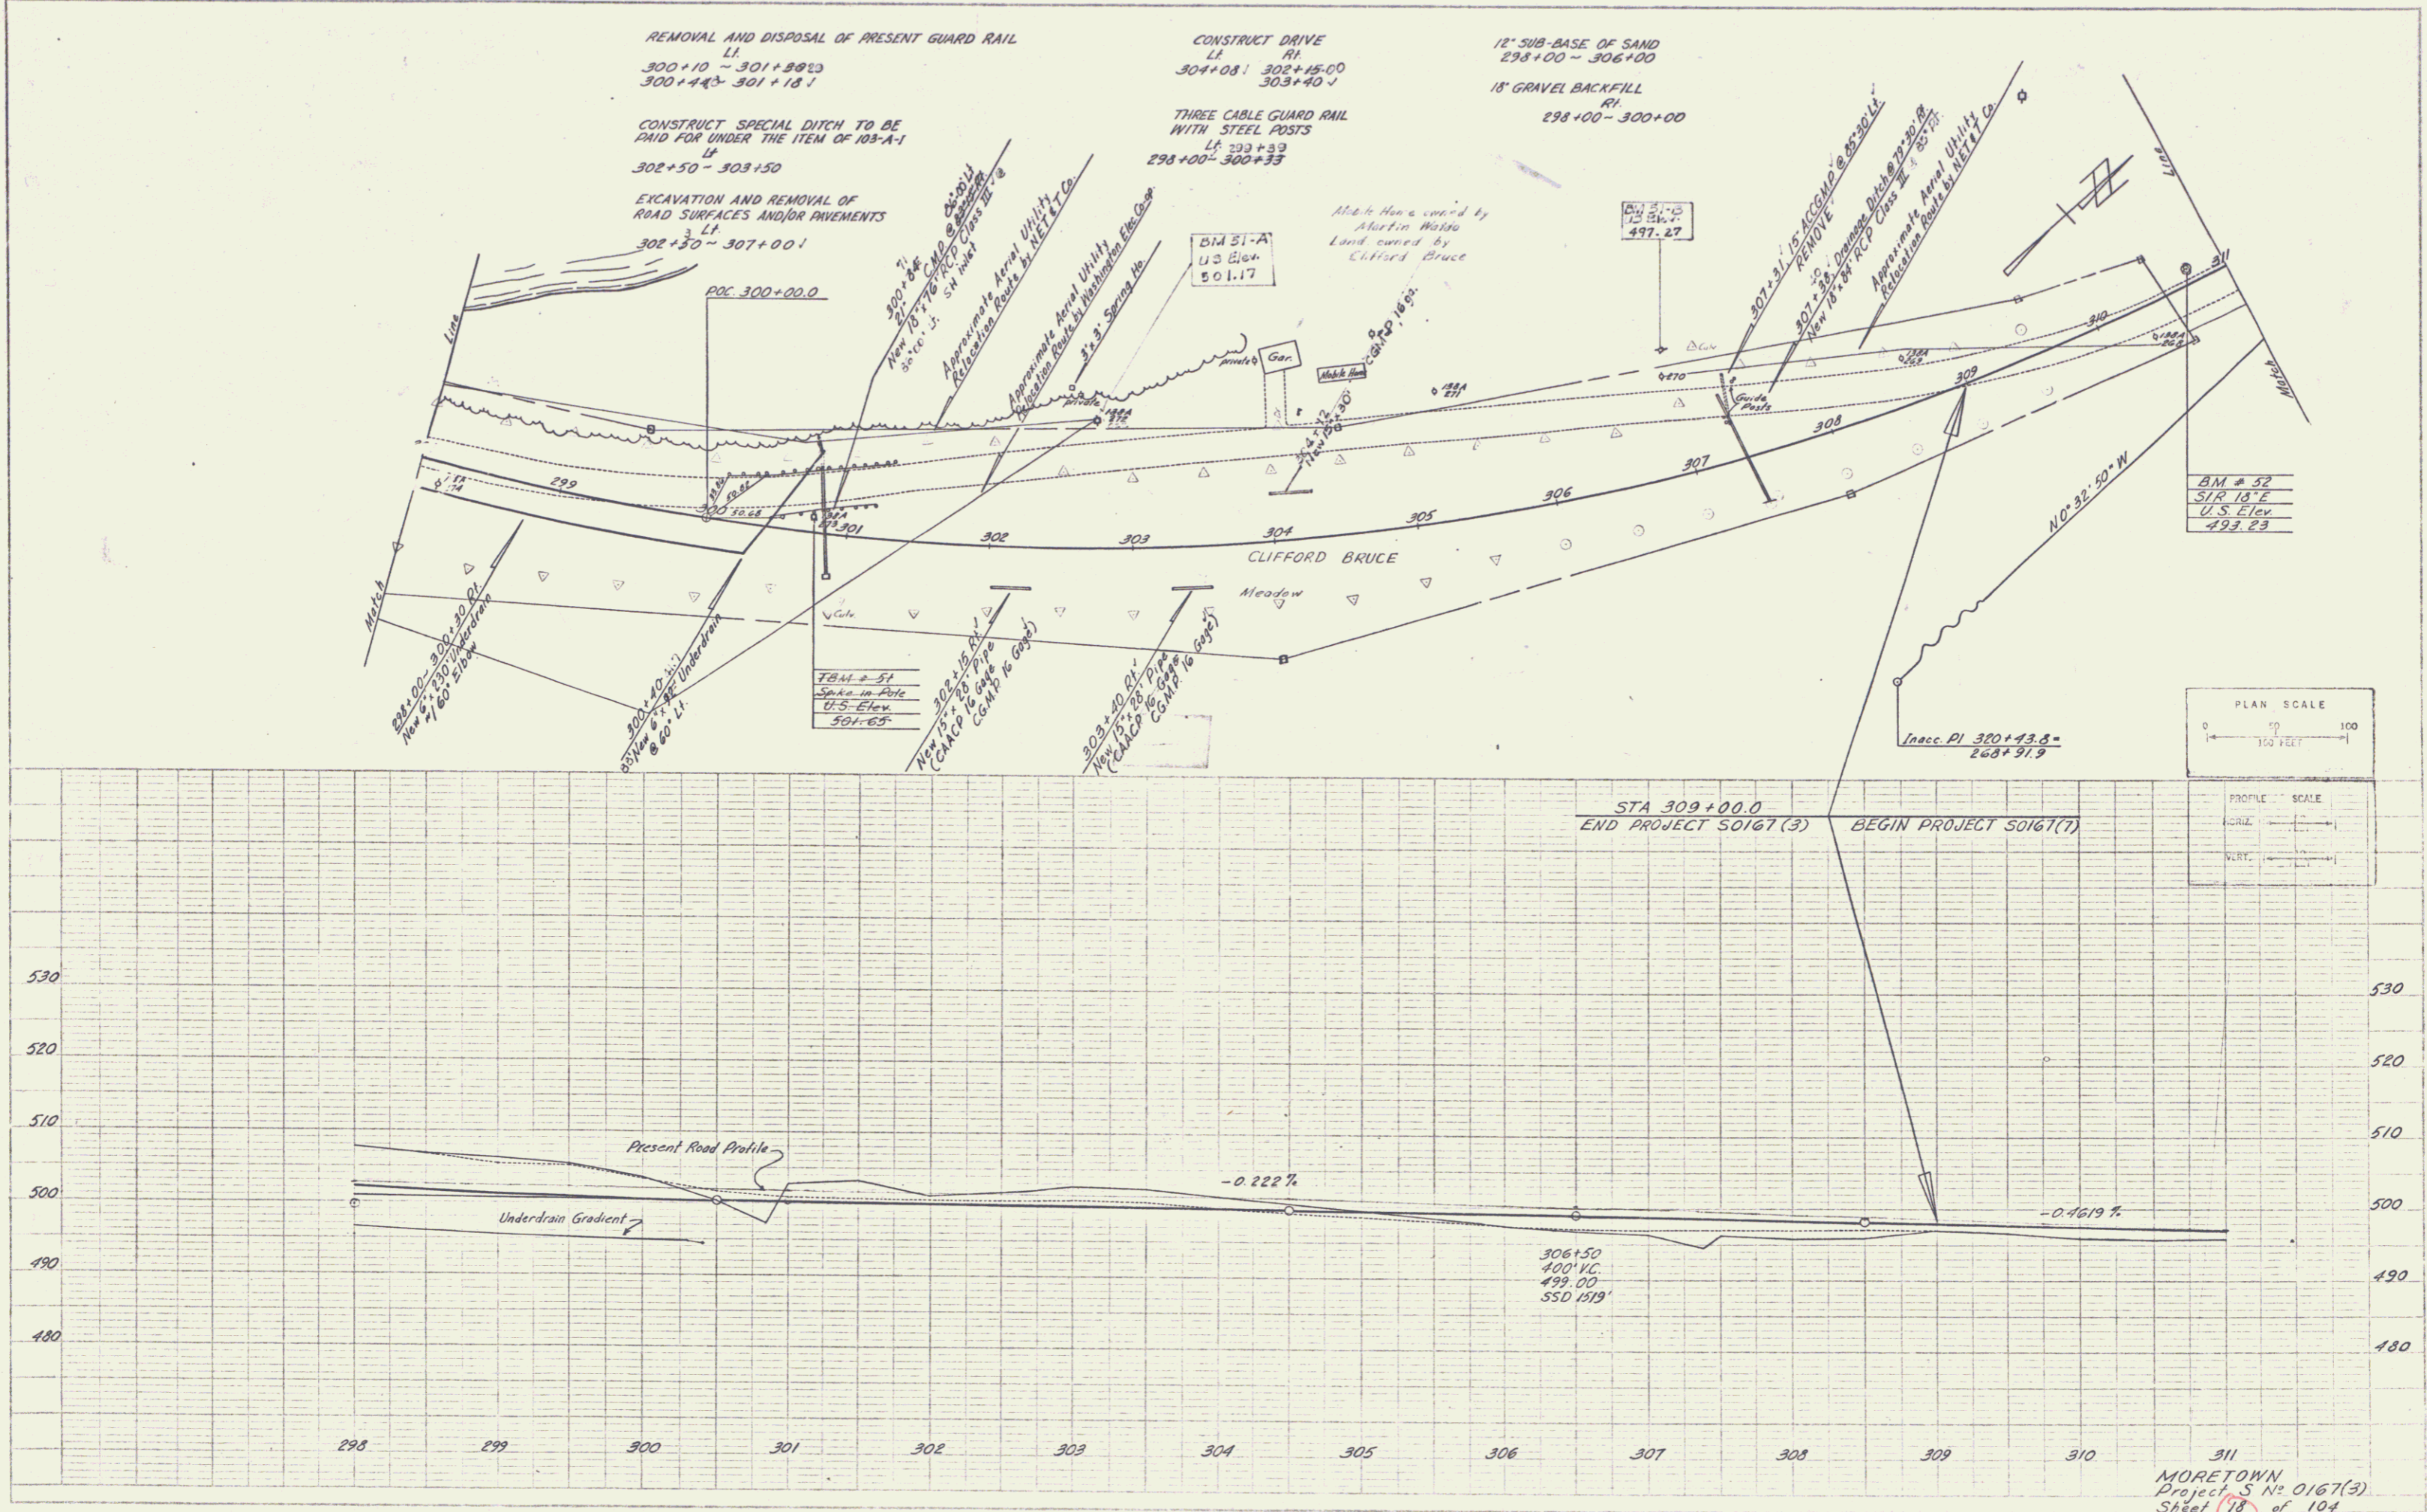

MORETOWN
 Project S No 0167(3)
 Sheet 18 of 104