
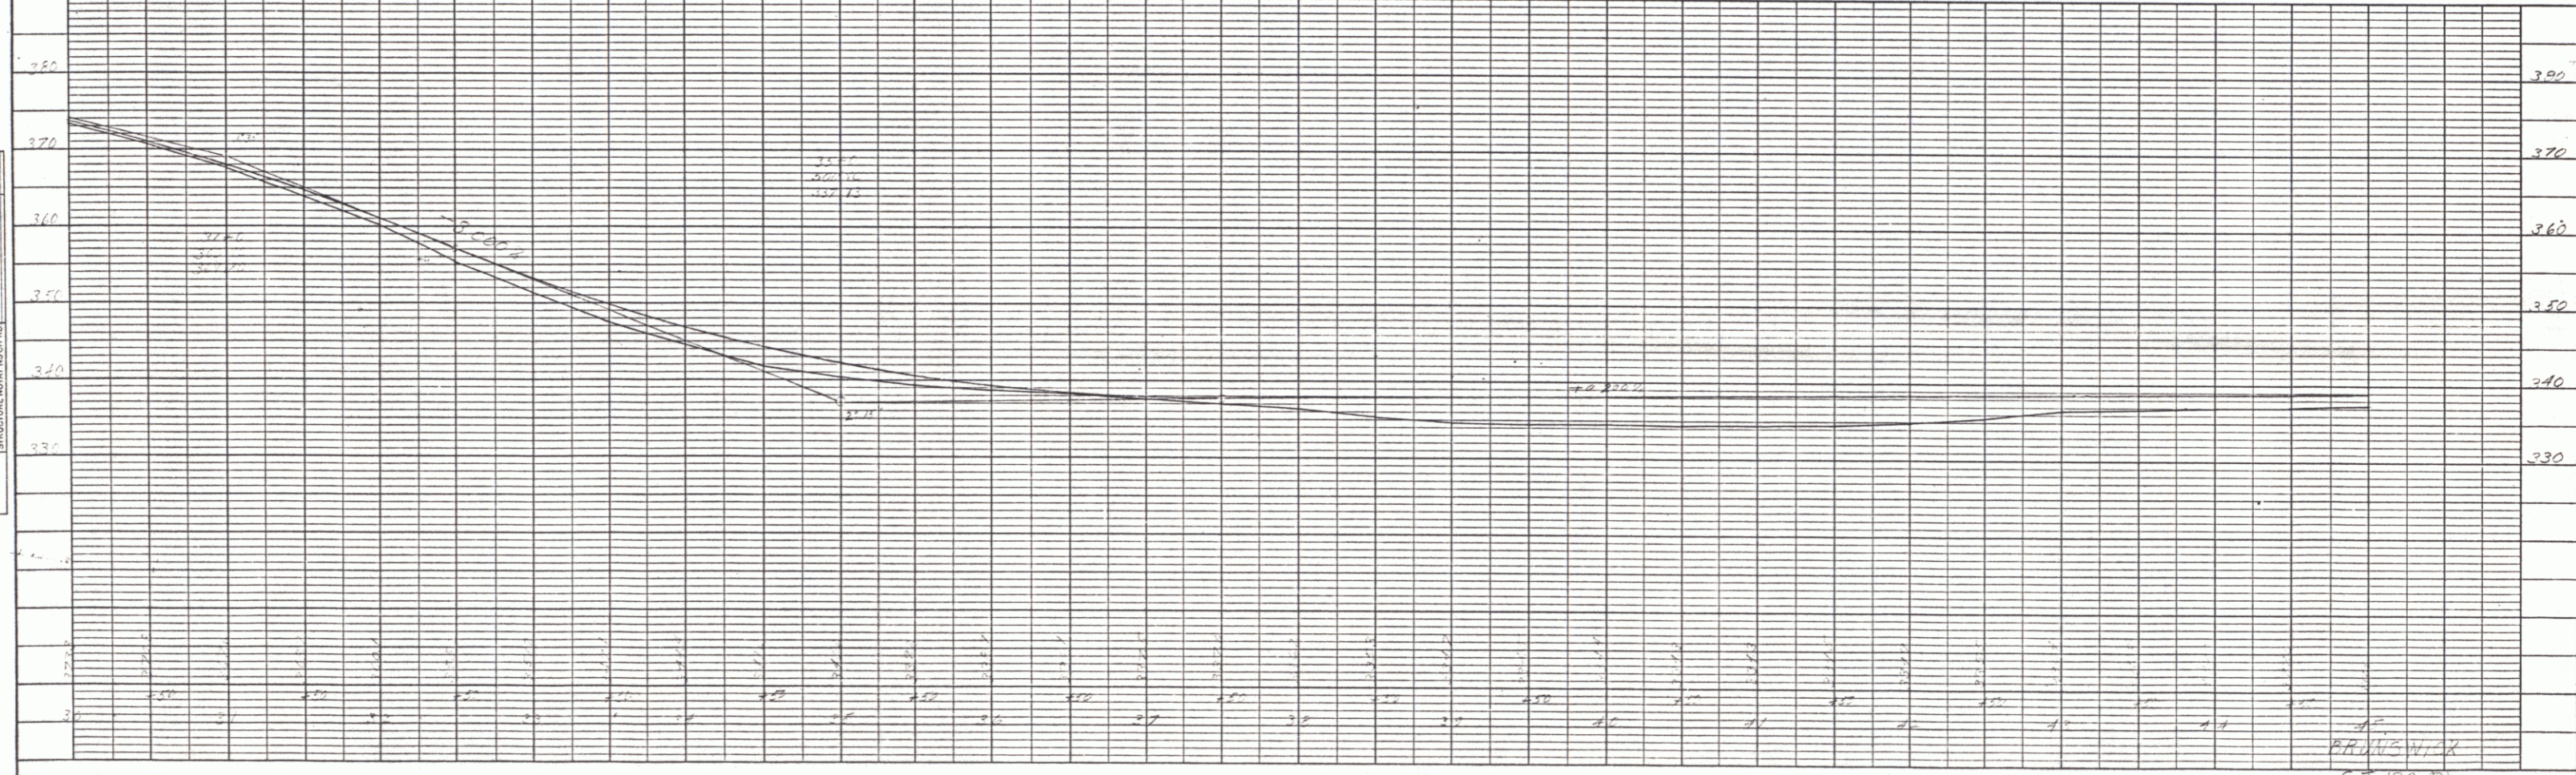


PLAN
 SURVEYED BY
 PLOTTED BY
 CHECKED BY
 DATE
 NO.

PROFILE
 SURVEYED BY
 PLOTTED BY
 CHECKED BY
 DATE
 NO.

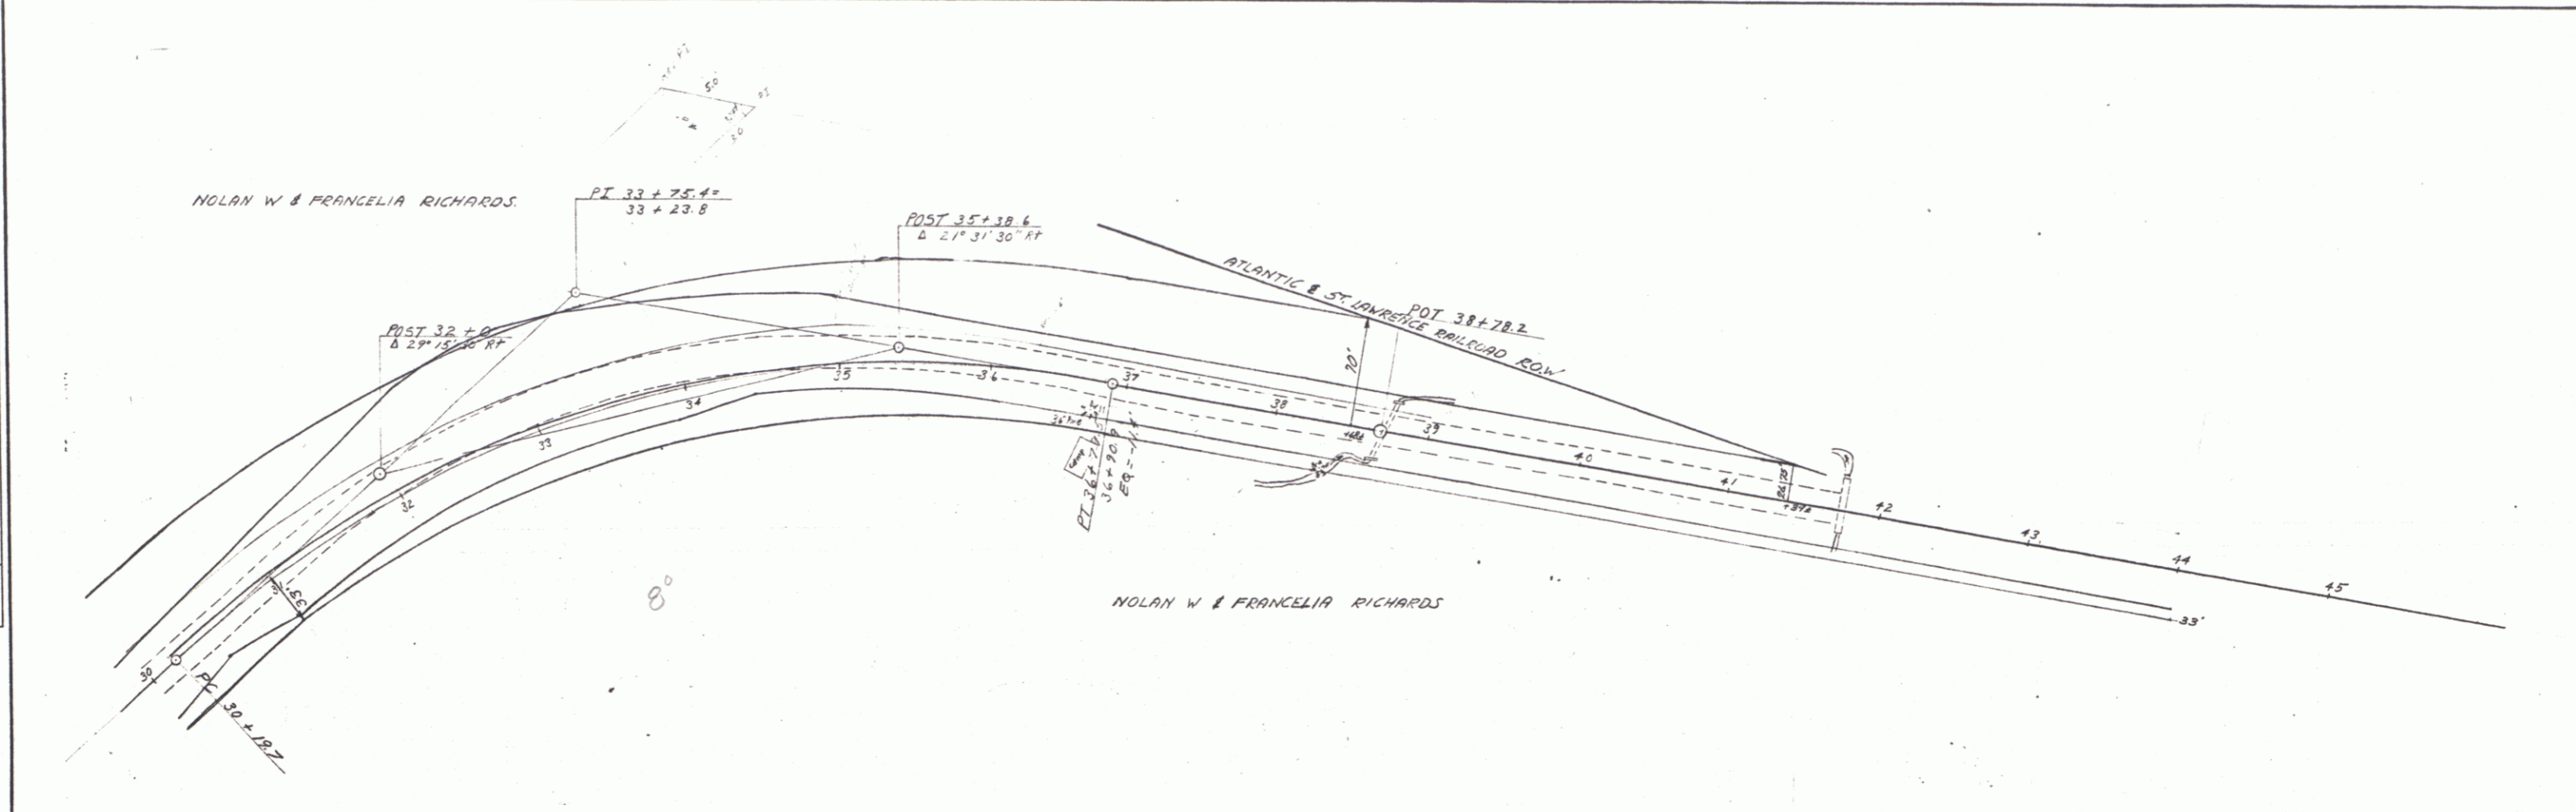

ST 139 (R)
 SHEET 3