
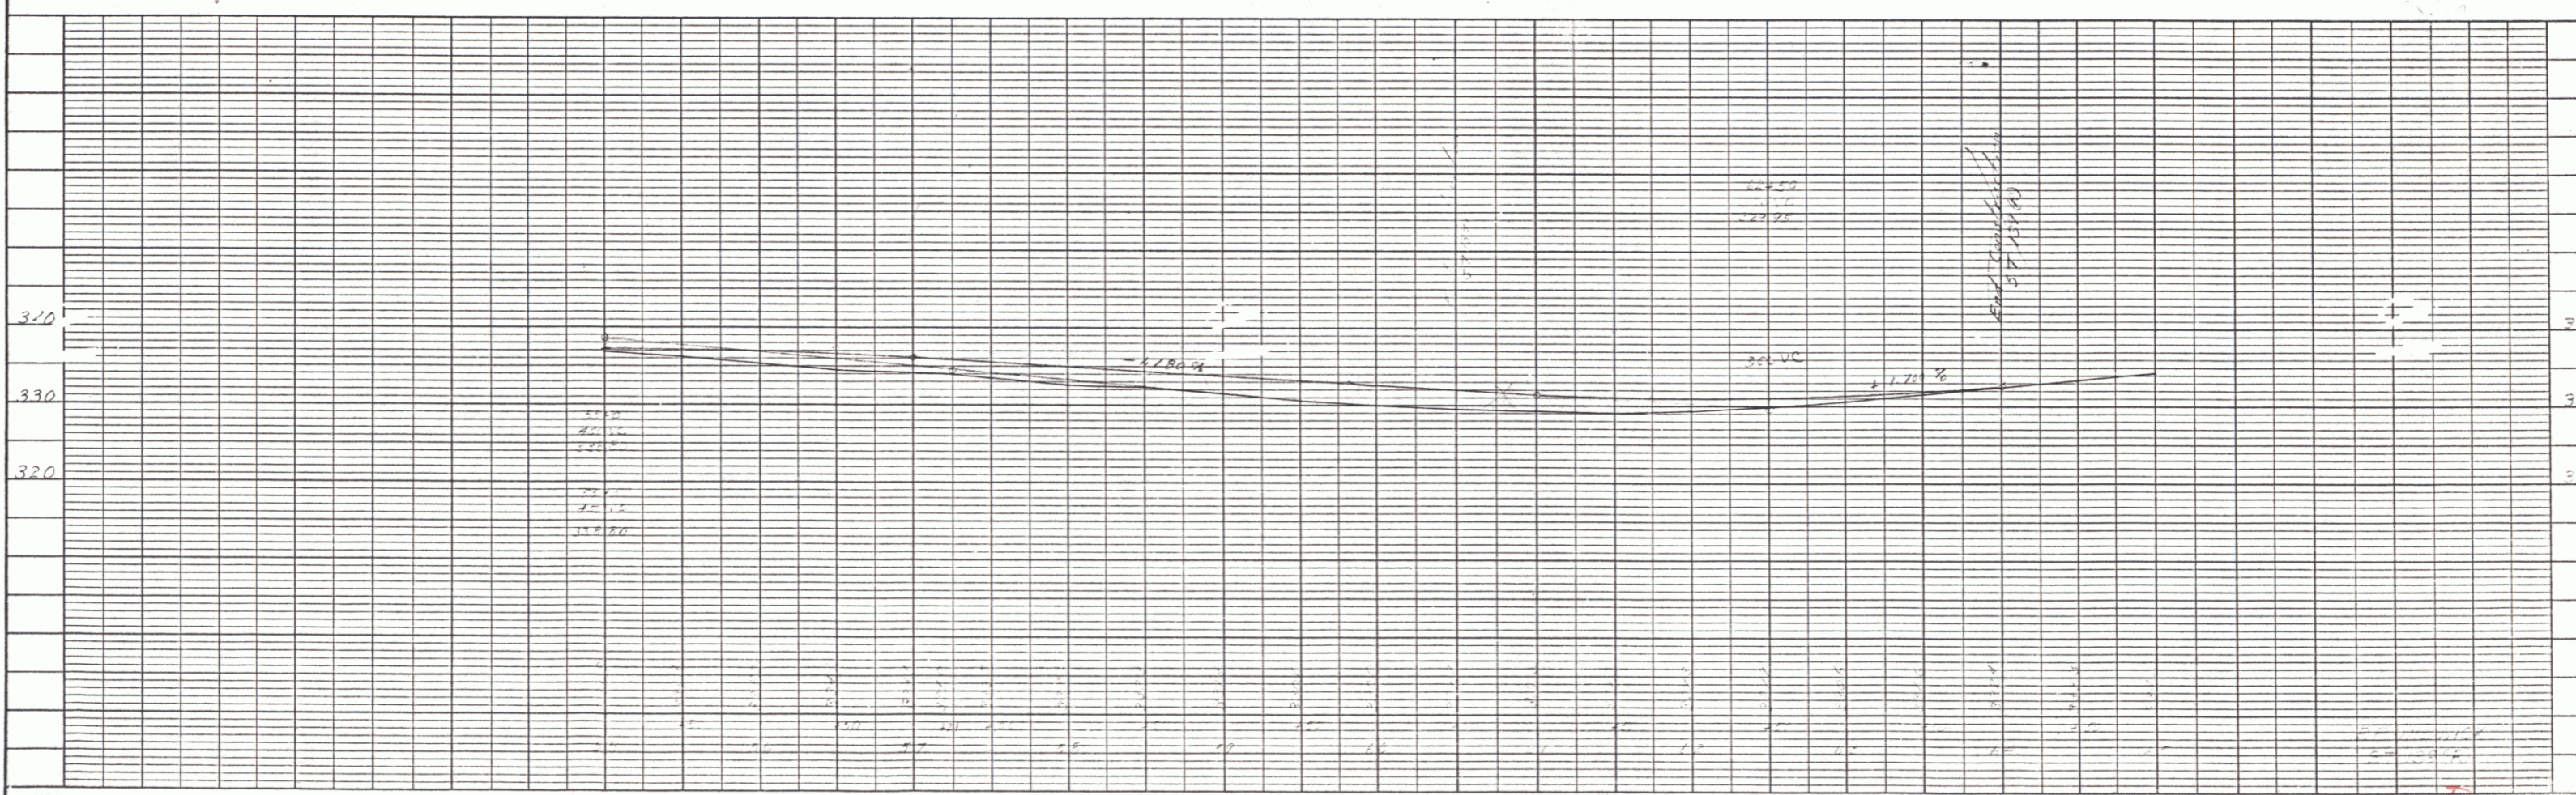


PLAN
 DRAWN BY: _____
 CHECKED BY: _____
 DATE: _____
 NO. _____
 NOTE BOOK _____
 BY SP. WAY CHECKED _____

PROFILE
 DRAWN BY: _____
 CHECKED BY: _____
 DATE: _____
 NO. _____
 NOTE BOOK _____
 BY SP. WAY CHECKED _____

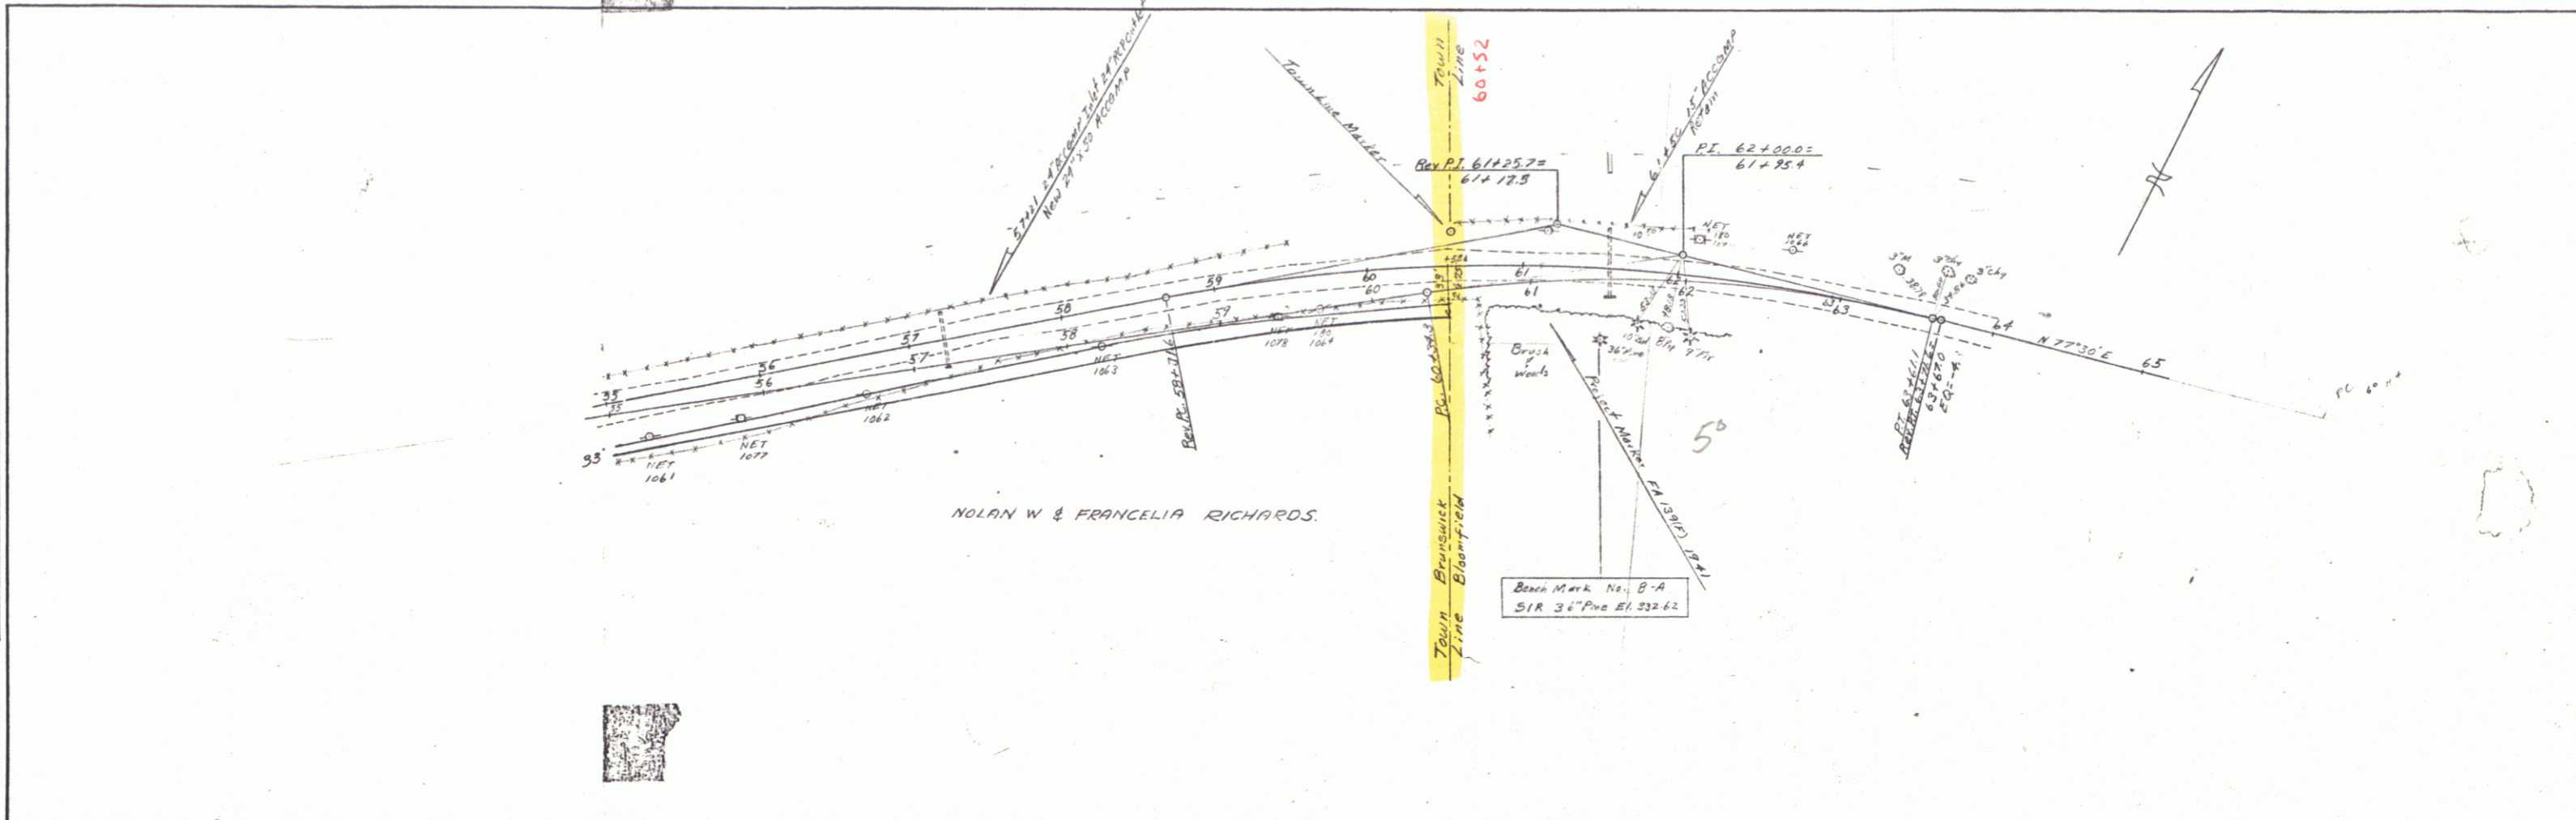

Shed No. 7