


POOR ORIGINAL COPY

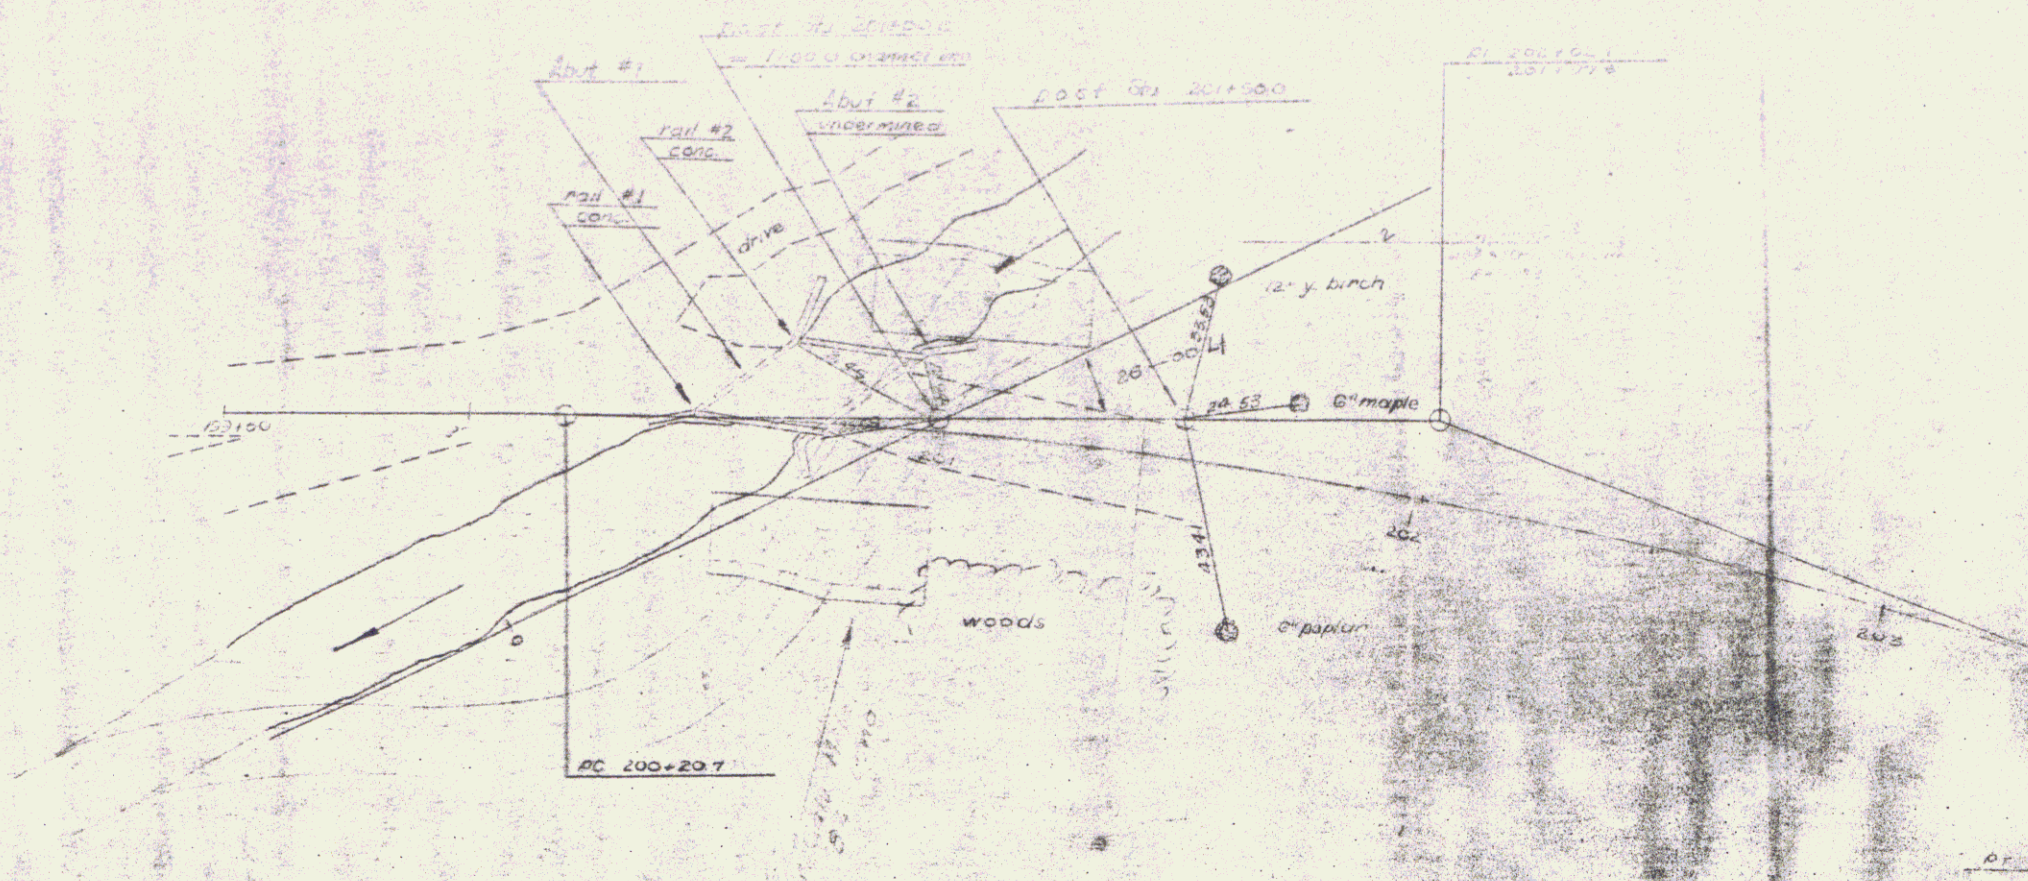

Br# 20?
M.P. 3.45

MP
 RIGHT-OF-WAY DIVISION
 TOWN FILE
 PERPETUAL
 Rte 4125
 Town of [unclear]
 (To Be Returned To R.O.W. Division)
 Hancock
 Hancock Bridge 18710
 SHEET 2

3