

CURVE No 102
 Δ 5° 58' 30" Lt
 D 2° 00'
 R 2864.79
 T 149.52
 L 288.75
 E 3.90

PI 582+24.89
 582+23.81


PI 587+42.38
 587+36.50

POI 572+43.85

PI 578+06.69
 578+06.40

CURVE No 103
 Δ 12° 32' 30" Rt
 D 7° 30'
 R 763.94
 T 83.95
 L 167.22
 E 4.58

CURVE No 104
 Δ 37° 35' 00" Rt
 D 14° 15'
 R 402.08
 T 136.81
 L 263.74
 E 22.64

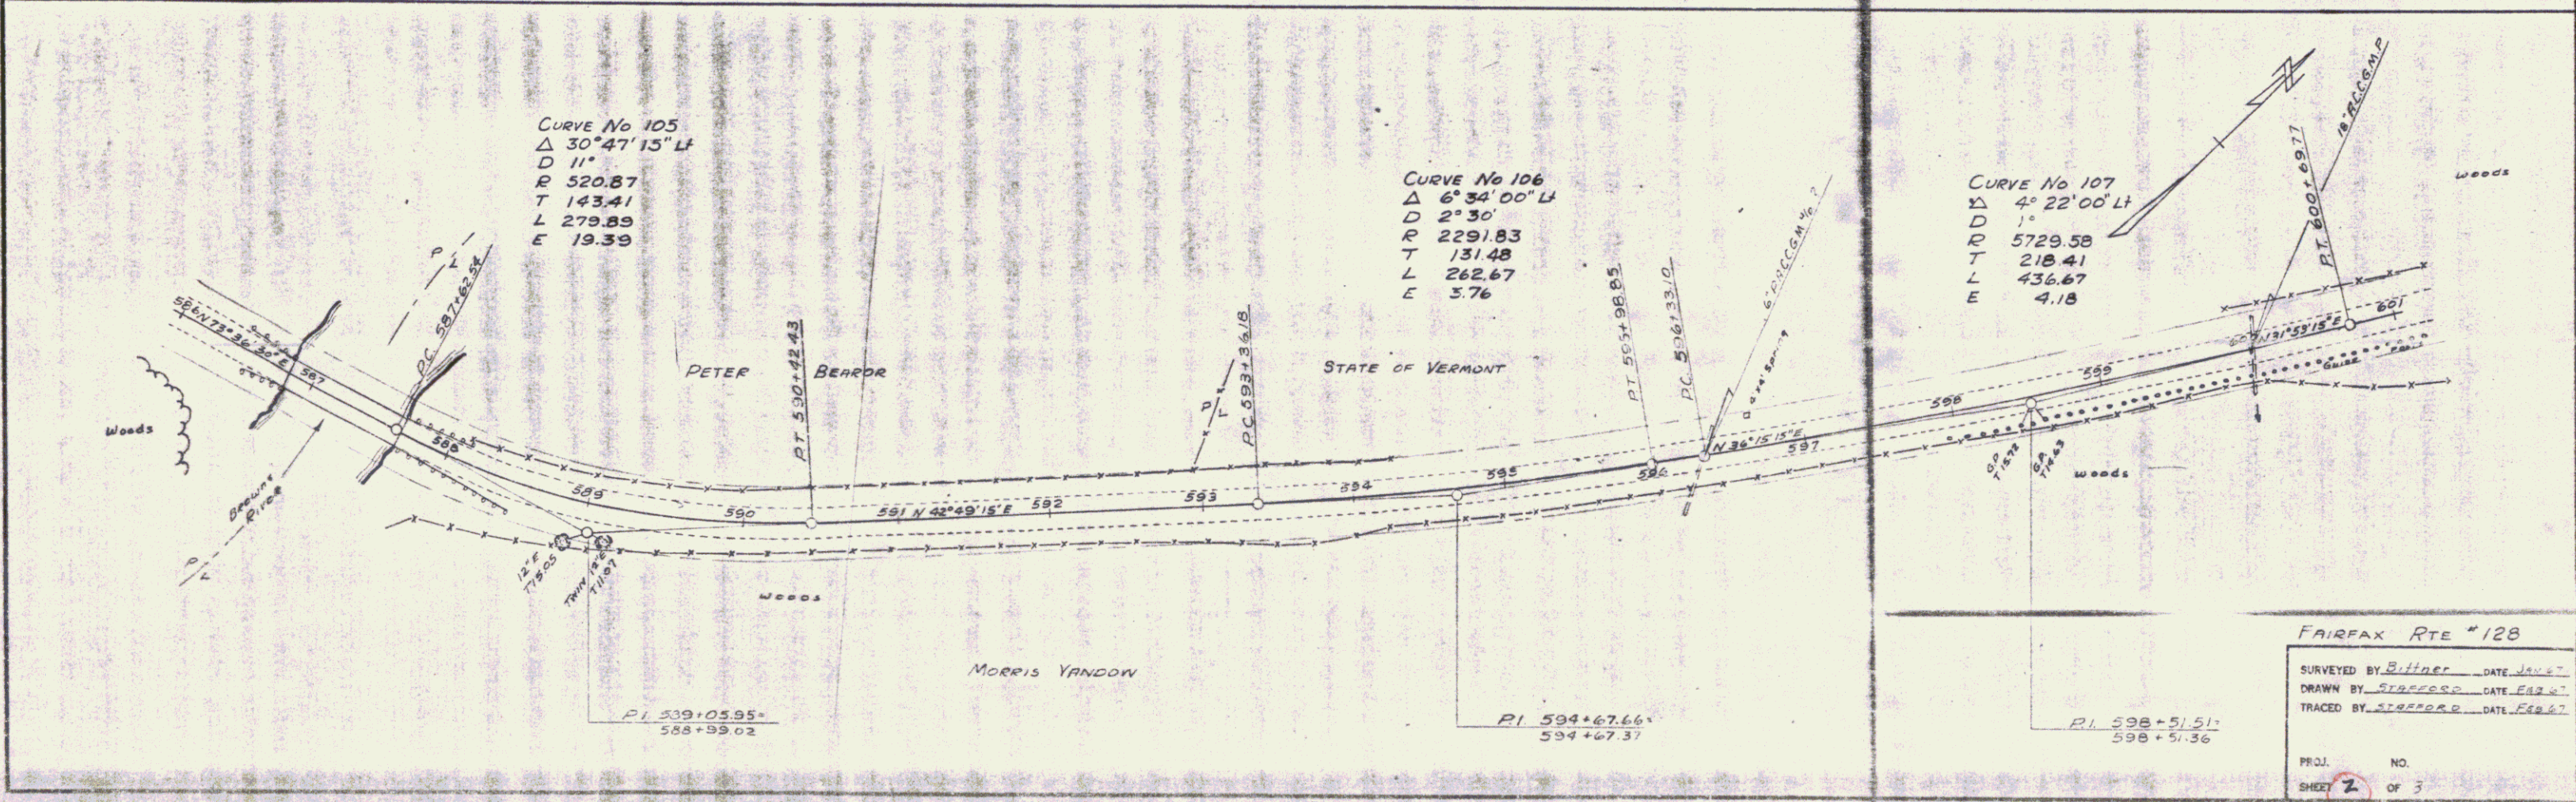

CURVE No 105
 Δ 30° 47' 15" Lt
 D 11°
 R 520.87
 T 143.41
 L 279.89
 E 19.39

CURVE No 106
 Δ 6° 34' 00" Lt
 D 2° 30'
 R 2291.83
 T 131.48
 L 262.67
 E 3.76

CURVE No 107
 Δ 4° 22' 00" Lt
 D 1°
 R 5729.58
 T 218.41
 L 436.67
 E 4.18

PI 539+05.95
 538+39.02

PI 594+67.66
 594+67.37

PI 598+51.51
 598+51.36

FAIRFAX RTE #128
 SURVEYED BY Bitter DATE Jan 67
 DRAWN BY Stefford DATE Feb 67
 TRACED BY Stefford DATE Feb 67
 PROJ. NO. _____
 SHEET 2 OF 3