


PLAN
 DRAWN BY
 CHECKED BY
 DATE

PROFILE
 DRAWN BY
 CHECKED BY
 DATE

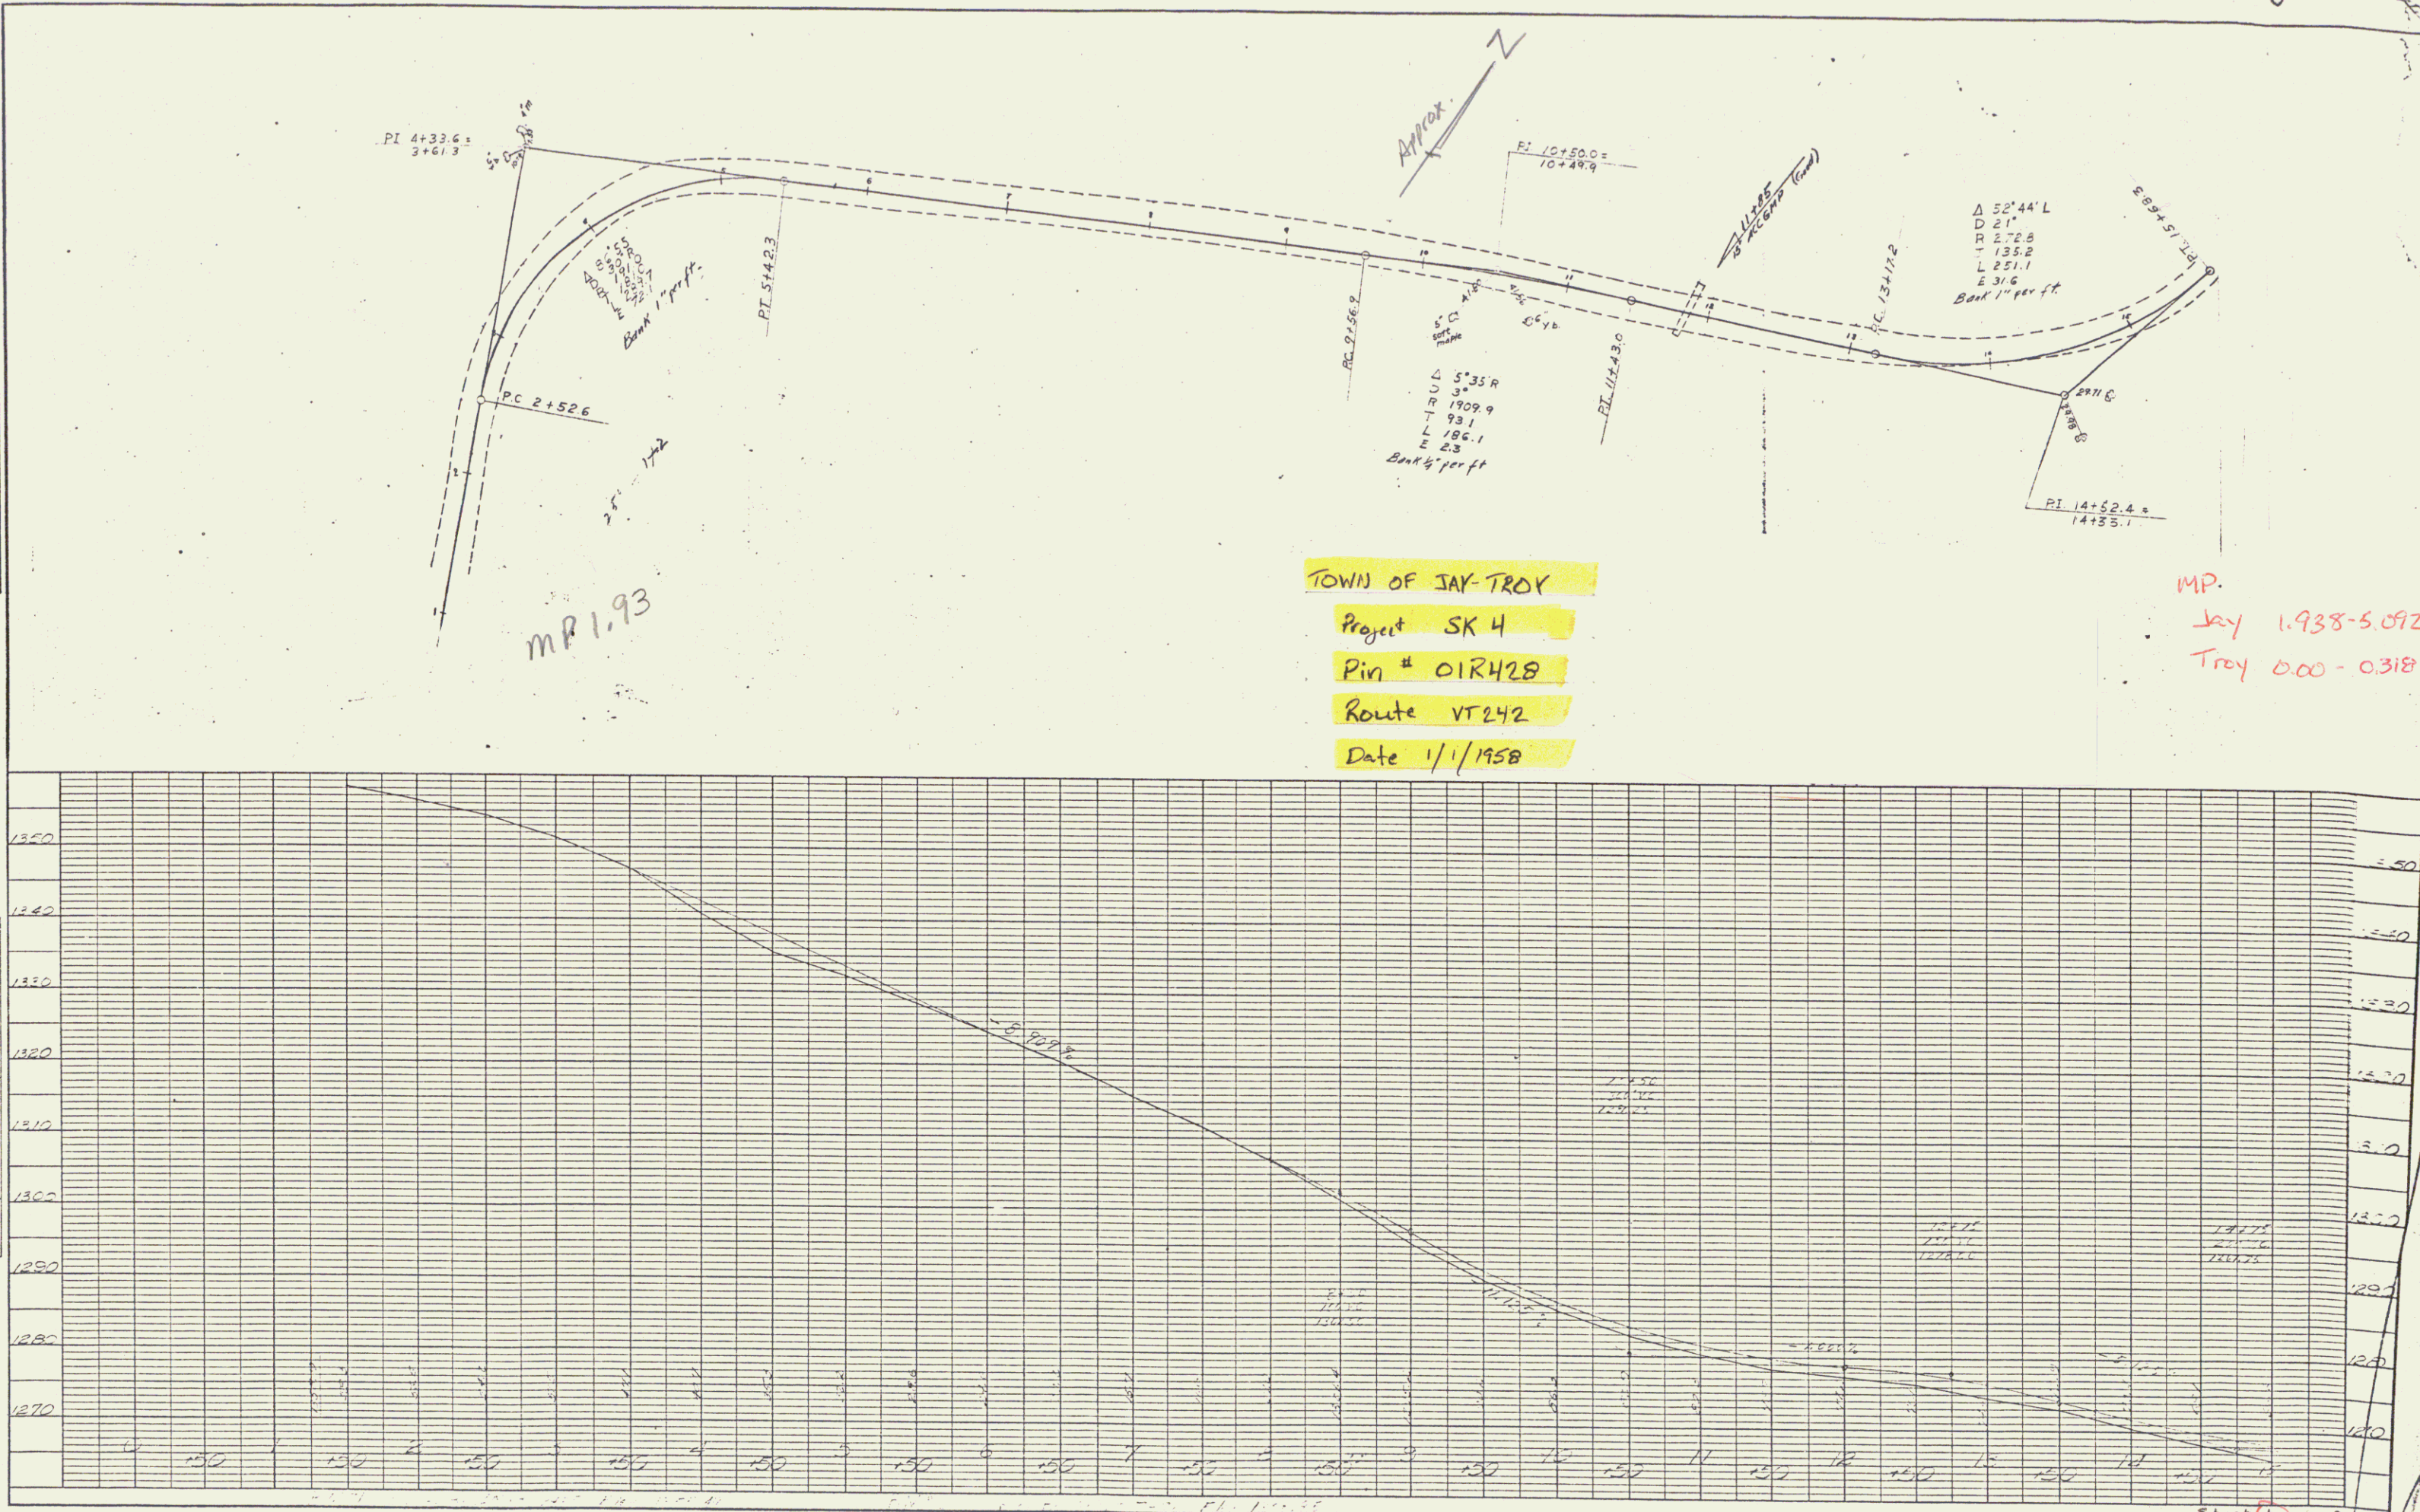

TOWN OF JAY-TROY
 Project SK 4
 Pin # 01R428
 Route VT 242
 Date 1/1/1958

MP.
 Jay 1.938-5.092
 Troy 0.00-0.318