

DATE	
BY	
CHECKED	
ADJUSTMENT CHECKED	
NO. OF THIS SHEET	
PLAN	
NO.	

DATE	
BY	
CHECKED	
ADJUSTMENT CHECKED	
NO. OF THIS SHEET	
PROFILE	
NO.	

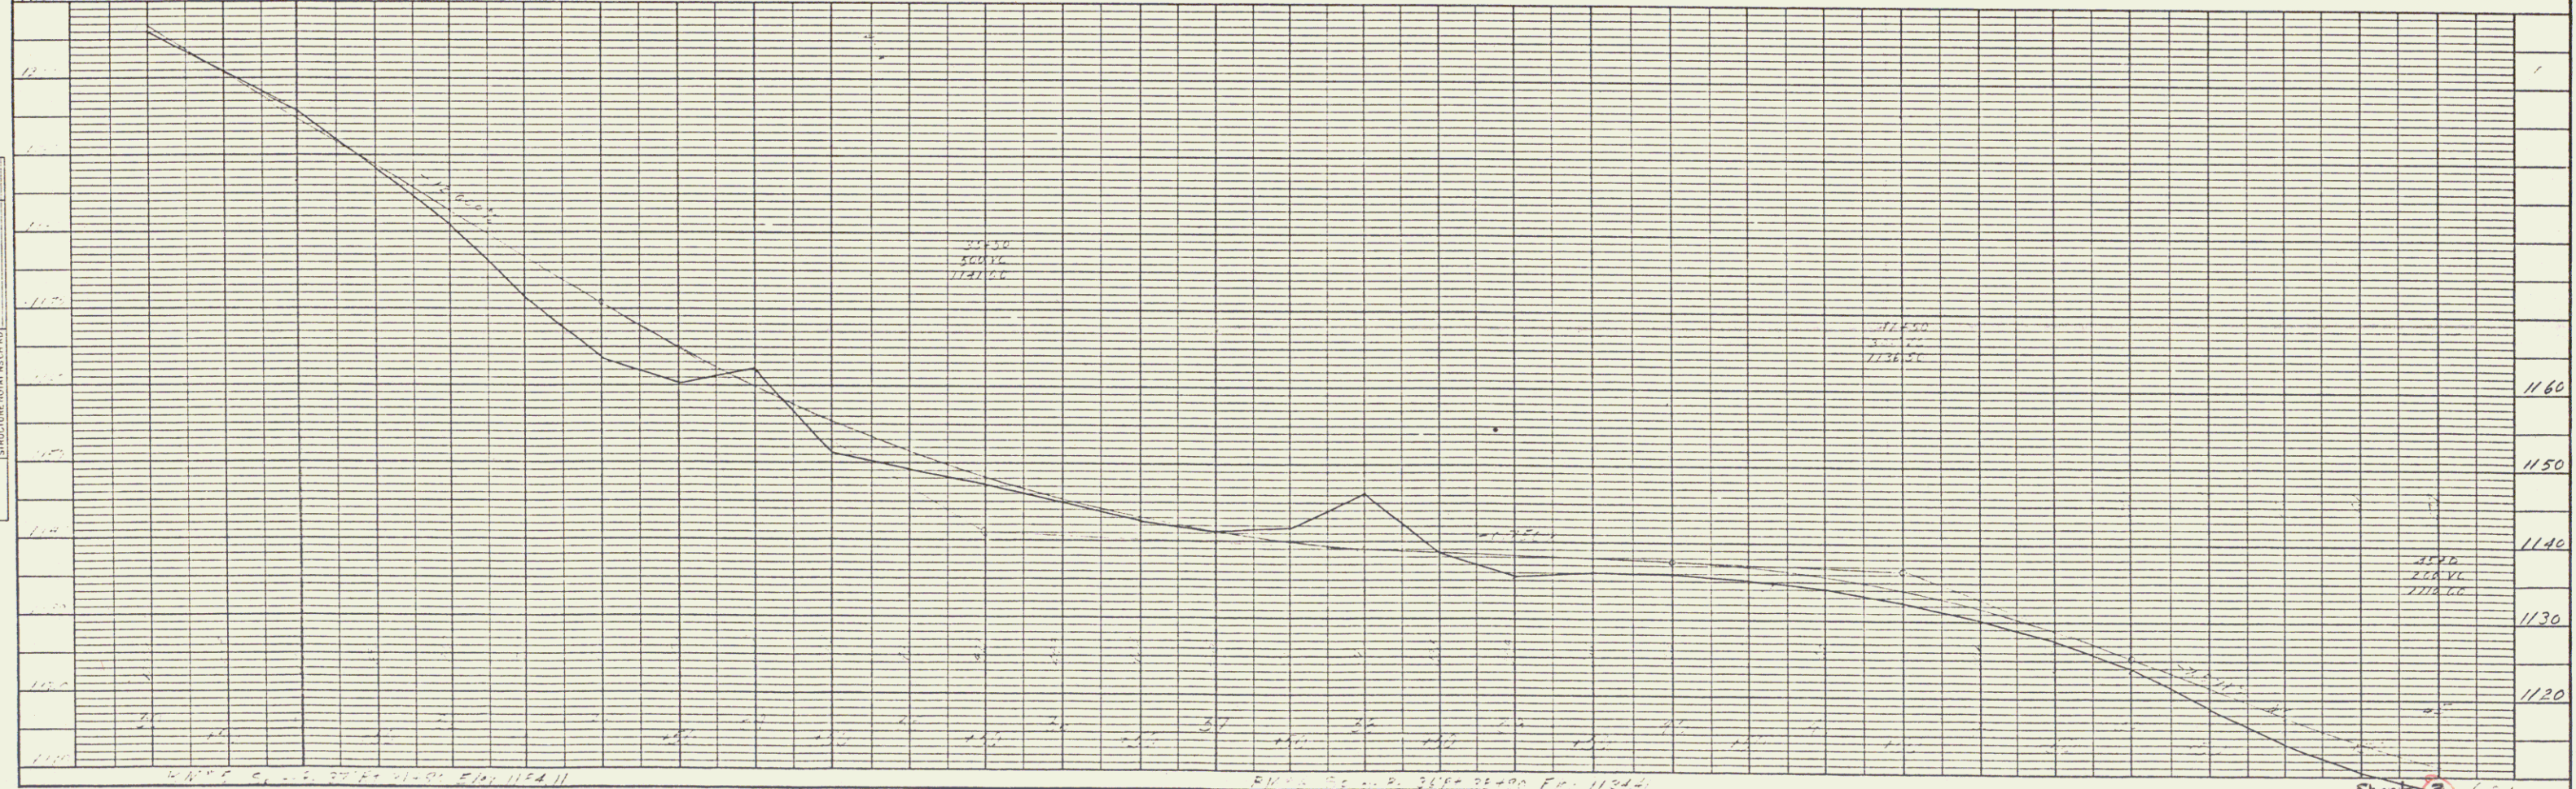
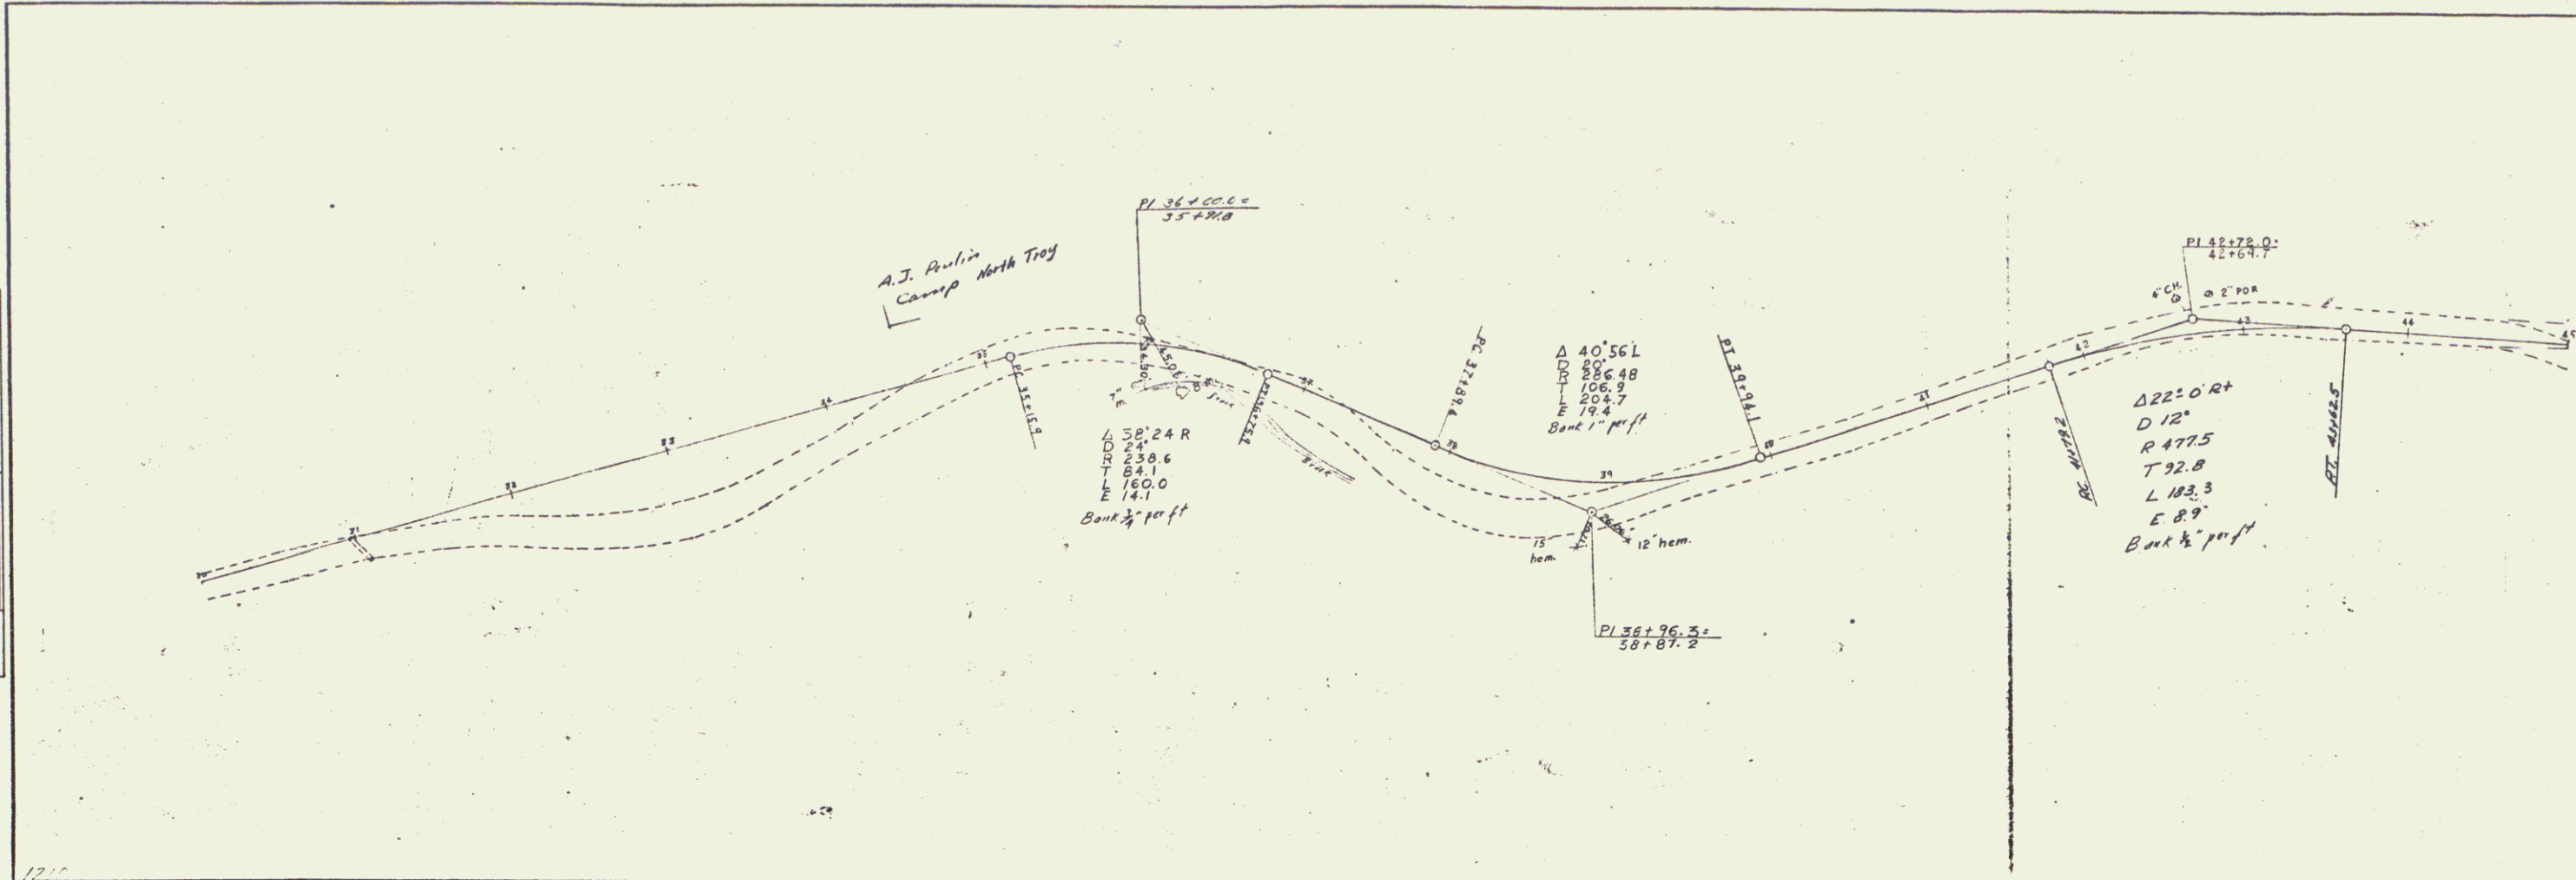


PLATE 1 - PLAN - PROFILE O.P.R. & E. STANDARD
KELFEL & ESTER CO. NEW YORK
E & E CO. NO. 3451

Sheet 3 of 1
JAY SK4