


DATE	
BY	
DESIGNED	
PLANNED	
NOTED	
CHECKED	
BY	
NO. OF THIS CHECKED	
NO.	
PLAN	

DATE	
BY	
DESIGNED	
PLANNED	
NOTED	
CHECKED	
BY	
NO. OF THIS CHECKED	
NO.	
PROFILE	

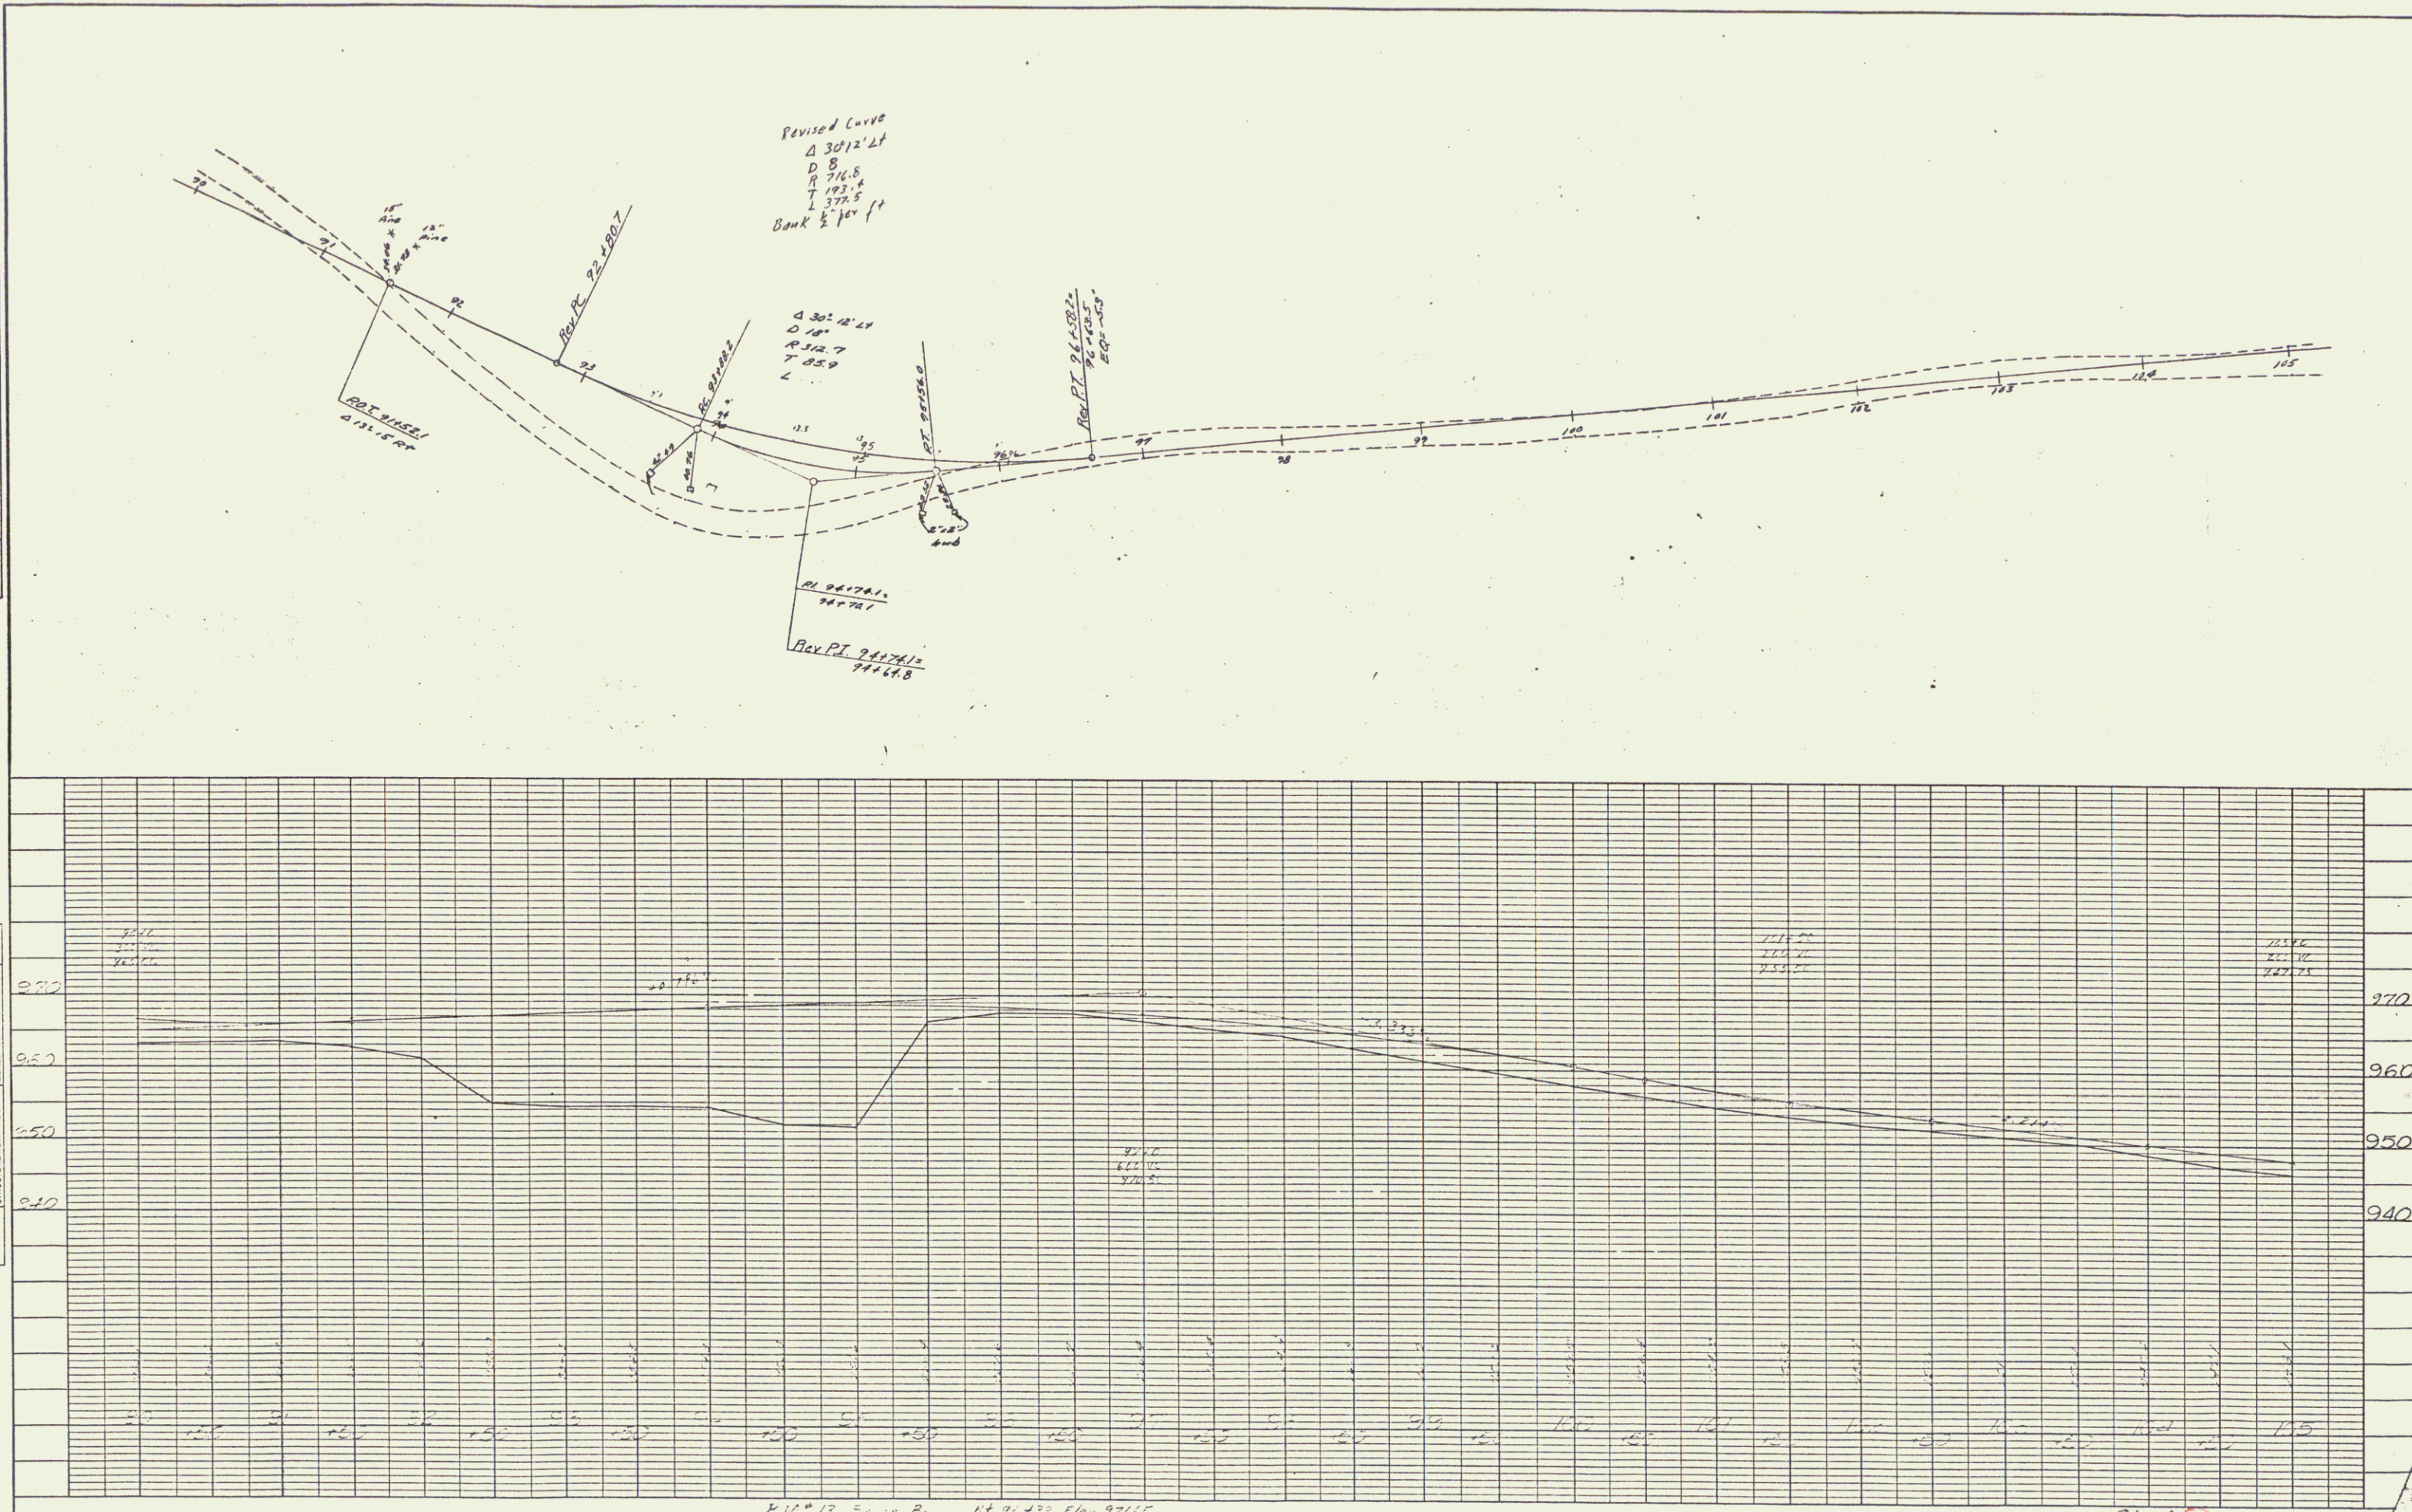

P. 12" x 12" E. of P. 11' 91.430 Elev. 971.15

PLATE 1 - PLAN - PROFILE - D. P. & R. E. STANDARD
 KEUFFEL & ESSER CO., NEW YORK
 E. & E. CO. NO. 3453

Sheet 2 of 4
 JAY SK 4