
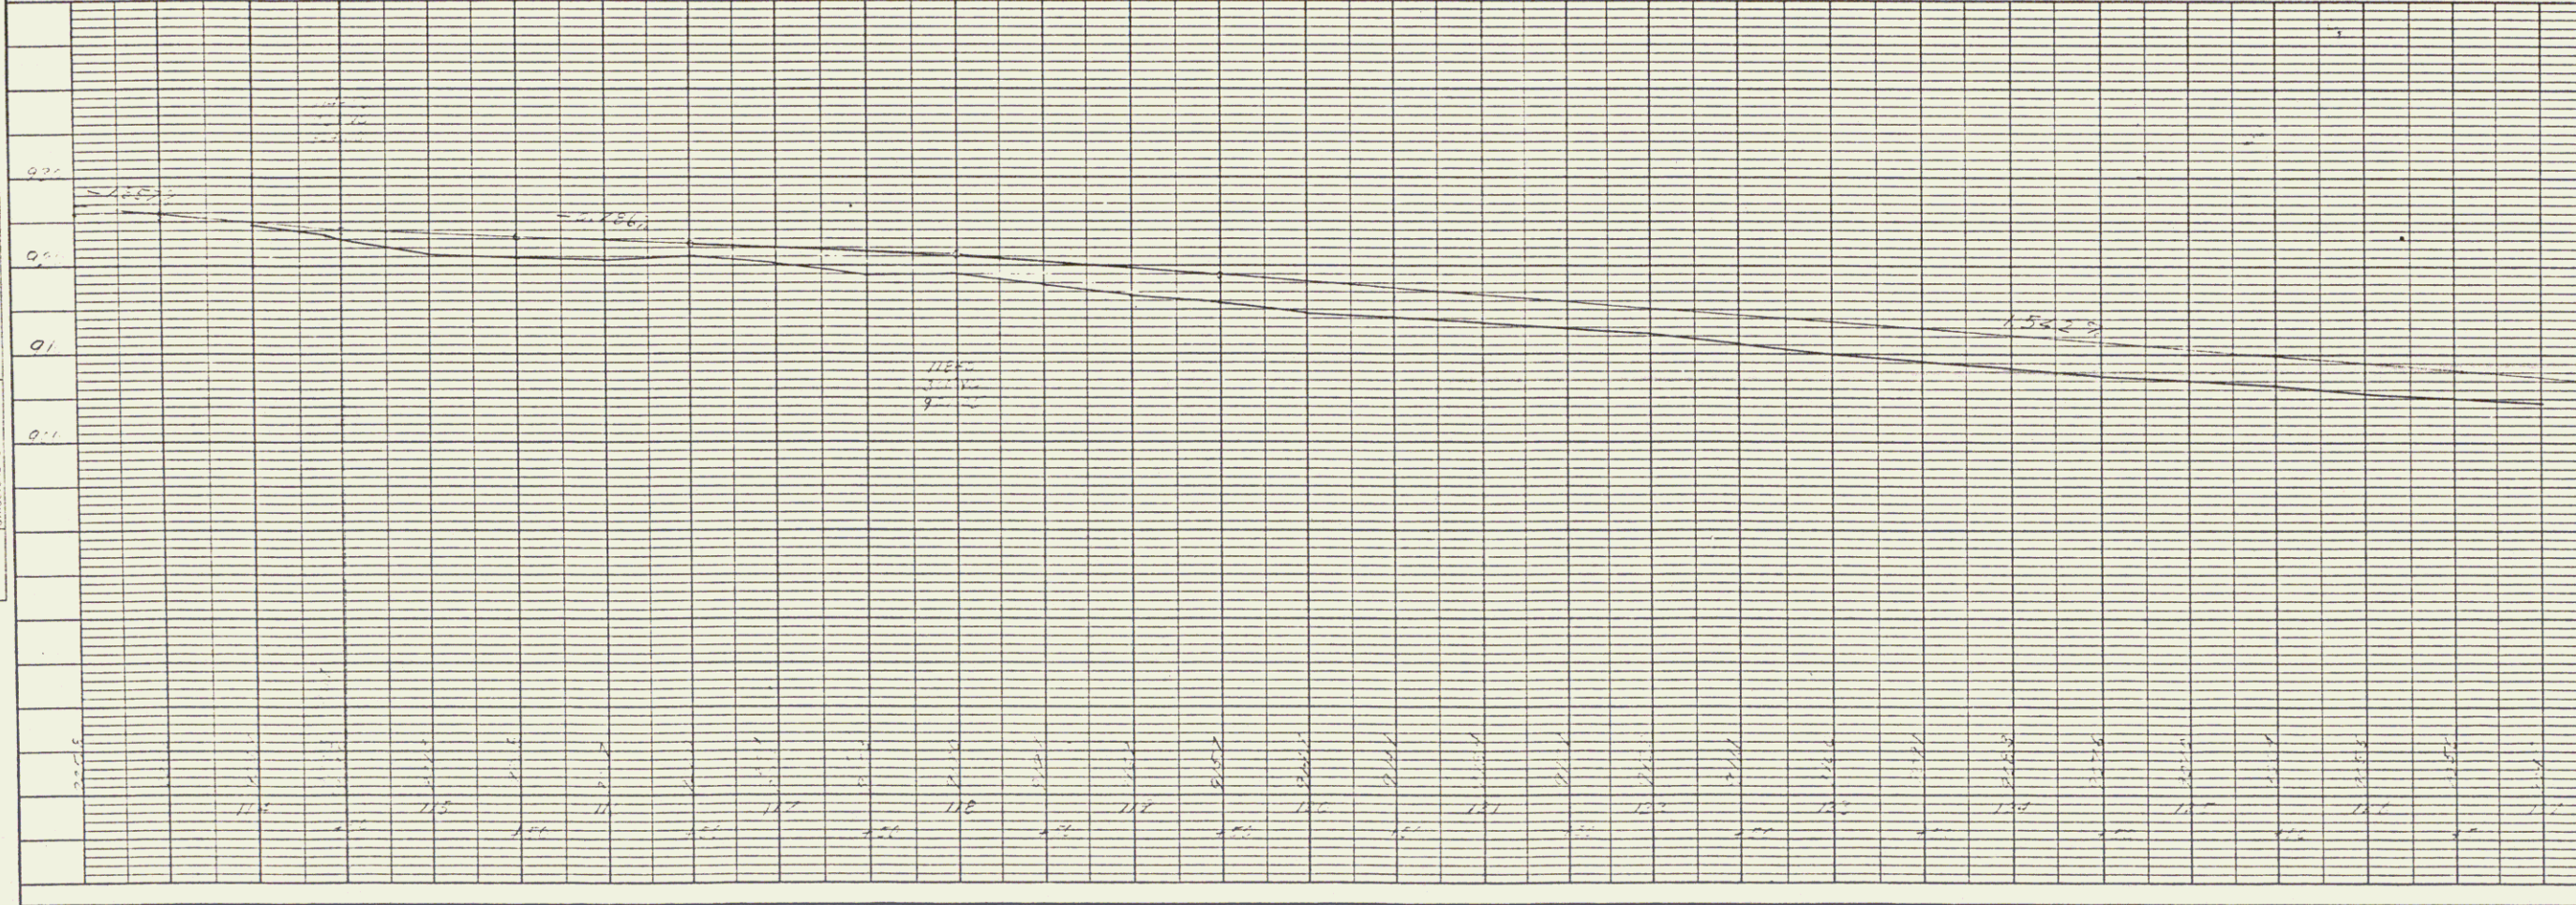


PLAN
 SUBMITTED BY
 DATE
 NOTE BOOK NO.
 ALIGNED CHECKED BY
 RT. OF WAY CHECKED BY

PROFILE
 SUBMITTED BY
 DATE
 NOTE BOOK NO.
 GRADES CHECKED BY
 ELEVATION IN FEET (VERTICAL CURVE)

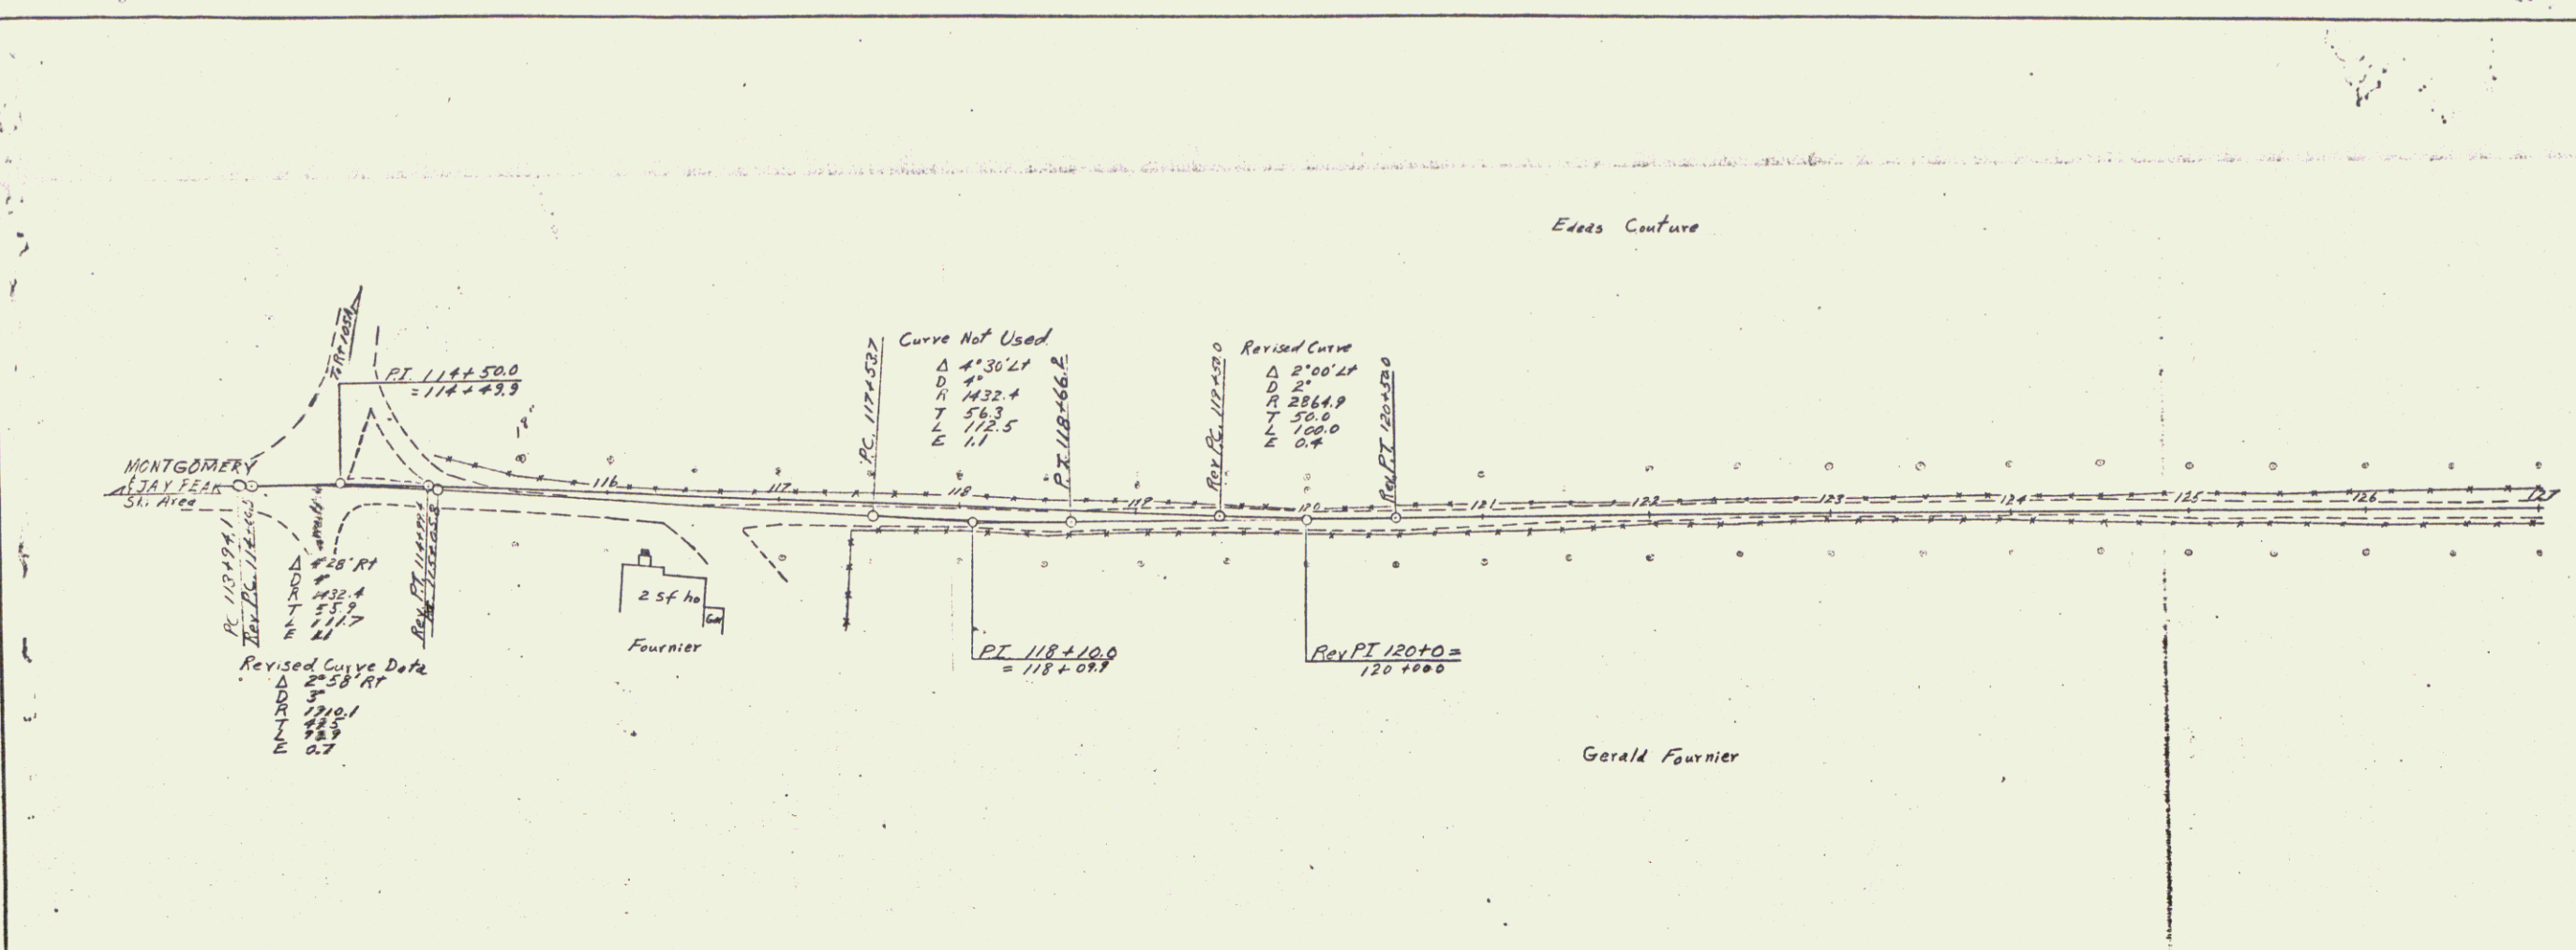

JAY TROY
 EXD
 Sheet 9