


DATE	
BY	
PROJECT	
DESIGNER	
PLANNER	
CHECKED	
DATE	
NO.	

DATE	
BY	
PROJECT	
DESIGNER	
PLANNER	
CHECKED	
DATE	
NO.	

VT 242

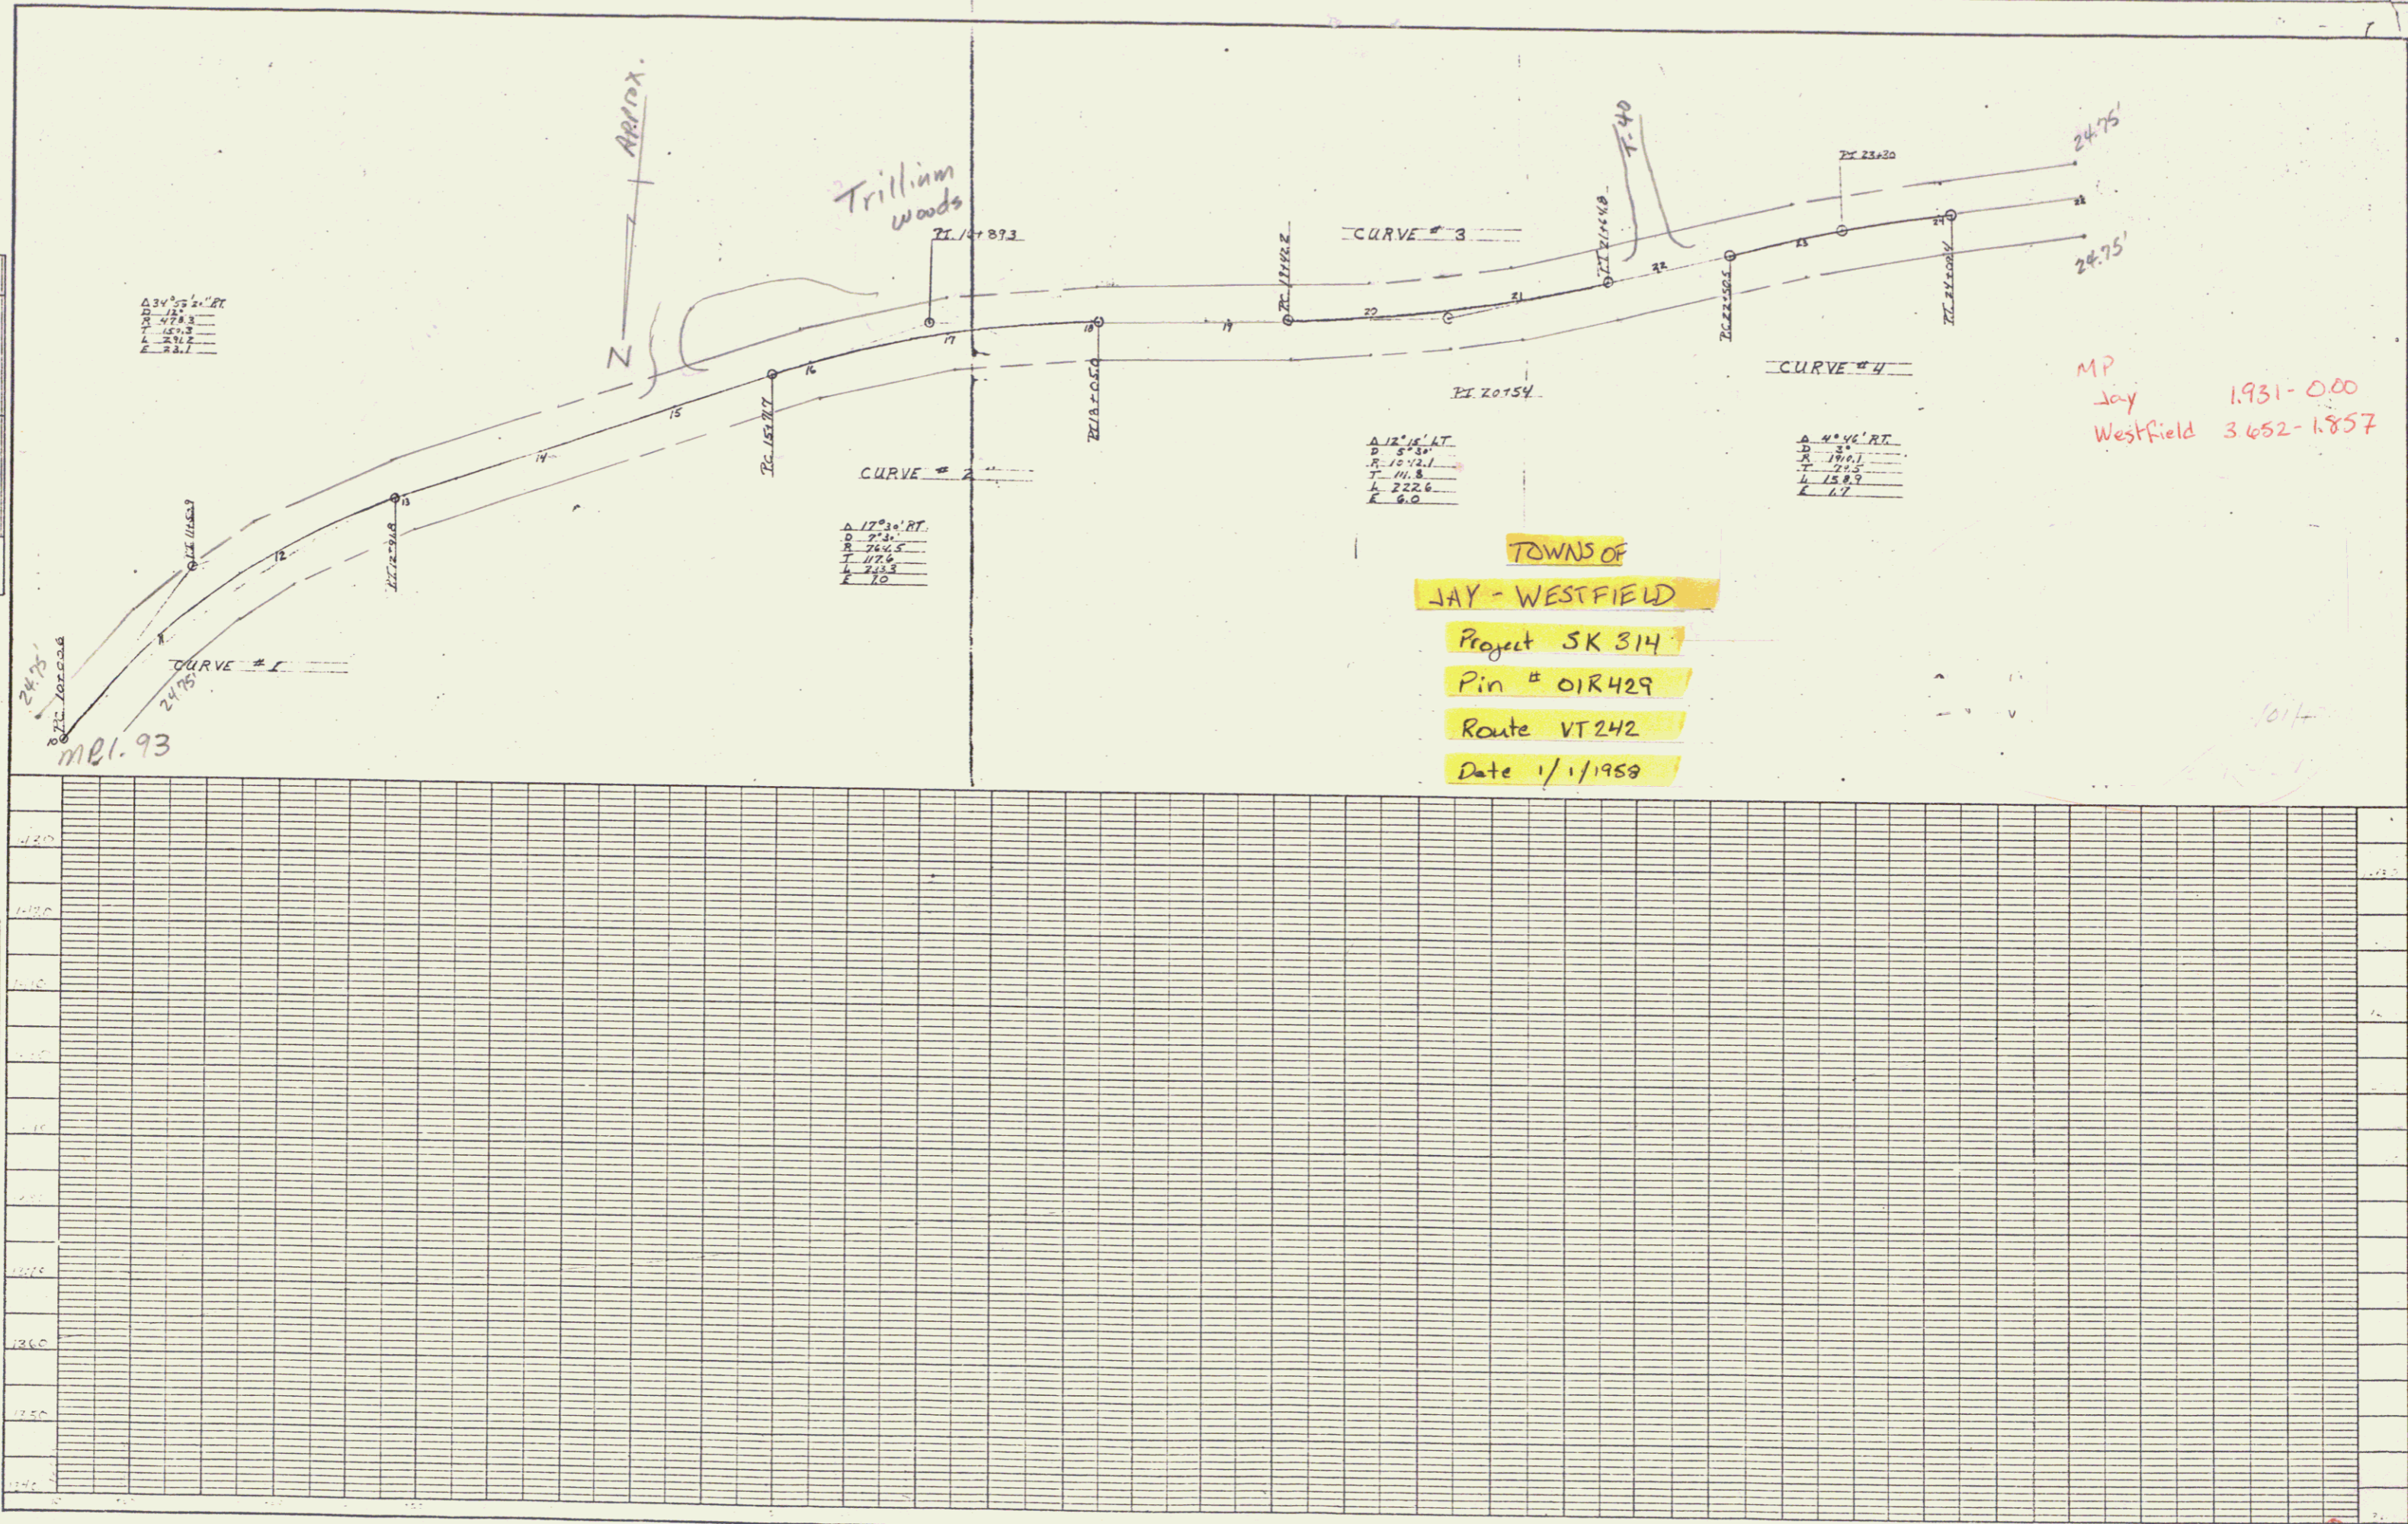

$\Delta 17^{\circ}30' RT$   
 $D 274$   
 $R 246.5$   
 $T 11.8$   
 $L 222.0$   
 $E 6.0$

$\Delta 12^{\circ}16' RT$   
 $D 574$   
 $R 190.1$   
 $T 11.8$   
 $L 222.0$   
 $E 6.0$

$\Delta 4^{\circ}46' RT$   
 $D 234$   
 $R 190.1$   
 $T 11.8$   
 $L 222.0$   
 $E 6.0$

TOWNS OF  
**JAY - WESTFIELD**  
 Project SK 314  
 Pin # 01R429  
 Route VT 242  
 Date 1/1/1958

MP  
 Jay 1.931-0.00  
 Westfield 3.652-1.857