


MATCHLINE STA 62+25

SOIL INFORMATION
RUMNEY VERY FINE SANDY
LOAM, 0-2% SLOPES
HYDROLOGIC SOIL GROUP C
LAND IS HIGHLY ERODIBLE

SOIL INFORMATION
COMBINED W/ 38B GROGHAN
LOAMY FINE SAND 3-8%
SLOPE, HYDROLOGIC SOIL-
INS GROUP B, HIGHLY ERODIBLE
(DRY HYDRANT)

LEGEND

CLASS II WETLAND	▲▲▲▲
EXISTING COUNTOURS	— 1020 —
SOIL BOUNDARY	-----
WETLAND BUFFER ZONE	—▲▲—
AGRICULTURAL	AG AG

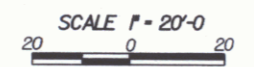

APR 19 2010

FINAL CONDITIONS SITE PLAN (2)

PROJECT NAME:	Canaan	PLOT DATE:	03-AUG-2007
PROJECT NUMBER:	ER ST 0271(16)	DRAWN BY:	T. Husk
FILE NAME:	Structures\X04c098erobdr.d	CHECKED BY:	
PROJECT LEADER:	M. Evans-Mongeon	DESIGNED BY:	S. Scribner
DESIGNED BY:	S. Scribner	ROW SHEET	12 OF 15

CONTOURS SHOWN ARE EXISTING CONTOURS,
SEE CROSS SECTIONS FOR PROPOSED CONTOURS.