

STATE OF VERMONT
AGENCY OF TRANSPORTATION




R. O. W. PLANS

PROPOSED IMPROVEMENT
TOWN OF HARDWICK
COUNTY OF CALEDONIA
VT. ROUTE 15 (MINOR ARTERIAL)

BEGINNING AT A POINT ON VT. ROUTE 15, EAST OF THE INTERSECTION OF GLENSIDE AVE. AT MILEMARKER 3.63, IN THE TOWN OF HARDWICK, AND EXTENDING EASTERLY 0.11 MILES TO MILEMARKER 3.74
WORK TO BE PERFORMED UNDER THIS PROJECT INCLUDES MINOR RE-ALIGNMENT OF VT. 15, INSTALLING A COUNTERBERM FOR SLOPE STABILIZATION, DRAINAGE, GUARDRAIL, PAVEMENT AND OTHER RELATED ROADWAY ITEMS.

LENGTH OF ROADWAY 594 FT = 0.11 MI
LENGTH OF PROJECT 594 FT = 0.11 MI
LENGTH OF ROW PROJECT 794.66 FT = 0.15 MI

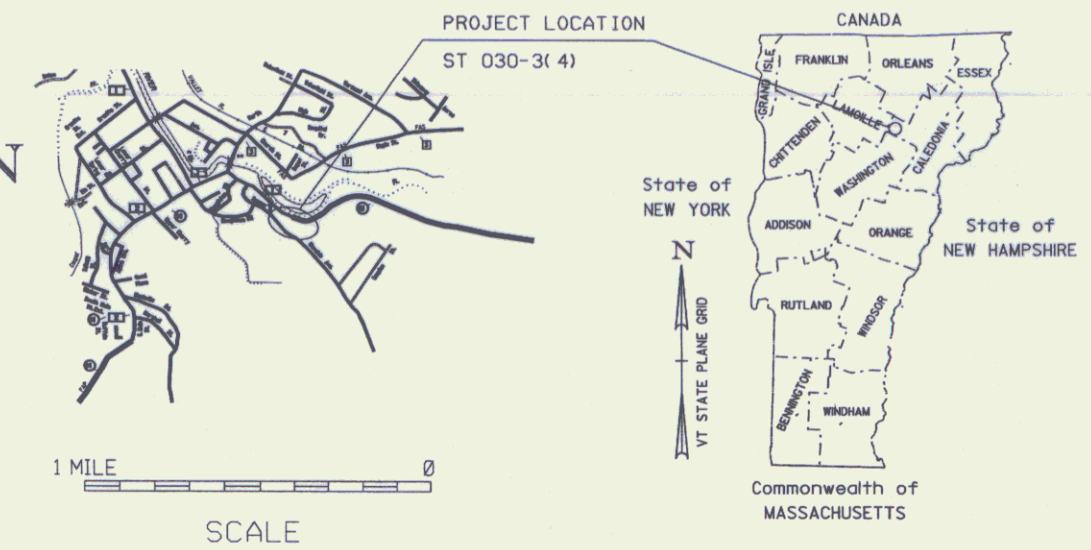

BEGIN R.O.W. PROJECT

ST 030-3(4)
STA. 197+50.00 24.65' LT.


END R.O.W. PROJECT

ST 030-3(4)
STA. 205+44.66 38.13' LT.

CONVENTIONAL SYMBOLS	
COUNTY LINE	— — — — —
TOWN LINE	— — — — —
LIMITS OF ACCESS	— — — — —
POINT OF ACCESS	X
FENCE LINE	X — X — X — X — X
STONE WALL	— — — — —
TRAVELED WAY	— — — — —
GUARD RAIL	— — — — —
RAILROAD	— — — — —
SURVEY LINE	— — — — —
CULVERT	— — — — —
POWER POLE	⊕
TELEPHONE POLE	⊕
TREES	⊕
CONTROL OF ACCESS	— — — — —
PROPERTY LINE	— — — — —
R.O.W. TAKING LINE	— — — — —
SLOPE RIGHTS	SR
TOP OF CUT	— — — — —
TOE OF SLOPE	— — — — —

SURVEYED BY : R. GILMAN
SURVEYED DATE : DEC. 2004

DATUM
VERTICAL NAVD 88
HORIZONTAL NAD 83 (96)

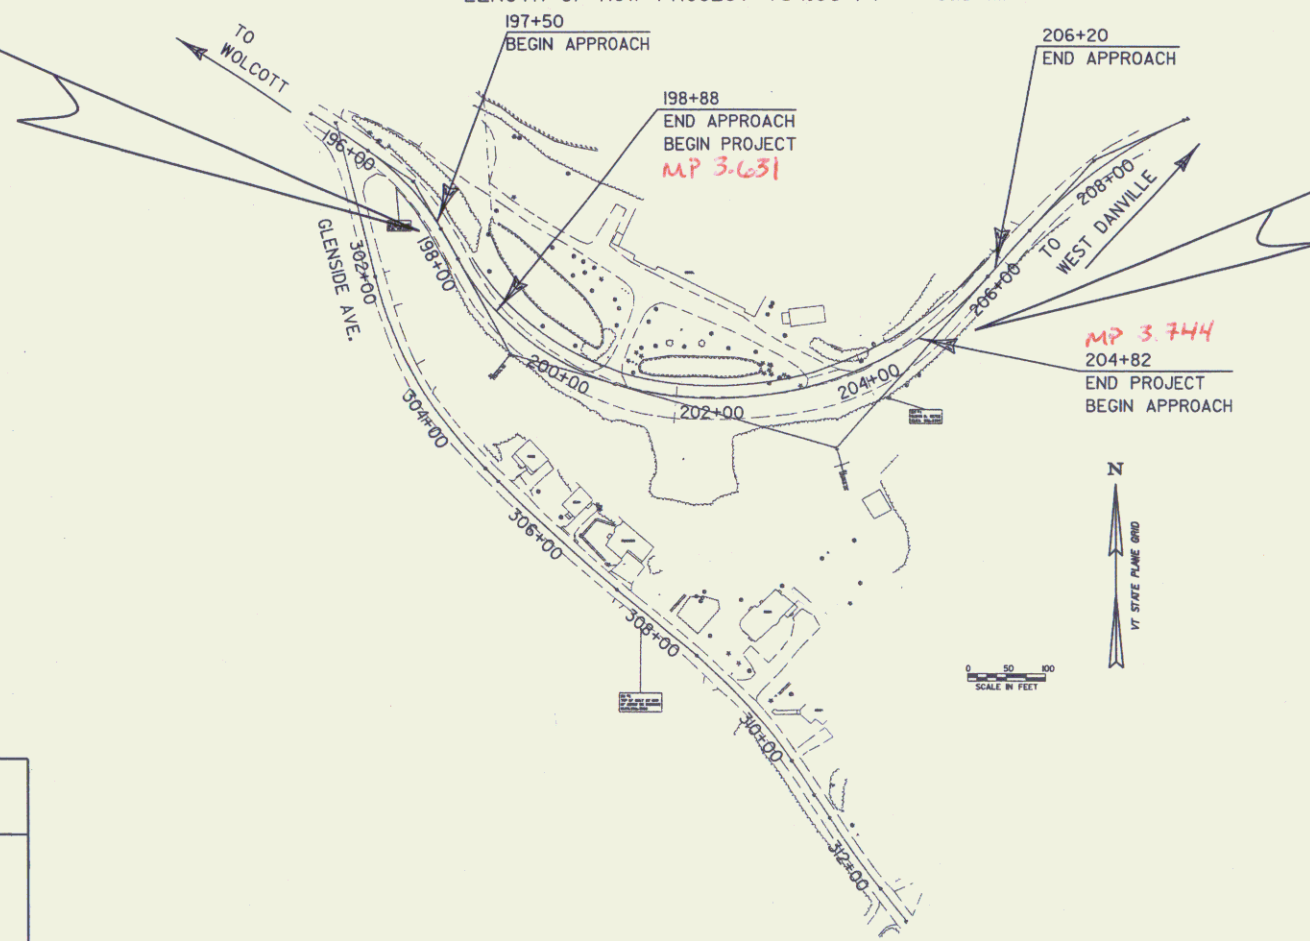

ALL DRIVES AS INDICATED ON PLANS ARE SUBJECT TO PERMITS PURSUANT TO TITLE 19 SECTION III, V.S.A.

Lines shown on this plan as existing property lines P/L are believed to be accurate but should not be relied upon for purposes unrelated to the State of Vermont's acquisition of land and rights for this project.

THESE PLANS ARE SUBJECT TO SUCH ENGINEERING CHANGES AS MAY BE REQUIRED BY THE DIRECTOR OF PROGRAM DEVELOPMENT.
CONSTRUCTION IS TO BE CARRIED ON IN ACCORDANCE WITH THESE PLANS AND THE STANDARD SPECIFICATIONS FOR CONSTRUCTION DATED 2001 AS APPROVED BY THE FEDERAL HIGHWAY ADMINISTRATION ON JANUARY 4, 2001 FOR USE ON THIS PROJECT, INCLUDING ALL SUBSEQUENT REVISIONS AND SUCH REVISED SPECIFICATIONS AND SPECIAL PROVISIONS AS ARE INCORPORATED IN THESE PLANS.
FILE NAME: d040a060bdr.dgn
IPARM NAME: d040a0601.t.t.

Pin # CHE060

APPROVED *Richard J. Edwards* DATE 7/15/05
Director of Program Development

APPROVED *William J. Moore* DATE 7/15/05
Chief of Right of Way

HARDWICK
ST 030-3(4)
R.O.W. SHEET 1 OF 8 SHEETS