

DELINEATORS W/ STEEL POSTS

199+00	LT	&	RT	2
200+00	LT	&	RT	2
201+00	LT	&	RT	2
202+00	LT	&	RT	2
203+00	LT	&	RT	2
204+00	LT	&	RT	2
205+00	LT	&	RT	2

14 EA

REMOVE AND RESETTING LIGHT POLE (MOD. - FLAG POLE)
200+33 - 200+49 LT (3 EA)

CONSTRUCT DRIVE
200+60 LT 24' PAVED
YIELDING MARKER POSTS
10 EA

STEEL BEAM GUARDRAIL
203+00 - 206+25 LT 325'
80 214.5
ANCHOR FOR STEEL BEAM GUARDRAIL
1 EA
REMOVAL AND DISPOSAL OF GUARDRAIL
205+60 - 206+25 LT
60

STONE FILL, TYPE SLOPE STABILIZATION
200+60 - 203+20
STONE FILL, TYPE SLOPE STABILIZATION
200+60 - 203+20
REMOVAL AND DISPOSAL OF GUIDE POSTS
206+20 +/- LT
PLUG EXISTING


ML CURVE #2 DATA
Δ = 45°46'18.45" LT
D = 17°08'21.43"
R = 334.29
T = 141.11
L = 267.06
E = 28.56
BANK = 0.080 FT / FT

LEGEND:
INCLINOMETER (EXISTING) - INCL (E) ○
INCLINOMETER (NEW) - INCL (N) ○ (50' EA)
MONITORING WELL (EXISTING) - MW (E) ♦
MONITORING WELL (NEW) - MW (N) ♦ (20' EA)

STA 204+00 55' - 1
ADDED 8" UD X 12" LF
8" UD (55' - 136' LT)
40' CARRIER (136' - 1
DI W/ GRATE

ML CURVE #3 DATA
Δ = 64°13'49.2"
D = 12°00'42.10"
R = 477.00
T = 299.40
L = 534.73
E = 86.18
BANK = 0.080 FT

ML CURVE #1 DATA
Δ = 28°19'56.42" RT
D = 20°06'13.62"
R = 285.00
T = 71.94
L = 140.93
E = 8.94
BANK = 0.080 FT / FT

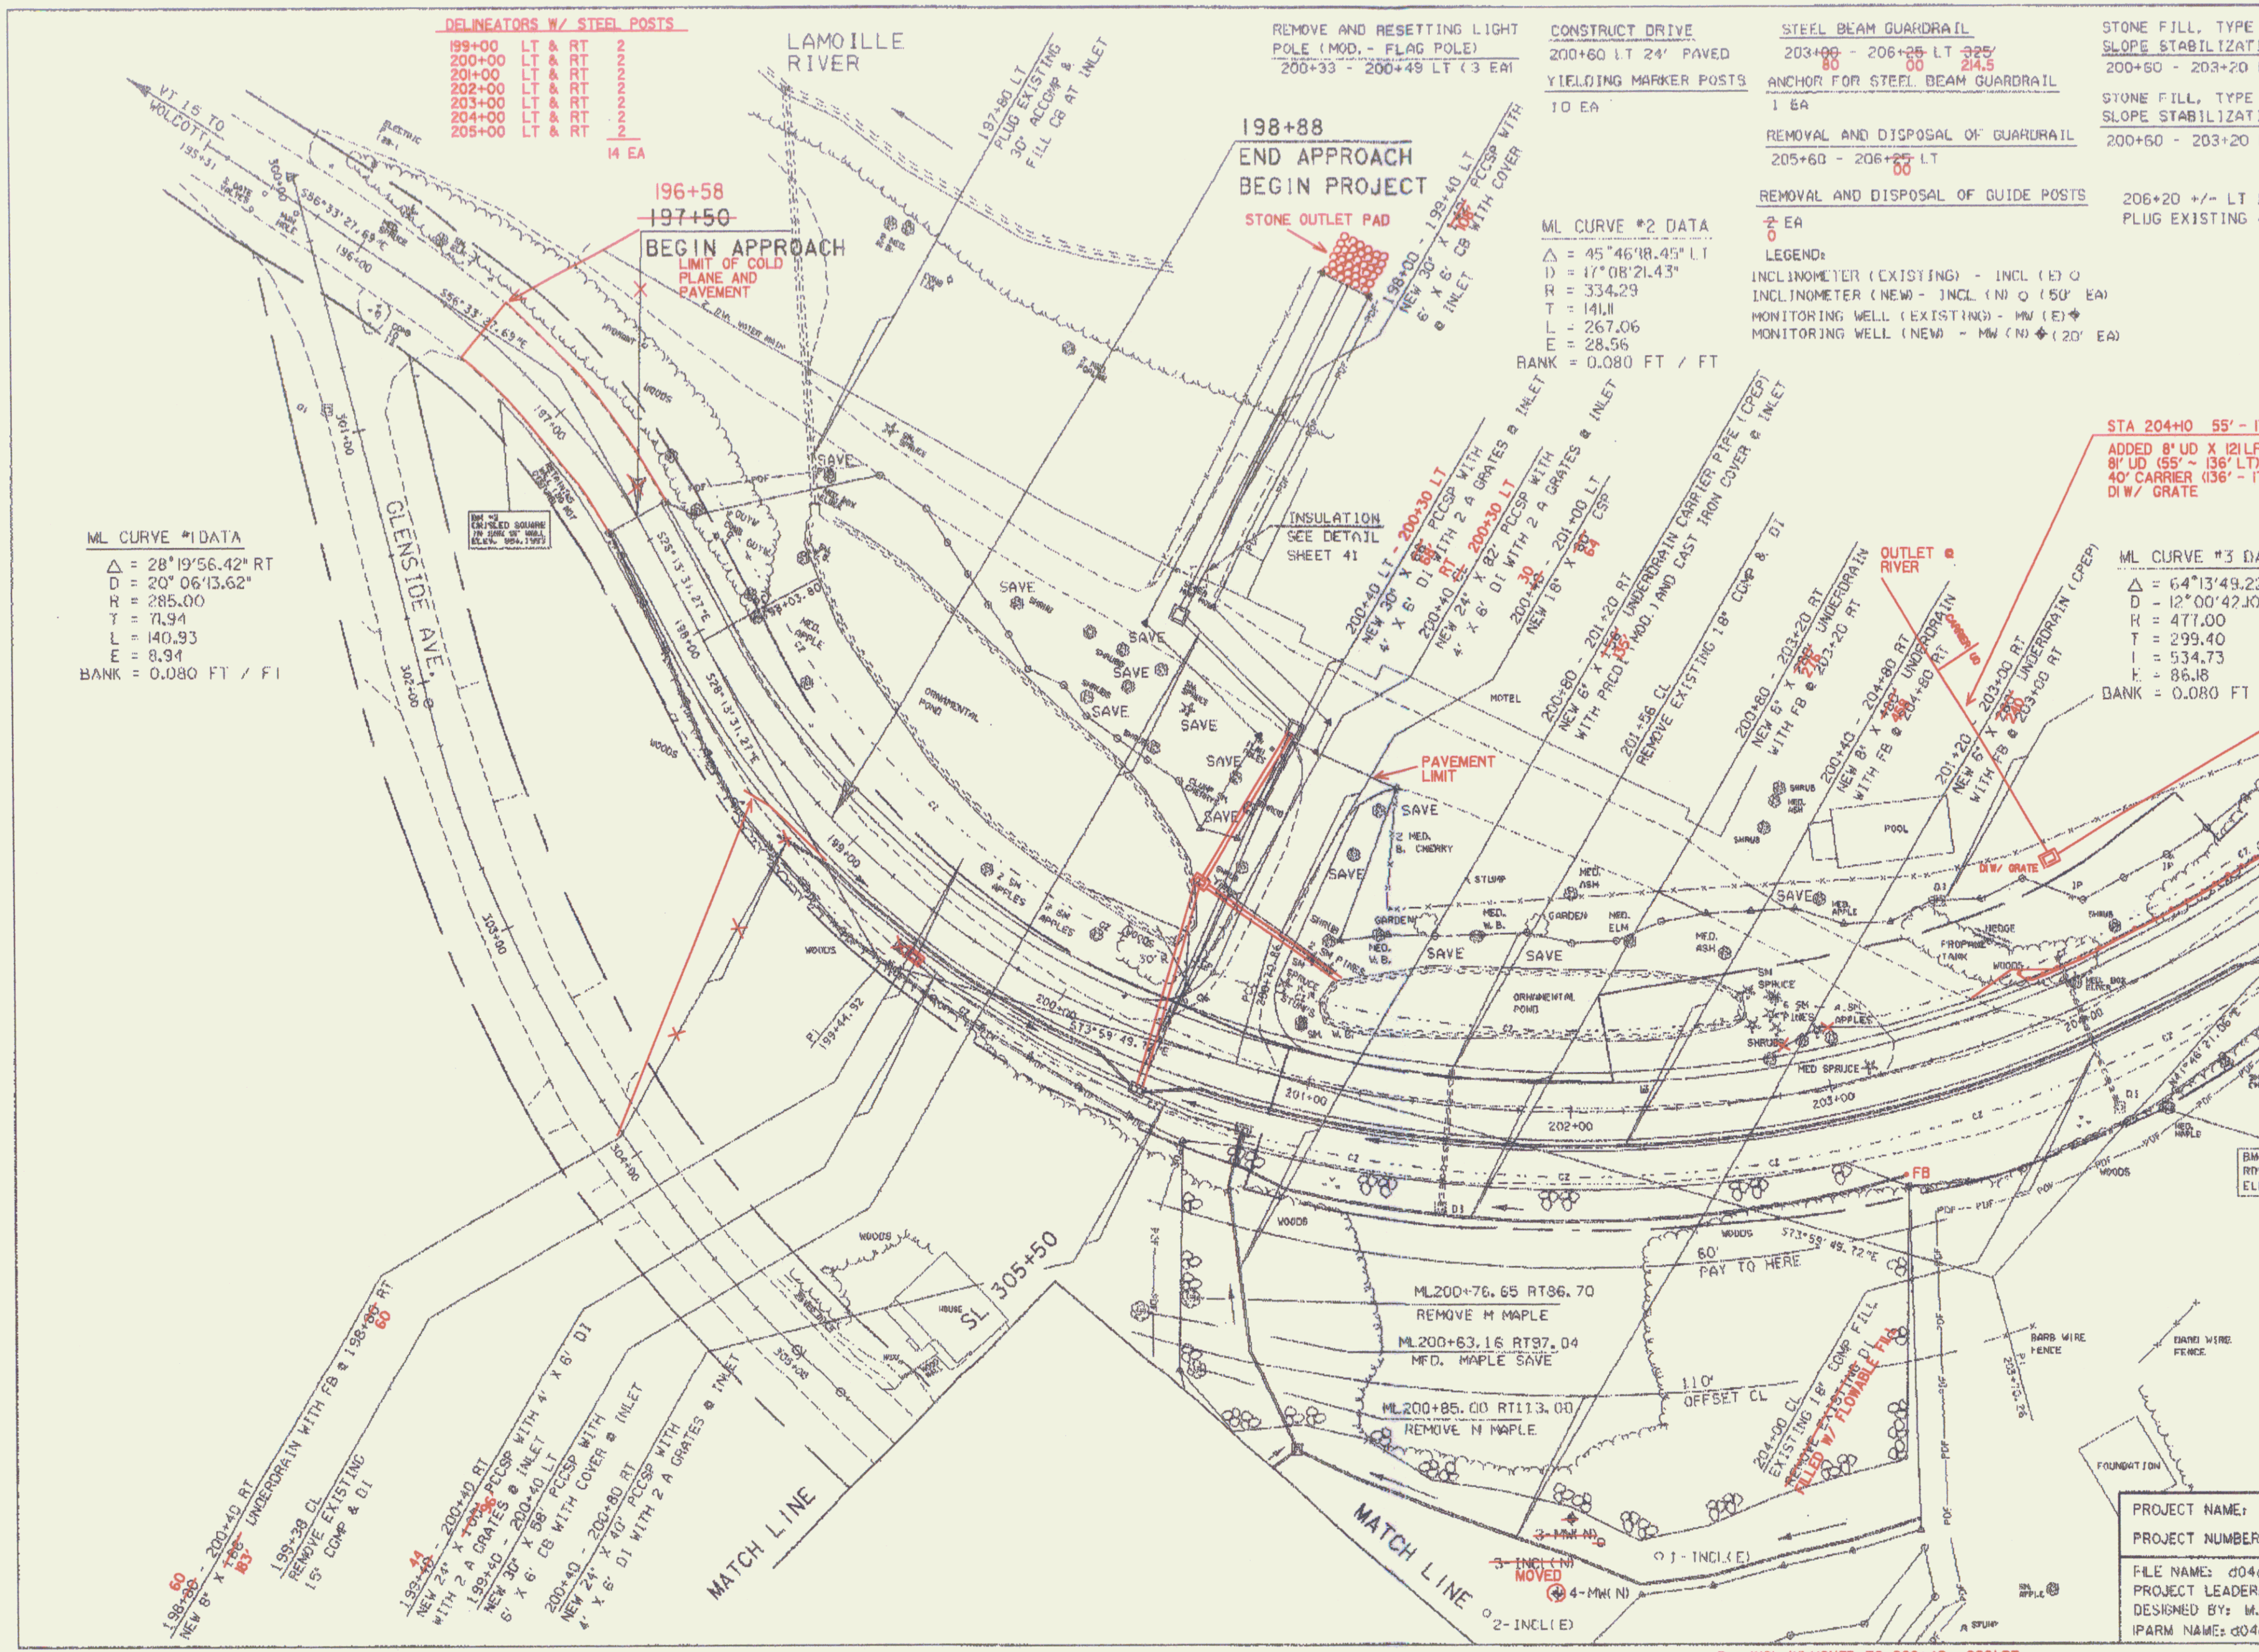

3MW ELIMINATED 3 - INCL (N) MOVED TO 202+40 208' RT

PROJECT NAME:
PROJECT NUMBER:
FILE NAME: 0404
PROJECT LEADER:
DESIGNED BY: M.
IPARM NAME: 0404