

SL306+41.43 LT65.84  
 REMOVE L.PINE  
 PLANT NEW SUGAR MAPLE  
 2-2 1/2" CALIPER

**SL CURVE #2 DATA**  
 $\Delta = 5^{\circ}58'19.00''$  LT  
 $D = 2^{\circ}51'53.00''$   
 $R = 2000.00$   
 $T = 104.32$   
 $L = 208.46$   
 $E = 2.72$

307+05 - 308+00 LT  
 NEW 8" X 8" UNDERDRAIN IN CARRIER PIPE (CPEP)  
 WITH PREL (M.D.) AND CAST IRON COVER & INLET

307+05 - 307+15 LT  
 8" UD CARRIER

18" PIPE AND DI INSTALLED  
 BY P.P. SICARD BEFORE  
 NOVEMBER 05

BM #3  
 TOP OF BOLT AT END  
 OF ANTIW ON HYDRANT  
 ELEV. 938.3360


**SL CURVE #3 DATA**  
 $\Delta = 18^{\circ}04'17.00''$  RT  
 $D = 9^{\circ}42'40.00''$   
 $R = 590.00$   
 $T = 93.82$   
 $L = 186.09$   
 $E = 7.41$

307+15 - 308+00 LT  
 NEW 8" X 8" UNDERDRAIN IN CARRIER PIPE  
 CONNECT TO EXISTING 8" UNDERDRAIN  
 PAYMENT FOR CONNECTION, REMOVAL  
 EXISTING UNDERDRAIN AND PATCHING  
 DI WILL BE INCIDENTAL TO OTHER  
 CONTRACT ITEMS

ADDED PAVED DITCH  
 307+45 - 311+00 LT  
 ITEM 616.47

**SL CURVE #4 DATA**  
 $\Delta = 4^{\circ}59'58.00''$  LT  
 $D = 4^{\circ}24'27.00''$   
 $R = 1300.00$   
 $T = 56.75$   
 $L = 113.43$   
 $E = 1.24$

YIELDING MARKER  
 1 EA  
 LEGEND:  
 INCL INOMTER (EX  
 INCL INOMETER (NE  
 MONITORING WELL  
 MONITORING WELL

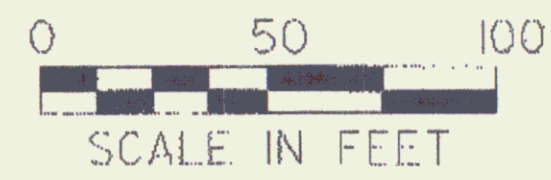

PROJECT  
 PROJECT  
 FILE NAM  
 PROJECT  
 DESIGNED  
 IPARM NA