

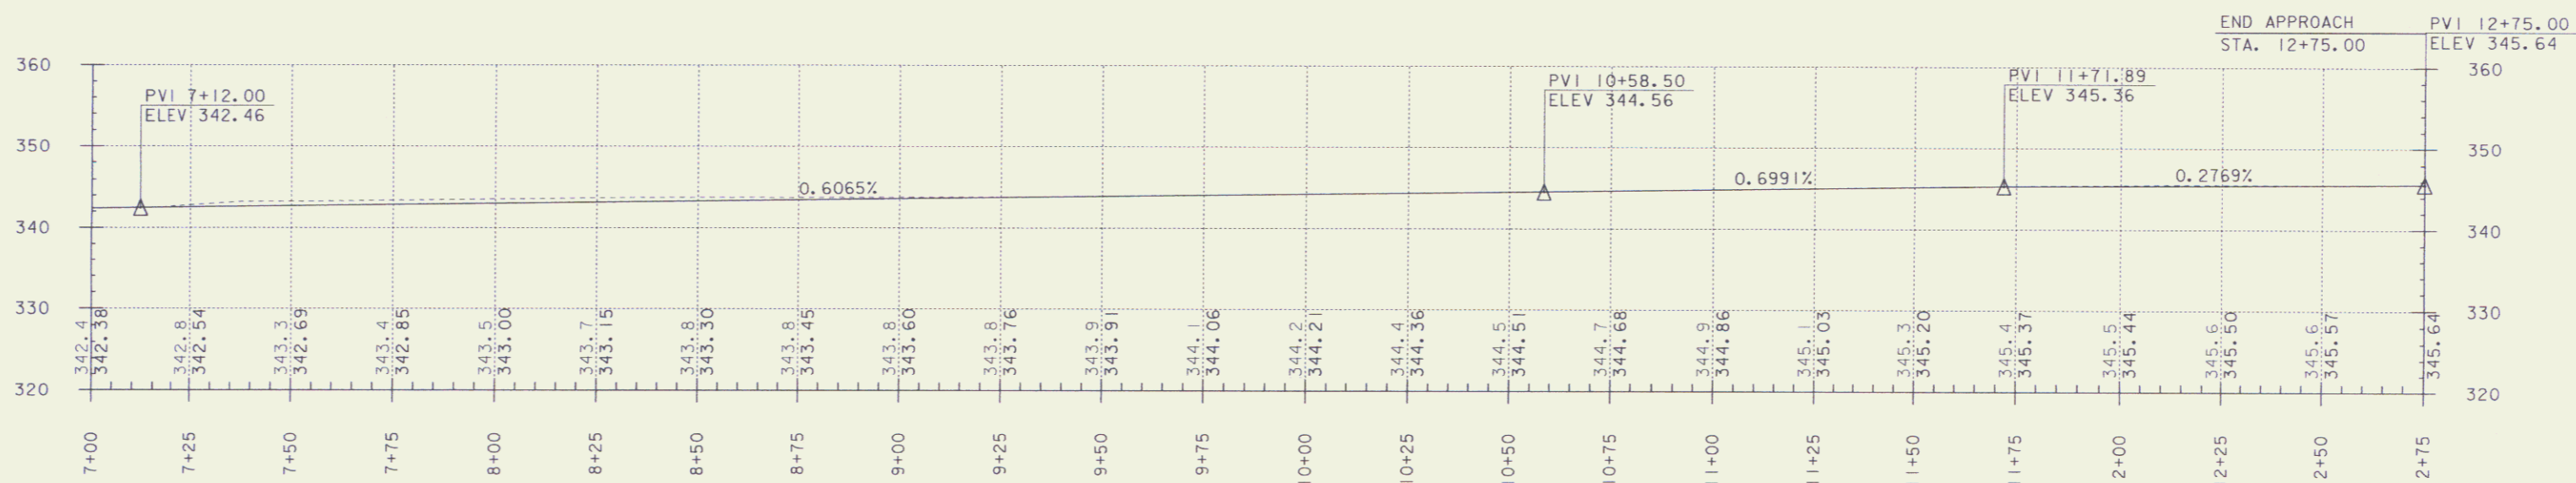


# VT 116

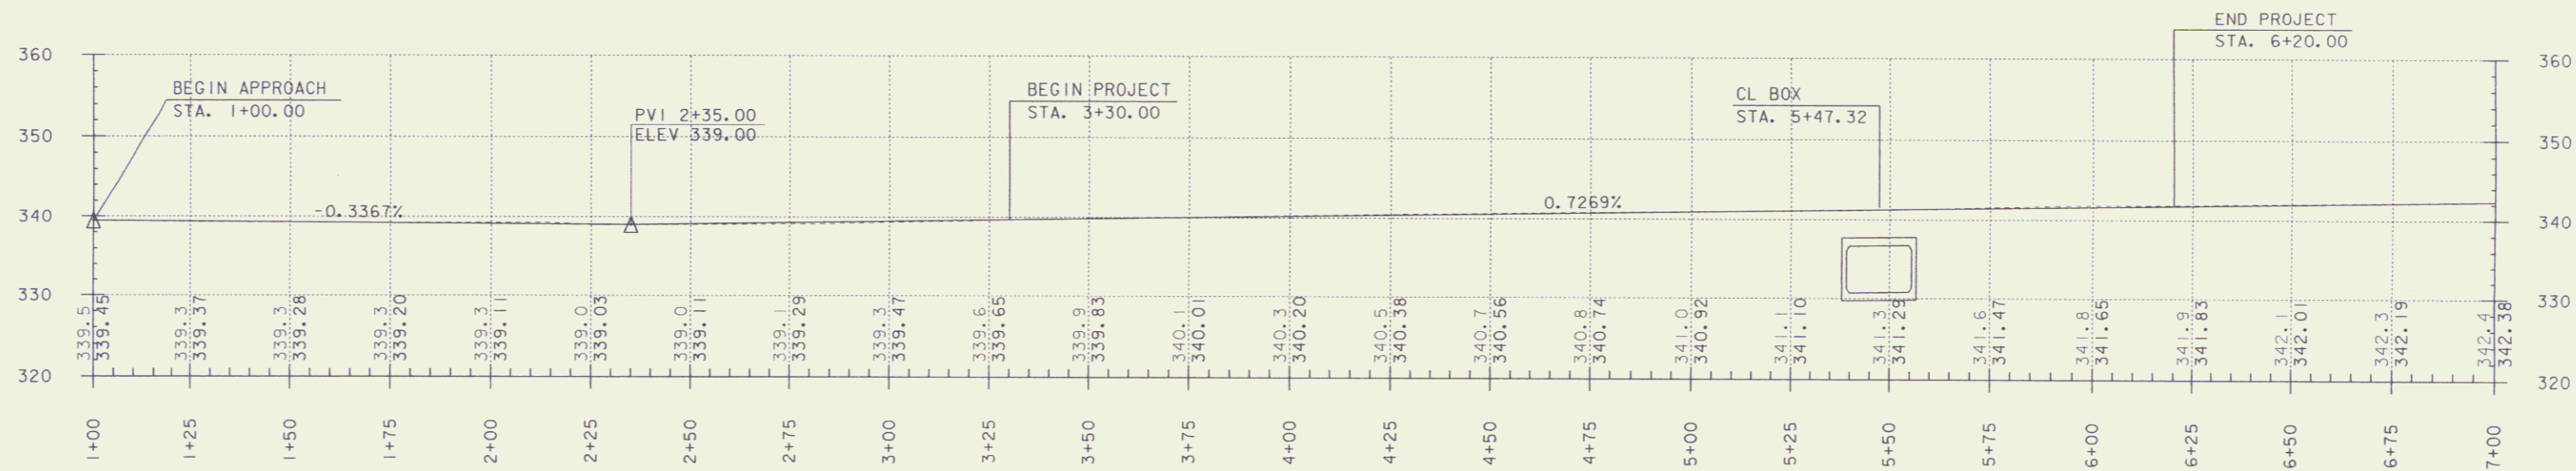

NOTE:  
 GRADES SHOWN TO THE NEAREST TENTH  
 ARE EXISTING GROUND ALONG C.  
 GRADES SHOWN TO THE NEAREST HUNDREDTH  
 ARE PROPOSED GROUND ALONG C.

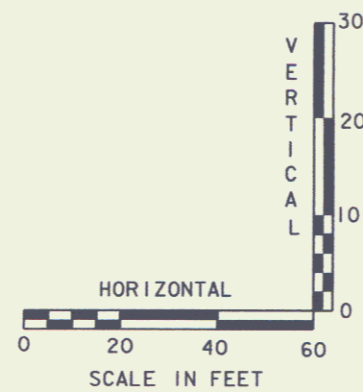

### PROFILE SHEET

PROJECT: BRISTOL	PROJECT NO.: ER ST 021-1 (22)
DESIGN FILE NAME: 05b126\str\s05b126wrk.dgn	PLOT DATE: 21-DEC-2006
IPARM FILE NAME: s05b126pr.f.i	SURVEY DATE:
SQUAD LEADER: M. EVANS-MONGON	DRAWN BY: G. ROKES
	ROW SHEET 3 OF 10

SEP 16 2008

3