

**BEGIN R.O.W. PROJECT  
STOCKBRIDGE-BETHEL  
STP-ER IRN0(107)  
STA. 202+97LT  
43.20' LT. ±**

WHITE RIVER

**CAMPISI, LUCIO**

**3A**

INV. = 576.11'

INV. = 578.37'

INV. = 581.73'

BEGIN GUARDRAIL  
MATCH EXISTING  
STA. 202+43

PC  
N47174.7417  
E1508646.4325  
202+32.38

203+02  
24.75' LT

CULV. & DRAIN. (P)

CULV. & DRAIN. (P)

CULV. & DRAIN. (P)  
N471397.0442  
E150950.0649  
205+63.12

MATCH LINE 206+15.00

POB  
200+00.00

HYCTRL #110  
200+00

201+00

VT 107 TO VT 100

202+00


BEGIN PAVEMENT  
MATCH EXISTING  
STA. 202+64.63

203+00

204+00

205+00

206+00

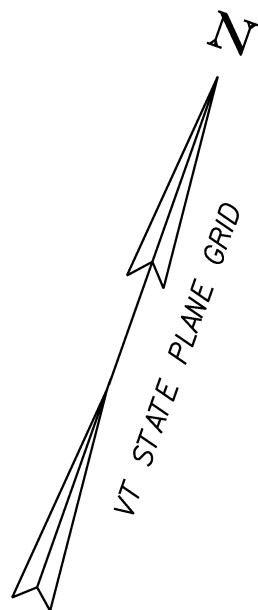

EXISTING HEADWALL  
INV. = 585.57'

CURVE DATA #J  
DELTA = 31° 39' 35.18"  
D = 9° 32' 57.47"  
R = 600.00'  
T = 170.12'  
L = 331.54'  
E = 23.65'

**3B**

**CAMPISI, LUCIO**

N471292.8478  
E1506815.5872  
P1 (CURVE #1)  
204+02.50

204+25  
24.75' RT  
204+25  
47.14' RT

SLOPE (P)

HEADWALL  
INV. = 586.60'


LEACHING DROP INLET  
GRATE EL. = 589.27'  
PIPE INV. = 578.20'  
DIB EL. = 577.30'

LIMITS OF STONE FILL

LINES SHOWN ON THIS PLAN AS EXISTING  
PROPERTY LINES P/L ARE BELIEVED TO  
BE ACCURATE BUT SHOULD NOT BE RELIED  
UPON FOR PURPOSES UNRELATED TO THE  
STATE OF VERMONT'S ACQUISITION OF LAND  
AND RIGHTS FOR THIS PROJECT.

**AS-BUILT  
SURVEY**  
2/27/2012

DATUM	
VERTICAL	NAVD 88
HORIZONTAL	NAD 83(1996)

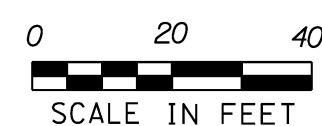

PROJECT NAME:	STOCKBRIDGE-BETHEL	PLOT DATE:	18-JAN-2013
PROJECT NUMBER:	STP-ER IRN0(107)	DRAWN BY:	J. BLANCHARD
FILE NAME:	SITE16_LAYOUT1	CHECKED BY:	J. BLANCHARD
PROJECT LEADER:	M.A. COLGAN	ROWSHEET	3 OF 7
DESIGNED BY:	VHB		
ROW LAYOUT SHEET 1			