

CAMPBELL, GORDON W. & SHARON A.

CAMPBELL, GORDON W. & SHARON A.

CAMPBELL, GORDON W. & SHARON A.

CAMPBELL, GORDON W. & SHARON A.

6A

6C

6B

6D

WHITE RIVER

INV. = 571.22'

INV. = 574.62'

INV. = 572.53'

PT 217+22.59  
N472384.4112  
E1597441.0791

MATCHLINE 212+10.00

MATCHLINE 211+50.00

213+00

VT ROUTE 107

216+00

217+00

214+00


215+00

STOCKBRIDGE/BETHEL

STOCKBRIDGE TOWN LINE  
BETHEL TOWN LINE

LEACHING DROP INLET  
GRATE EL. = 564.02'  
PIPE INV. = 572.73'  
DIB EL. = 571.97'

LIMITS OF STONE FILL

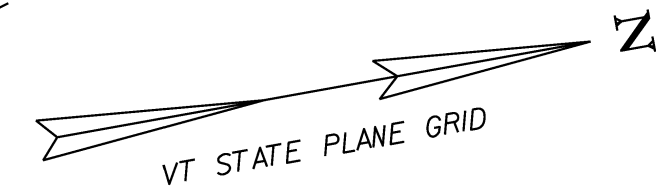

CURVE DATA #2

DELTA = 57°24'18.64"  
D = 5°30'33.15"  
R = 1040.00'  
T = 569.44'  
L = 1041.99'  
E = 145.69'

LEACHING DROP INLET  
GRATE EL. = 586.77'  
PIPE INV. = 575.73'  
DIB EL. = 575.09'

SLOPE(P)

LEACHING DROP INLET  
GRATE EL. = 585.60'  
PIPE INV. = 574.46'  
DIB EL. = 573.65'

212+25

158' RT


215+25

171' RT

LINES SHOWN ON THIS PLAN AS EXISTING  
PROPERTY LINES P/L ARE BELIEVED TO  
BE ACCURATE BUT SHOULD NOT BE RELIED  
UPON FOR PURPOSES UNRELATED TO THE  
STATE OF VERMONT'S ACQUISITION OF LAND  
AND RIGHTS FOR THIS PROJECT.

**AS-BUILT  
SURVEY**  
2/27/2012

DATUM	
VERTICAL	NAVD 88
HORIZONTAL	NAD 83(1996)

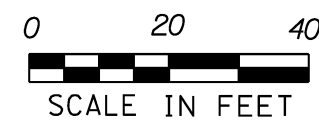

PROJECT NAME:	STOCKBRIDGE-BETHEL	PLOT DATE:	18-JAN-2013
PROJECT NUMBER:	STP-ER IRNO(107)	DRAWN BY:	J. BLANCHARD
FILE NAME:	SITE16_LAYOUT3	DESIGNED BY:	VHB
PROJECT LEADER:	M.A. COLGAN	CHECKED BY:	J. BLANCHARD
ROW LAYOUT SHEET 3		ROWSHEET	5 OF 7