


WHITE RIVER


6C

CAMPBELL, GORDON W. & SHARON A.

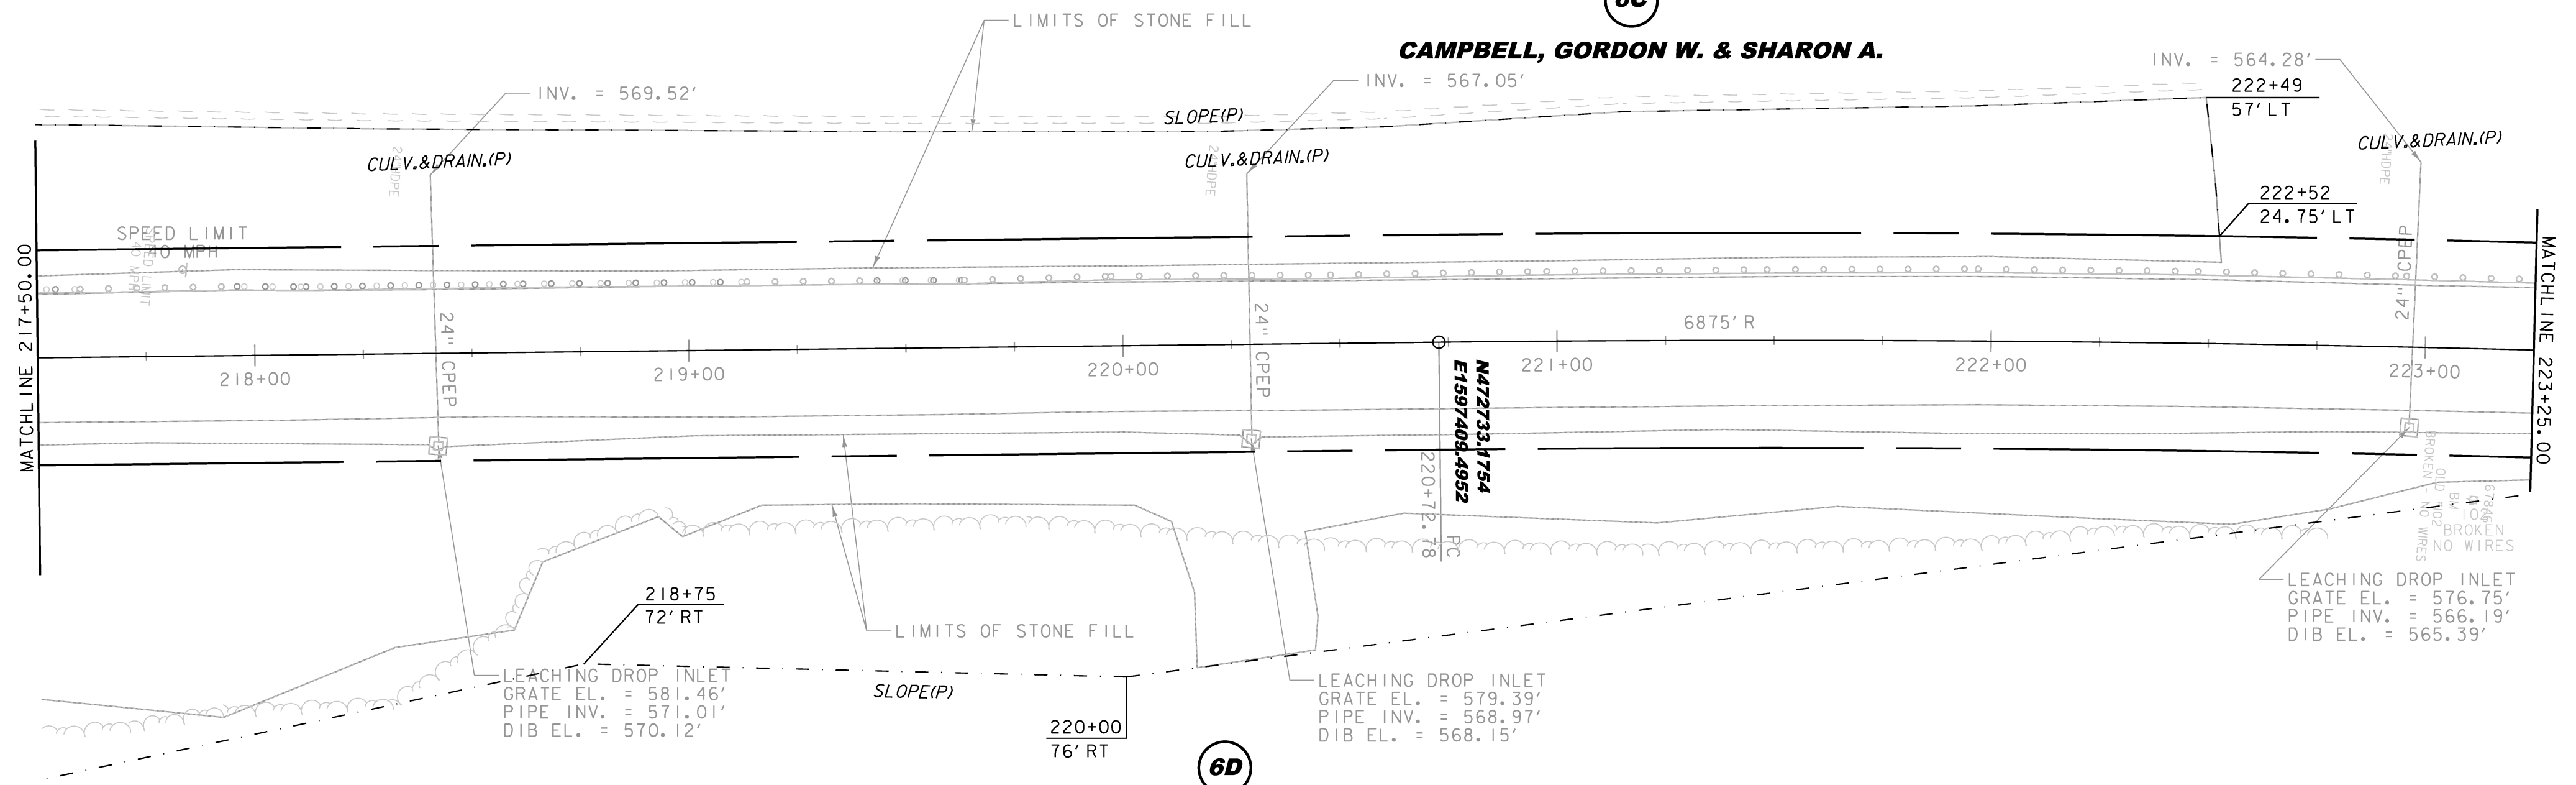

CAMPBELL, GORDON W. & SHARON A.


6D

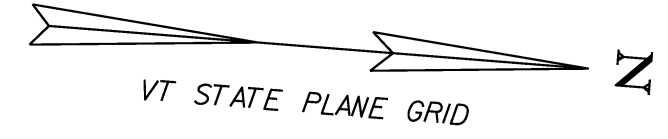

LINES SHOWN ON THIS PLAN AS EXISTING  
 PROPERTY LINES P/L ARE BELIEVED TO  
 BE ACCURATE BUT SHOULD NOT BE RELIED  
 UPON FOR PURPOSES UNRELATED TO THE  
 STATE OF VERMONT'S ACQUISITION OF LAND  
 AND RIGHTS FOR THIS PROJECT.

**AS-BUILT  
 SURVEY**  
 2/27/2012

DATUM	
VERTICAL	NAVD 88
HORIZONTAL	NAD 83(1996)

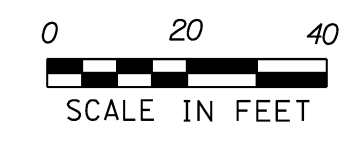

PROJECT NAME:	STOCKBRIDGE-BETHEL	PLOT DATE:	18-JAN-2013
PROJECT NUMBER:	STP-ER IRNO(107)	DRAWN BY:	J. BLANCHARD
FILE NAME:	SITE16_LAYOUT4	DESIGNED BY:	VHB
PROJECT LEADER:	M.A. COLGAN	CHECKED BY:	J. BLANCHARD
ROW LAYOUT SHEET 4		ROWSHEET	6 OF 7