


MANUFACTURED TERMINAL SECTION, TANGENT  
 STA. 223+68

CURVE DATA #3  
 DELTA = 4°27' 12.28" R  
 D = 0°50' 00.22"  
 R = 6875.00'  
 T = 267.32'  
 L = 534.37'  
 E = 5.20'

6C

**CAMPBELL, GORDON W. & SHARON A.**

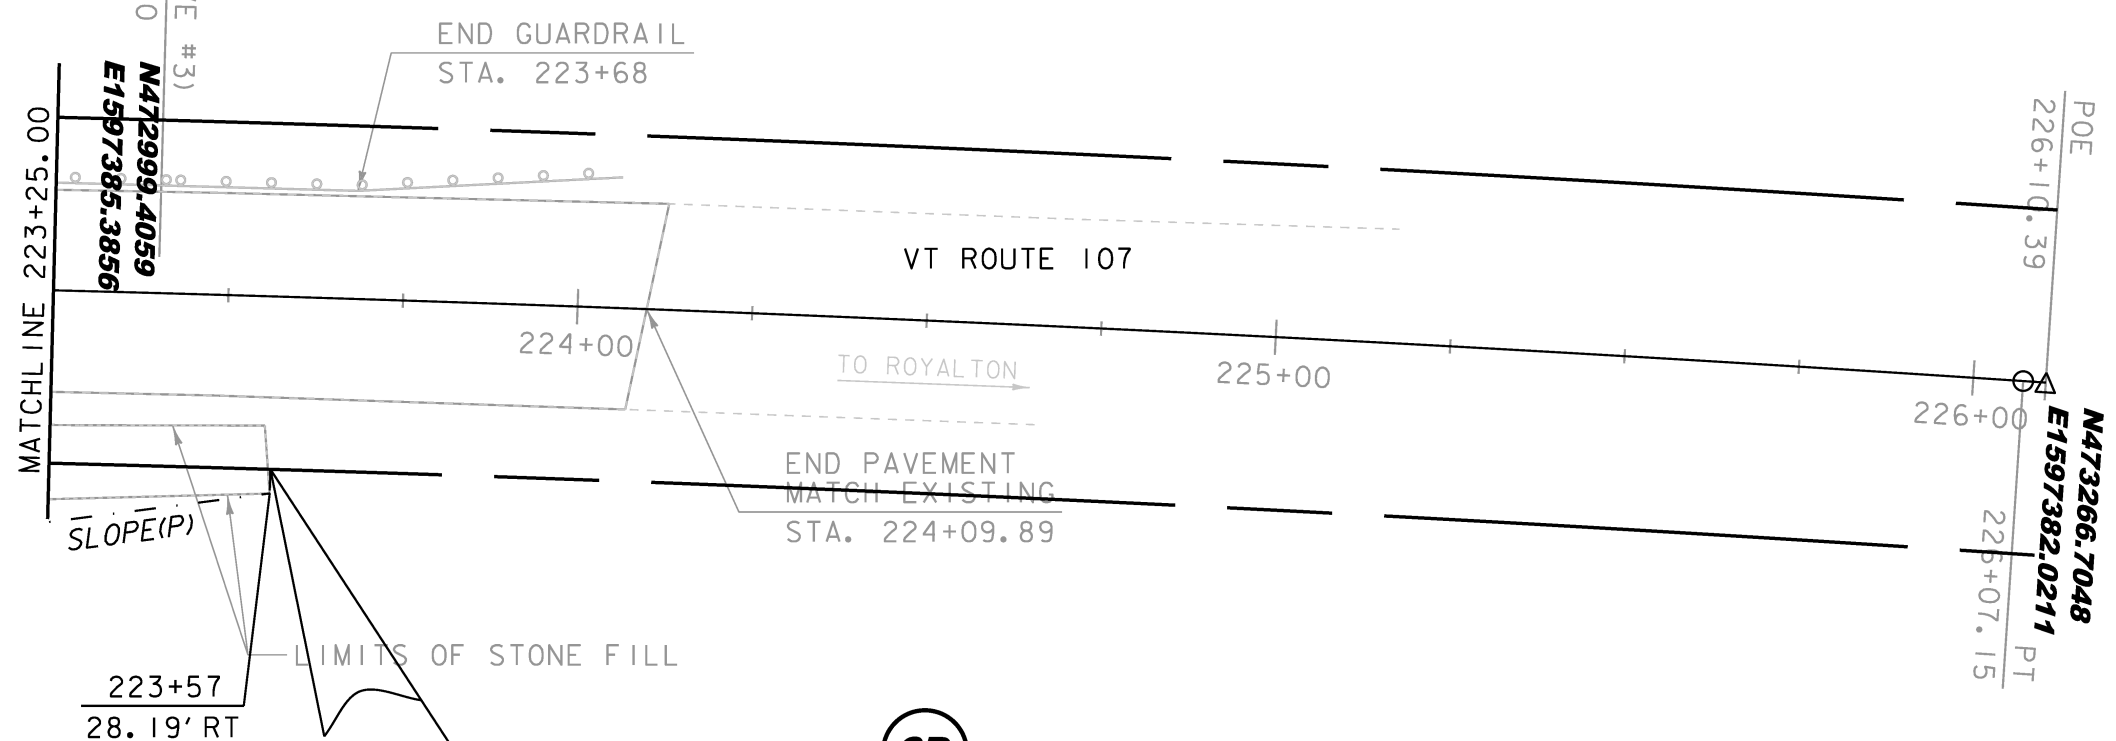

6D

**CAMPBELL, GORDON W. & SHARON A.**


**END R.O.W. PROJECT  
 STOCKBRIDGE-BETHEL  
 STP-ER IRN0(107)  
 STA. 223+57  
 24.75' RT**

HV CONTROL #120

LINES SHOWN ON THIS PLAN AS EXISTING  
 PROPERTY LINES P/L ARE BELIEVED TO  
 BE ACCURATE BUT SHOULD NOT BE RELIED  
 UPON FOR PURPOSES UNRELATED TO THE  
 STATE OF VERMONT'S ACQUISITION OF LAND  
 AND RIGHTS FOR THIS PROJECT.

**AS-BUILT  
 SURVEY**  
 2/27/2012

|            |              |
|------------|--------------|
| DATUM      |              |
| VERTICAL   | NAVD 88      |
| HORIZONTAL | NAD 83(1996) |

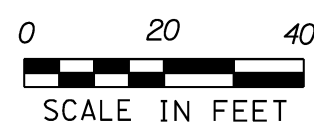

|                  |                    |
|------------------|--------------------|
| PROJECT NAME:    | STOCKBRIDGE-BETHEL |
| PROJECT NUMBER:  | STP-ER IRN0(107)   |
| FILE NAME:       | SITE16.LAYOUT5     |
| PROJECT LEADER:  | M.A. COLGAN        |
| DESIGNED BY:     | VHB                |
| ROW LAYOUT SHEET | 5                  |
| PLOT DATE:       | 18-JAN-2013        |
| DRAWN BY:        | J. BLANCHARD       |
| CHECKED BY:      | J. BLANCHARD       |
| ROWSHEET         | 7 OF 7             |