

- INDEX OF SHEETS
1. TITLE SHEET
 2. QUANTITY SHEET
 3. PLAN
 4. PROFILE, TYPICAL SECTIONS AND GENERAL NOTES
 5. TYPICAL SECTION, PLAN, CURB AND RAILING DETAILS
 6. SUPERSTRUCTURE DETAILS
 7. ABUTMENT DETAILS
 8. PIER AND WATER LINE RELOCATION DETAILS
 9. REINFORCING STEEL SCHEDULE
 - 10-13. ROADWAY SECTIONS
 - 14-18. CHANNEL SECTIONS

- STANDARDS
19. E-3 BRIDGE CONSTRUCTION APPROACH SIGNS 11-7-73 R
 20. E-9 TRAFFIC SIGNS 12-19-72 R
 21. G-1a 12-9-72 R
 22. SCLB-D6-73, DET. A TYPE II 11-28-73

STATE OF VERMONT DEPARTMENT OF HIGHWAYS




PROPOSED IMPROVEMENT

BRIDGE PROJECT
COUNTY OF LAMOILLE
TOWN OF STOWE
VERMONT ROUTE 108
BRIDGE NO. 3

PROJECT BMA 6124

BEGINNING AT A POINT APPROXIMATELY 1.04 FT. WEST OF
THE STOWE VILLAGE LINE ON VT RTE 108 AND EXTENDING 350
FT. EASTERLY.

THIS PROJECT SHALL CONSIST OF WIDENING PRESENT SUPERSTRUCTURE,
REPAIRING ABUTMENTS AND PIER, AND APPROACH AND CHANNEL WORK AS
DETAILED ON THESE PLANS.

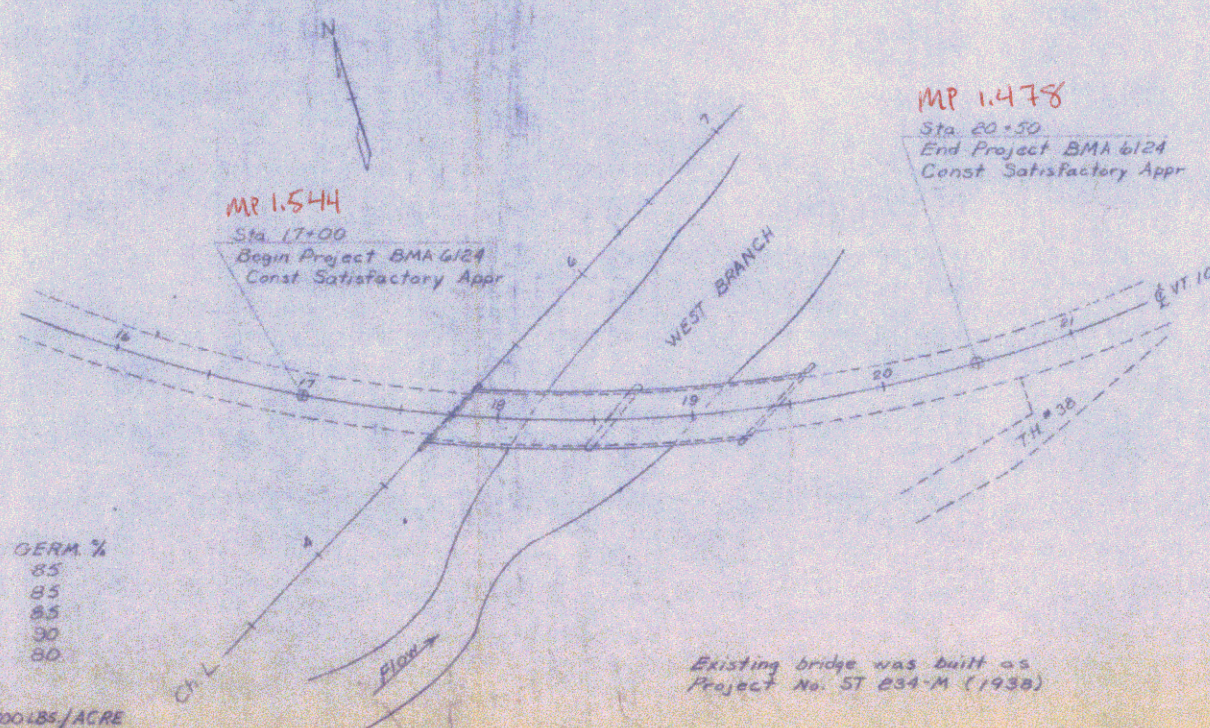

CONVENTIONAL SIGNS

- COUNTY LINE
- TOWN LINE
- LIMIT OF ACCESS
- POINT OF ACCESS
- PAVED DRIVE
- STONE WALL
- TRUCKED WAY
- ROAD RAIL
- RAILROAD
- SURVEY LINE
- POLELINE
- POWER POLE
- TELEPHONE POLE
- TREES
- E.A. CONST. IDENTIFICATION SIGNS
- PROPERTY LINE
- ROAD TAKING LINE
- SLOPE SIGN
- END OF CUT
- WIDE SLOPE

% WT	LBS/ACRE	SEEDING FORMULA NAME	PUR. %	GERM. %
41.47	25	CREEPING RED FESCUE	98	85
25.00	15	ALFALFA	99	85
8.33	5	RED TOP	92	85
14.47	10	PERENNIAL RYE GRASS	95	90
8.33	5	BIRDSFOOT TREFOIL (EMPIRE)	98	80
100.00%	60 LBS			

APPLICATION RATES: ITEM 6510, SEED 60 LBS/ACRE
ITEM 6511, FERTILIZER (10-20-0) 300 LBS/ACRE
ITEM 6515, MULCH 2 TON/ACRE

SEED, FERTILIZER, MULCH SHALL BE APPLIED TO ALL NEW SLOPES
AS DIRECTED BY THE ENGINEER.

RECOMMENDED FOR	RECOMMENDED FOR	RECOMMENDED FOR	RECOMMENDED FOR
CONSTRUCTION ENGINEER	DISTRICT ENGINEER	CHIEF OF DIVISION	COMMISSIONER
2/2/72	2/2/72	2/2/72	2/2/72

Plans are subject to such
engineering changes as may be required by the
Federal Highway Administration or the Chief
Engineer.

Construction is to be carried on in accordance
with these plans and the Standard Specifications
for Highway and Bridge Construction dated
as approved by the
including all subsequent
approved, revised and authorized specifications
and amendments on file in the Department.

SUBMITTED BY ORDER OF THE STATE HIGHWAY BOARD

APPROVED AND FORWARDED

R. H. Arnold 4/2/72

DEPARTMENT OF TRANSPORTATION
FEDERAL HIGHWAY ADMINISTRATION