



INDEX OF SHEETS

SHEET NO.	DESCRIPTION	DATE
1	Title Page	
2	Alignment Sheet	
3-4	Typical Sections, US Route 4	
5	Typical Sections, Alternate US Route 4 (Sidelines)	
6-7	Item Quantity Sheet	
8-9	Item Detail and Drainage Sheet	
10	Underdrain Sheet	
11-17	Earthwork and Grade Sheet	
18	Earthwork Summary Sheet	
19-26	Right of Way Detail Sheet	
27-35	Plan and Profile Sheets	
36	Pavement Details	
37	Blank	
38-64	Blank	
65-66	Blank	
67-69	2'-6" R.C. Cattlepen Sta. 695+60	
70-73	18"x3" S.C.S. Sta. 700+50-Details	
74-75	18"x3" S.C.S. Sta. 700+50-Channel Sections	
76	90" C.G.M.P.P. Sta. 770+50-Details	
77-80	90" C.G.M.P.P. Sta. 770+50-Channel Sections	
81-112	Bridge over Castleton River, Sta. 687+0-Details	
113-122	Bridge over Rt. 135, Sta. 698+00-Details	
123-158	Bridge over Rt. 135, Sta. 774+50-Details	
159	Blank	
160-281	Cross Sections, US 4	
282-284	Cross Sections, Alt. US 4 #805+00	
285-287	Cross Sections, Juppahle	
288-290	Cross Sections, Alt. US 4 #694+00	
291-298	Cross Sections, Frontage Road #760+00	
299	Culvert Sections #701+00 and 709+32	
300	Cross Sections, Frontage Road Ext. #760+00	
301-302	Cross Sections, Vt. 135	
303-305	Channel Sections, Castleton River #687+50	
306	2'-6" R.C. Cattlepen Excavation	
307	8-1 Banking Tables	3/10/65
308	8-5 Slope Grading	3/10/65
309	8-6 Muck Excavation	3/10/65
310	8-10 Embankment on a Slope	3/10/65
311	8-11 Slope Stabilization	3/10/65
312	8-15 Entrance-Exit (Trenches)	3/10/65
313	8-16 Divisional Islands	3/10/65
314	8-17 Bridge Approaches	3/10/65
315	C-1 Curb	3/10/65
316	C-1a Curb	3/10/65
317	D-1 Drop Inlet - Type 1-B	3/10/65
318	Headwalls	3/10/65
319	D-3 Jute Matting	3/10/65
320	D-4 Elbow, Metal End Section	3/10/65
321	Reinforced Concrete Drop Inlets	3/10/65
322	D-10 Drop Inlet Top	3/10/65
323	D-11 Drop Inlet Grate, Type A	3/10/65
324	D-16 Drop Inlet - Type II	11/4/66 R
325	D-17 ACCOMP Vertical River	1/7/66 R
326	E-1 Barricades, Signs and Lights	3/10/65
327	E-5 Const. Identification Signs	4/8/65
328	F-1 Property Line Fence	3/10/65
329	F-2 Chain Link Fence, Galvanized	6/4/65 R
330	F-3 Chain Link Fence, Aluminum	6/4/65 R
331	G-1 Steel Beam Guard Rail	10/28/66 R
332	G-3 Torus Castle Guard Rail	9/1/66 R
333	G-3a Dead End Anchorage	2/8/66 R
334	G-4 Steel Marker Posts	10/30/65 R
335	SCB-30-65	2/4/66
336	SCB-38-65	2/24/66
337	SCB-D2-65	2/4/65 R
338	SCB-D3-65	2/4/65
339	SCB-D4-65	2/4/65
340	SCB-D5-65	2/4/65
341	SCB-D6-65	3/7/65 R
342	SCB-D7-65	2/4/65 R
343	SCB-D8-65	2/4/65
344	SCB-D9-65	2/4/65
345	SCB-D10-65	2/4/65
346	SCB-D11-65	2/4/65 R
347	SCB-D12-65	2/4/65 R
348	SCB-D13-65	2/4/65
349	SCB-D14-65	2/4/65
350	SCB-D15-65	2/4/65
351	SCB-D16-65	3/7/65 R
352	SCB-D17-65	2/4/65 R
353	SCB-D18-65	2/4/65
354	SCB-D19-65	2/4/65
355	Blank	
356	OB-R1-64 #1	11/8/66 R
357	OB-R1-64 #2	11/8/66
358	OB-R2-65	11/8/66
359	OB-R2-65	11/8/66

STATE OF VERMONT
DEPARTMENT OF HIGHWAYS
PROPOSED IMPROVEMENT
TOWN OF WEST RUTLAND
COUNTY OF RUTLAND
U.S. ROUTE NO. 4
FAIR HAVEN-RUTLAND ROAD

BEGINNING AT A POINT 0.172 MILE EASTERLY OF THE IRA-WEST RUTLAND TOWN LINE AND EXTENDING EASTERLY 3.316 MILES
LENGTH OF ROADWAY 16,732.12 FEET = 3.169 MILES
LENGTH OF BRIDGES 778.70 FEET = 0.147 MILE
LENGTH OF PROJECT 17,510.82 FEET = 3.316 MILES

DESIGNATION	DESIGNATION	DESIGNATION
ADT 1966	3650	
ADT 1986	6000	
DHV 1986	740	
D	61%	
T	8%	
V	60 M.P.H.	

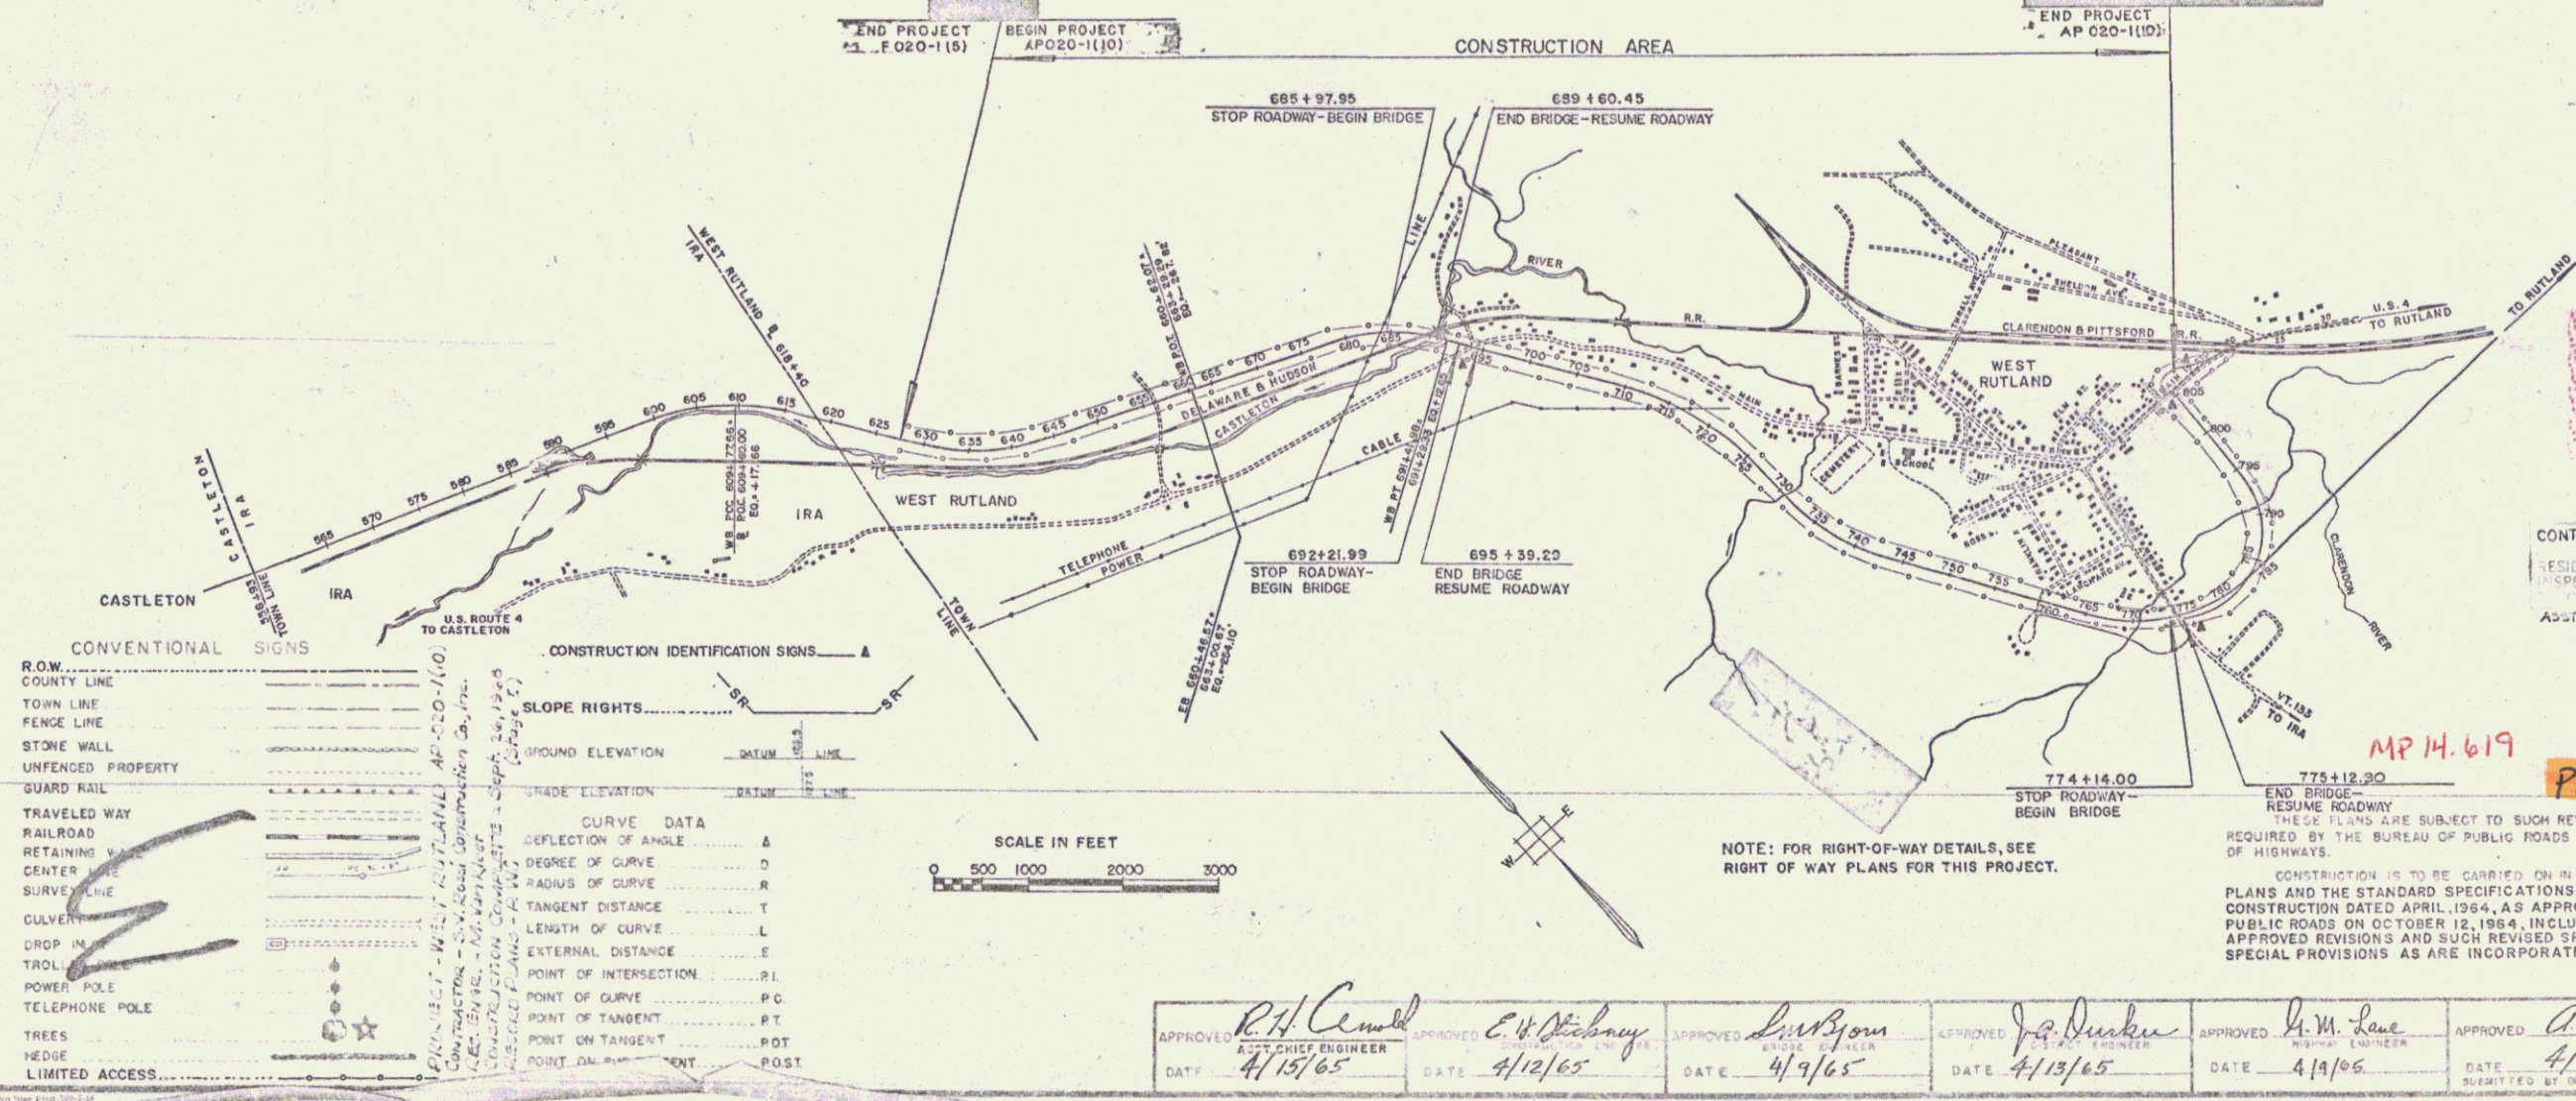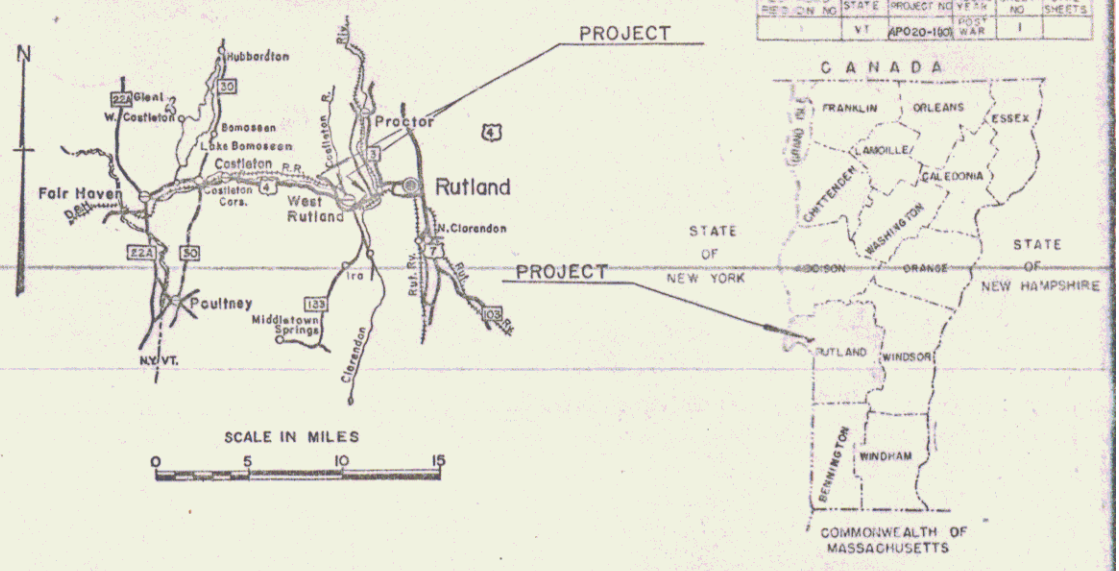

PROJECT NAME & NUMBER: WEST RUTLAND AP 020-1(10)

PAYMENT: PERPETUAL

CONTRACTOR: [Name]

RESIDENT ENGINEER: [Name]

APPROVED: [Name]

DATE: [Date]

CONVENTIONAL SIGNS

CONSTRUCTION IDENTIFICATION SIGNS

SCALE IN FEET

NOTE: FOR RIGHT-OF-WAY DETAILS, SEE RIGHT OF WAY PLANS FOR THIS PROJECT.

APPROVED: [Signatures]

DATE: [Dates]

PROJECT: AP 020-1(10)

SHEET 0 OF SHEETS 039