
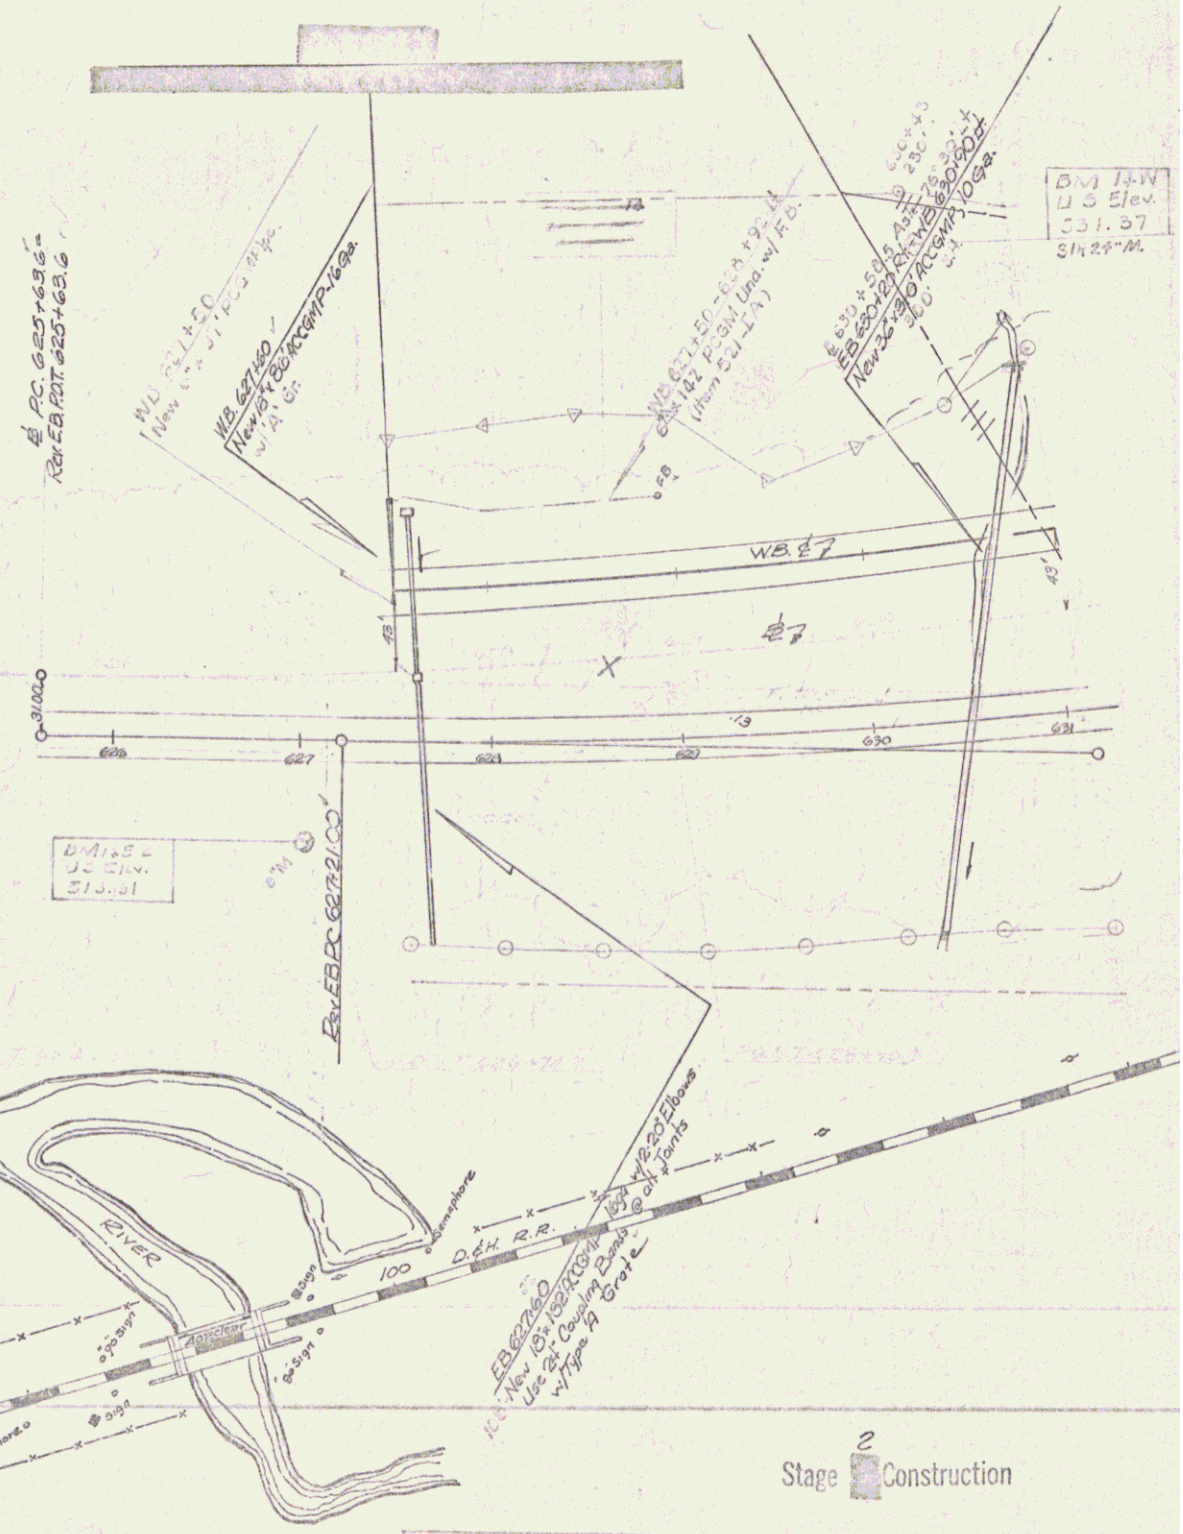
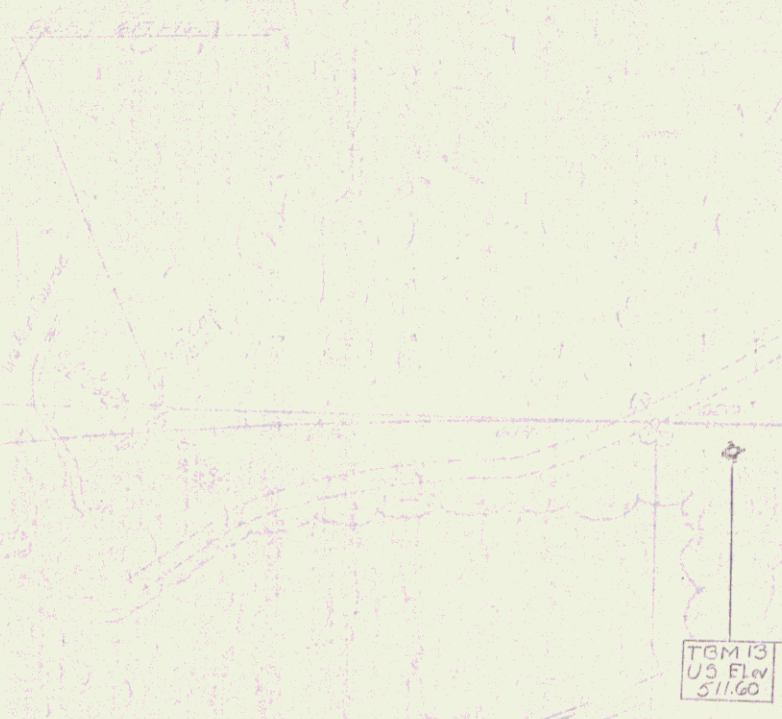


GRAVEL BACKFILL FOR SLOPE  
STABILIZATION, ITEM 222-A  
WB 627+50 - 629+02 LT.


Property Line Fence w/Steel Posts  
Mod. Item 533-2  
Rev. EB 627+50 - 631+00 RT  
WB 627+50 - 631+00 LT  
WB 630+12 - 631+00 LT  
That fence listed below is to be  
installed prior to the commencement  
of other work in this area.

\* Three Cable Guard Rail w/Light Steel Posts  
Item 538  
WB 627+50 - 631+00 RT  
EB 627+50 - 631+00 LT

\* Stage 2 Construction

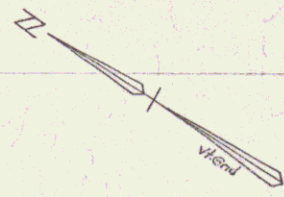

Stage 2 Construction

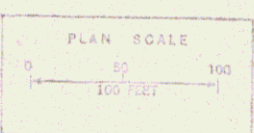

WEST RUTLAND  
A020-1 (11)  
Sheet 21 of 359 Sheets

Stage 2 Construction

Sheet 86 of 170 Sheets