

PLAN	REVISIONS
DATE	BY
NO.	NO.


Stone Pile for Slope Protection
 Light Type, 173M S12
 NB 633+00 - 637+50 Lt.
 SB 637+70 - 637+82 Rt.
 NB 638+50 - 642+50 Lt.

Property Line Fence w/ Steel Posts
 Mod. Item 533-II
 W.B. 631+00 - 647+00 Lt.
 R.E.B. 631+00 - 647+00 Rt.
 That fence listed below is to be installed prior to the commencement of other work in this area.
 W.B. 631+00 - 647+00 Lt.

*Three Cable Guard Rail w/
 Light Steel/Reel Item 538
 W.B. 631+00 - 647+00 Lt.
 R.E.B. 631+00 - 647+00 Rt.
 *Stage 2 Construction

Curve Data
 Δ 35°00'00" Lt.
 D 1°45'
 R 3274.0
 T 1032.3
 L 2000.0
 E 138.9
 Bank 1/2" per Ft.

Rev. E.B. /
 Curve Data
 Δ 36°18'17" Lt.
 D 1°45'
 R 3274.05
 T 1073.44
 L 2074.56
 E 171.48
 Bank 1/2" per Ft.

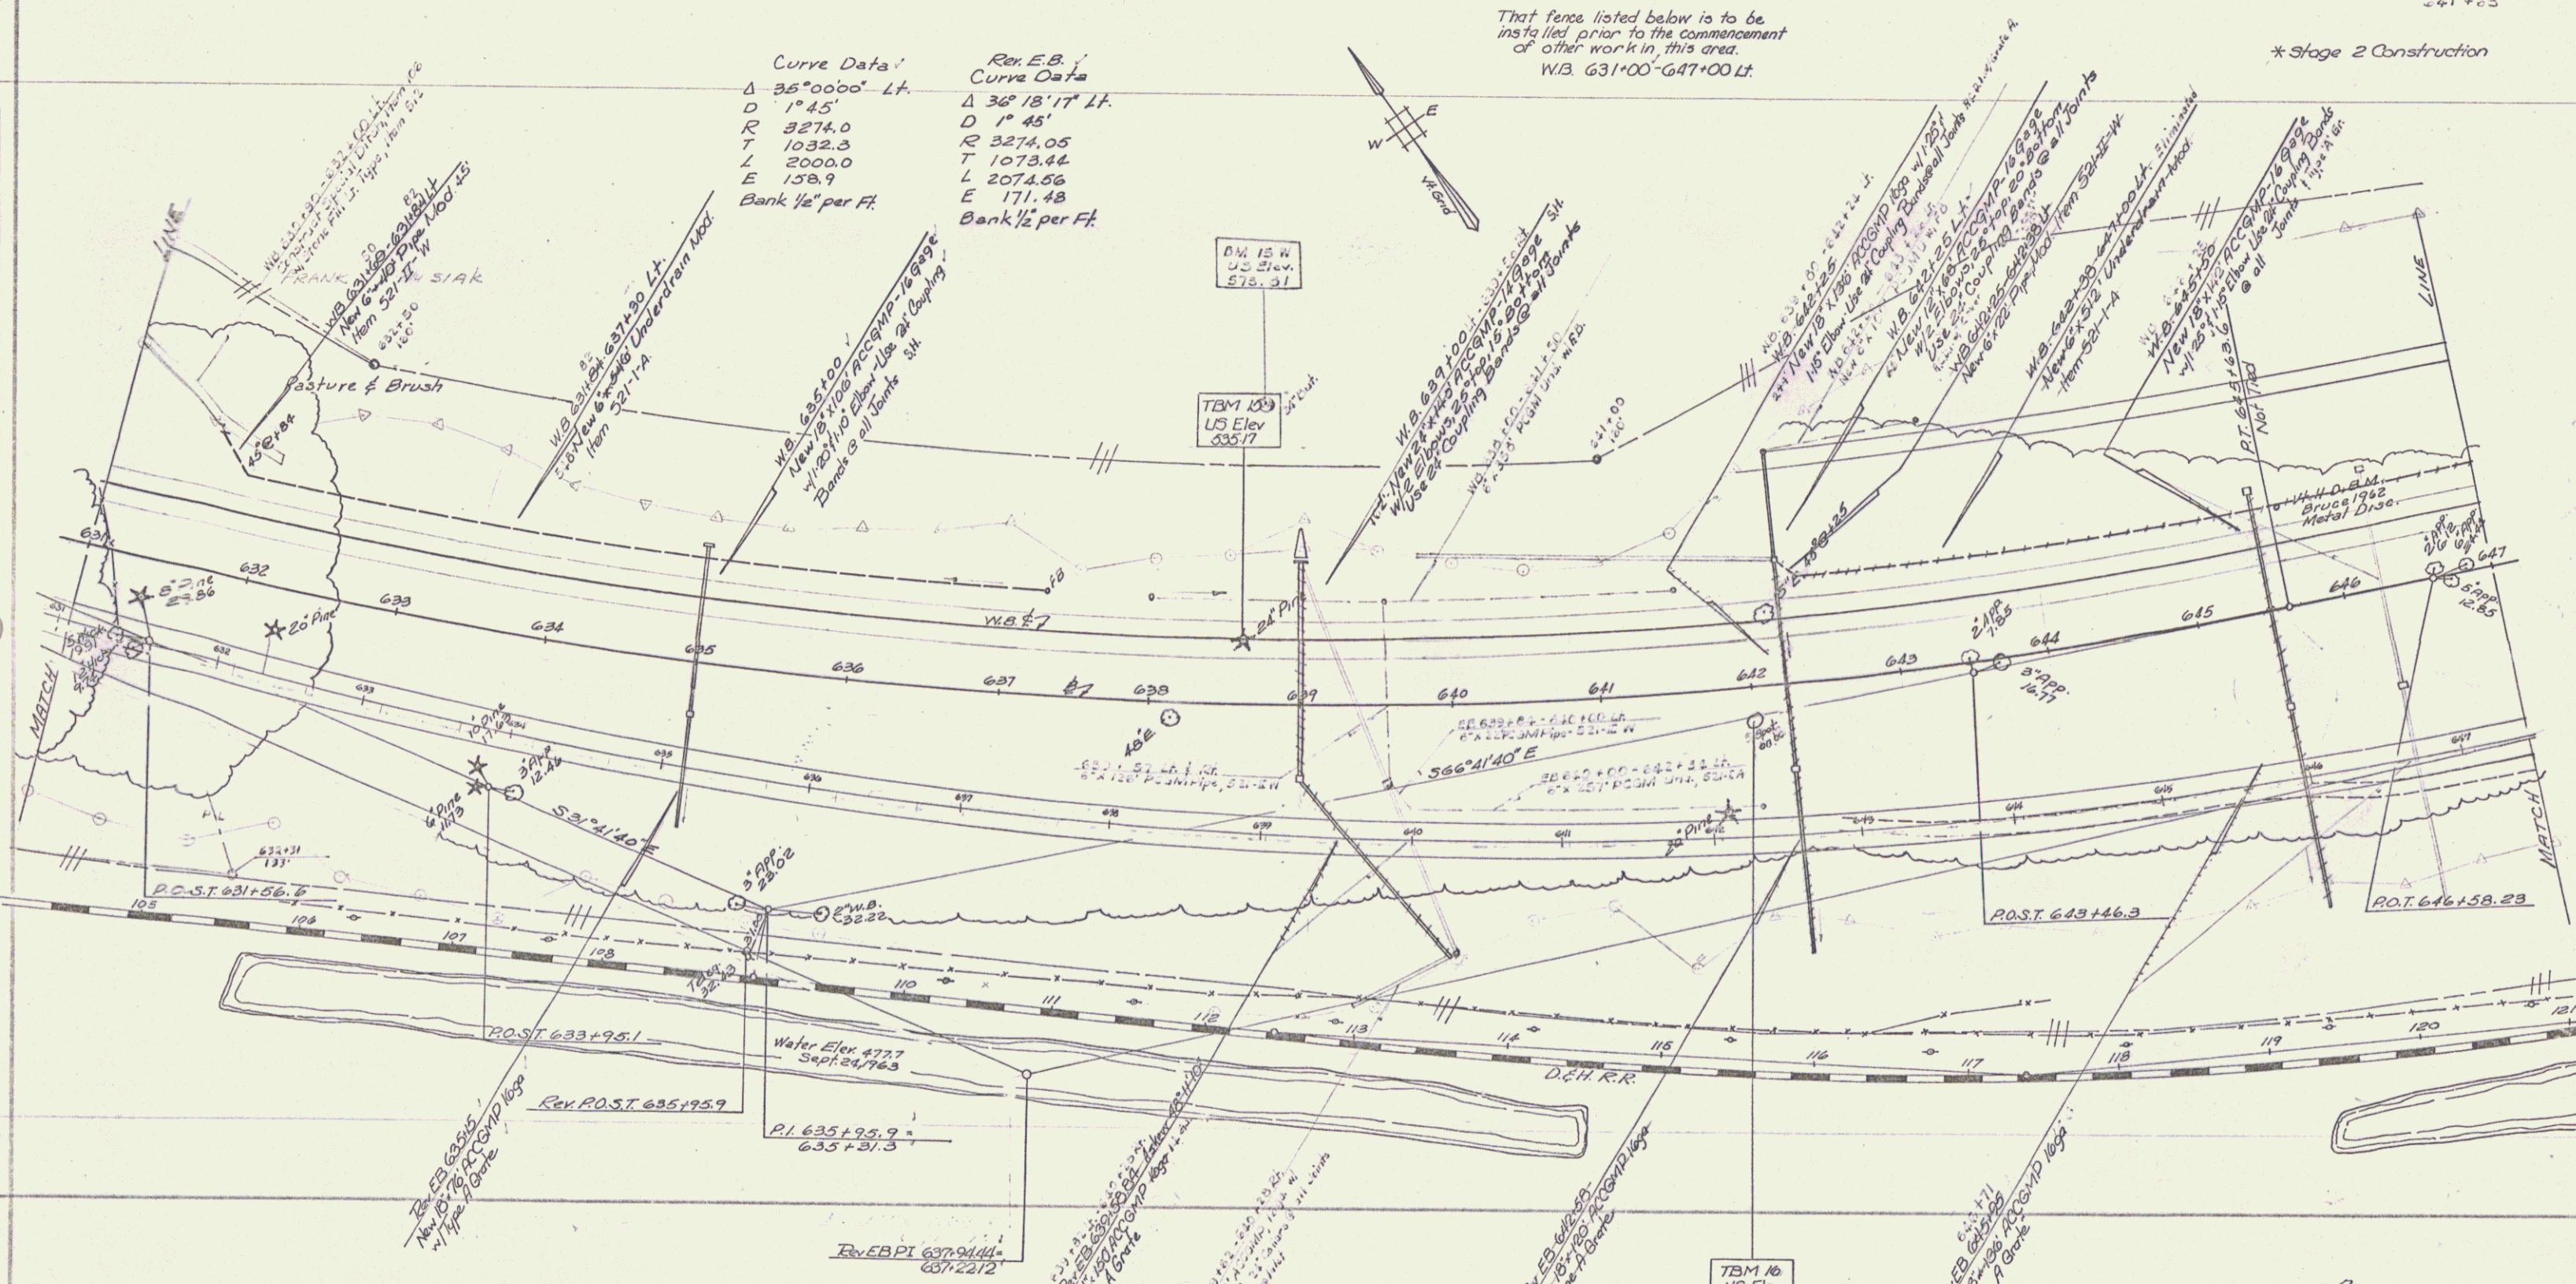

Stage 2 Construction
 WEST RUTLAND
 APO20-1 (11)
 Sheet 29 of 359 Sheets
 Sheet 88 of 170 Sheets